


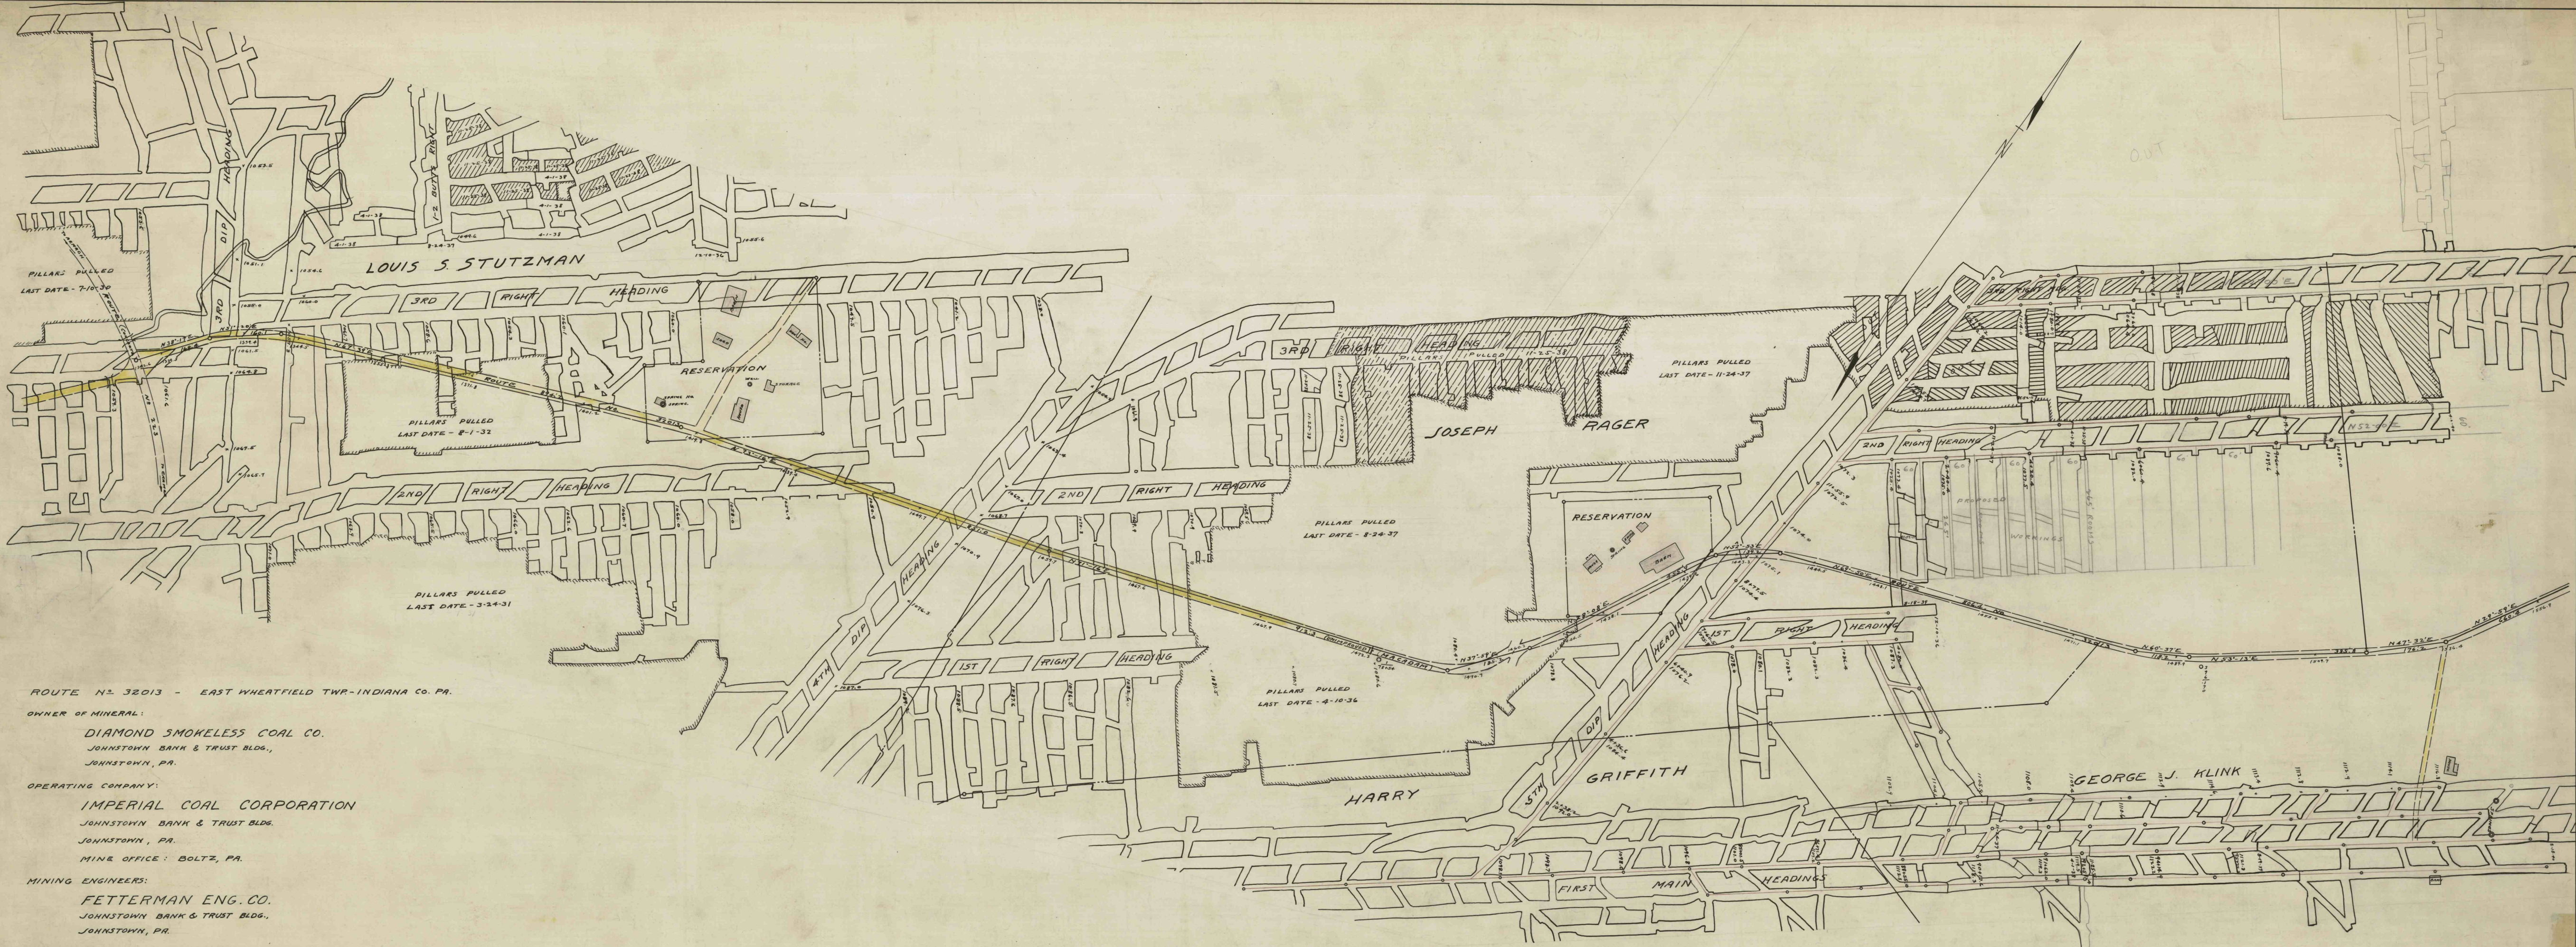

ROUTE N^o 32013 - EAST WHEATFIELD TWP-INDIANA CO. PA.

OWNER OF MINERAL:
DIAMOND SMOKELESS COAL CO.
JOHNSTOWN BANK & TRUST BLDG.,
JOHNSTOWN, PA.

OPERATING COMPANY:
IMPERIAL COAL CORPORATION
JOHNSTOWN BANK & TRUST BLDG.
JOHNSTOWN, PA.
MINE OFFICE: BOLTZ, PA.

MINING ENGINEERS:
FETTERMAN ENG. CO.
JOHNSTOWN BANK & TRUST BLDG.,
JOHNSTOWN, PA.

SCALE: - 1"=100'

MARKERS:
o ON TELEGRAPH POLE

UNIMPROVED ROADS - YELLOW
IMPROVED ROADS - RED