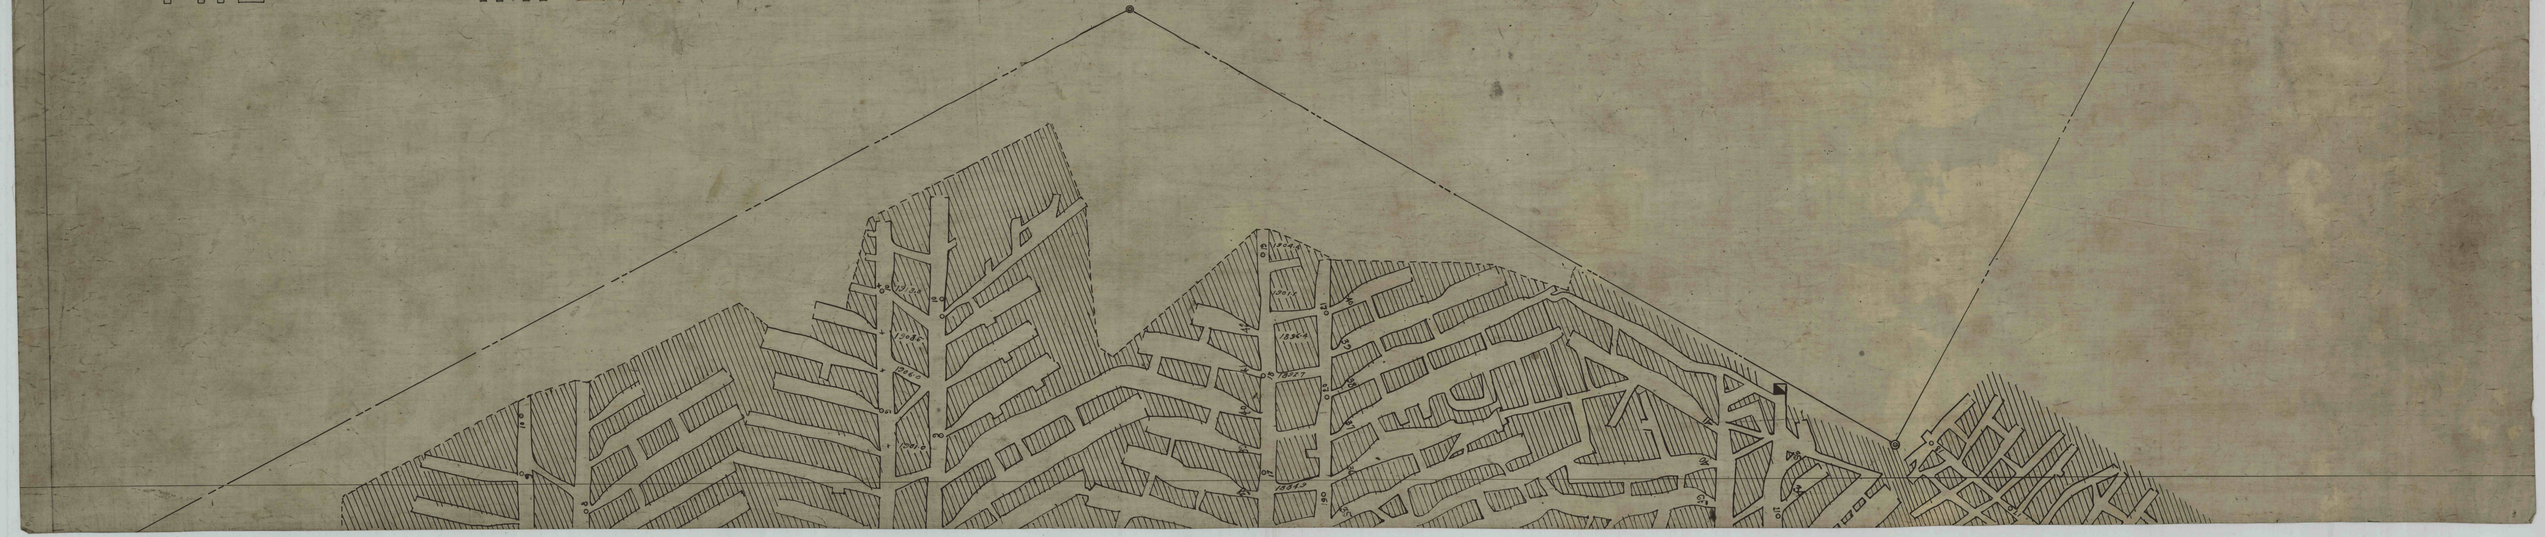THE IMPERIAL COAL M'N'G. CO.