


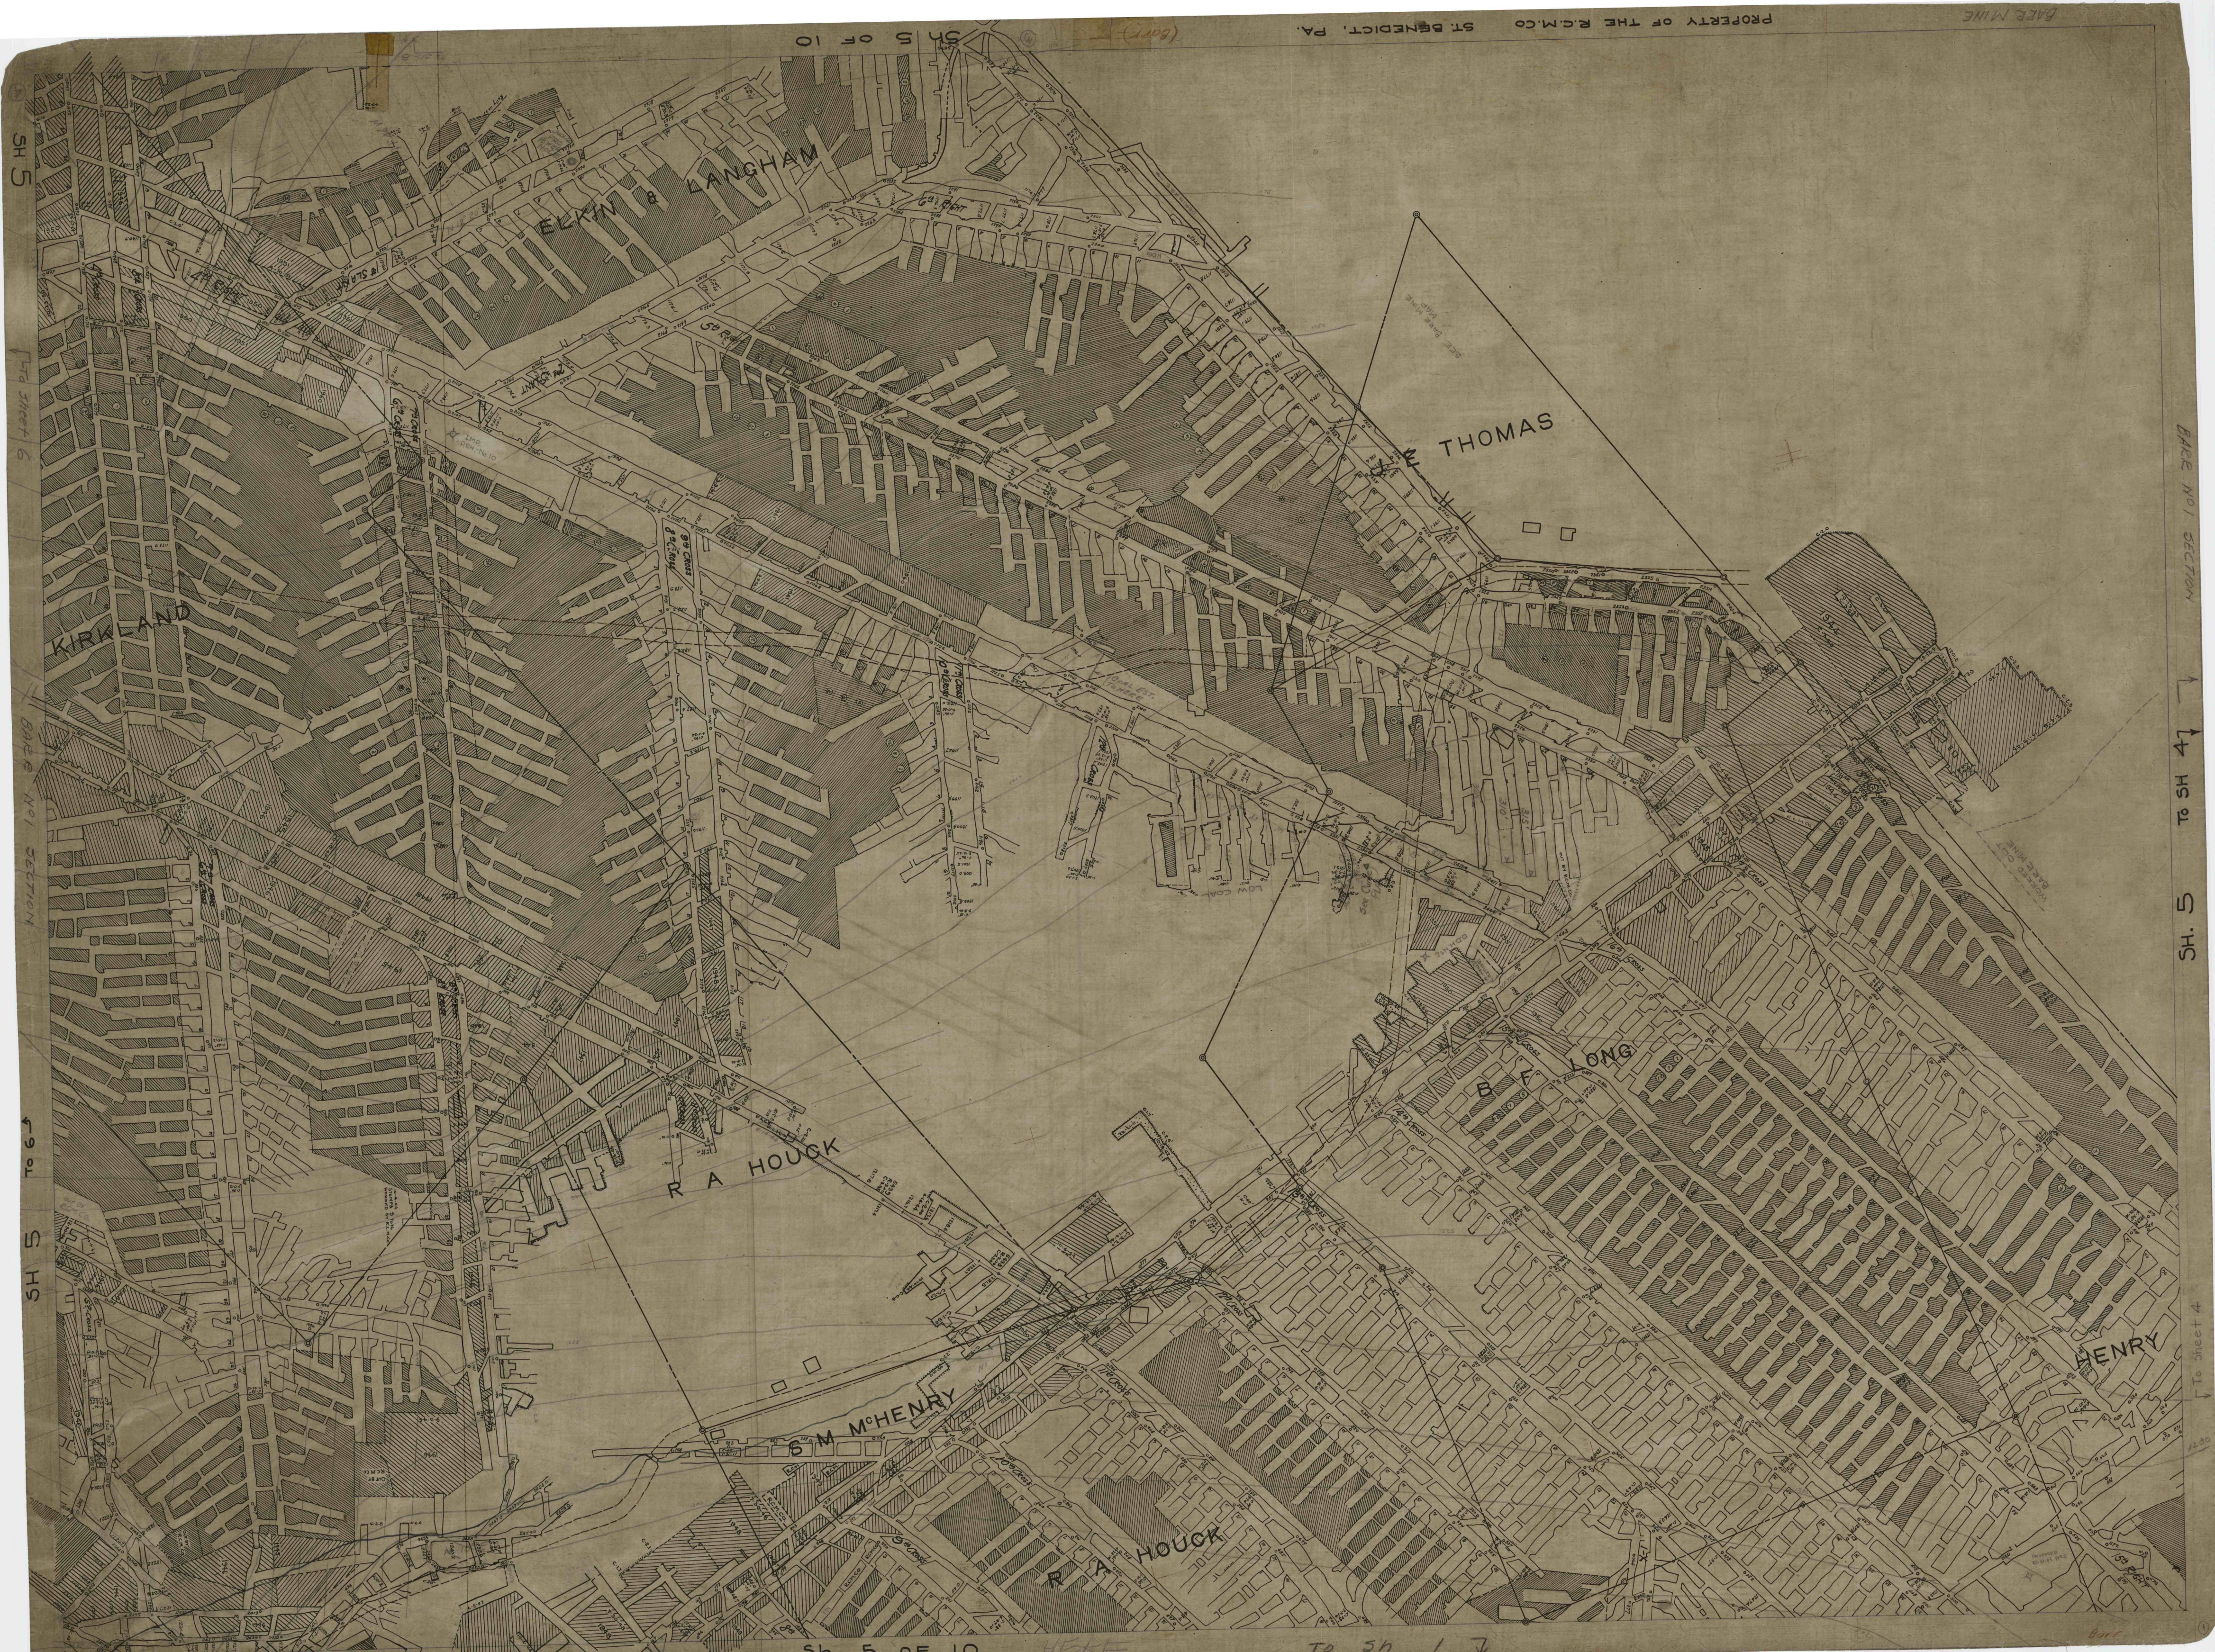

PROPERTY OF THE R.C.M.CO ST. BENEDICT, PA.

BARE MINE

BARE MINE SECTION

SH. 5 SH. 4

TO SHEET 4

SH 5

BARE MINE SECTION

SH 5

SH 5 OF 10

SH 5 OF 10

TO SH 1 3