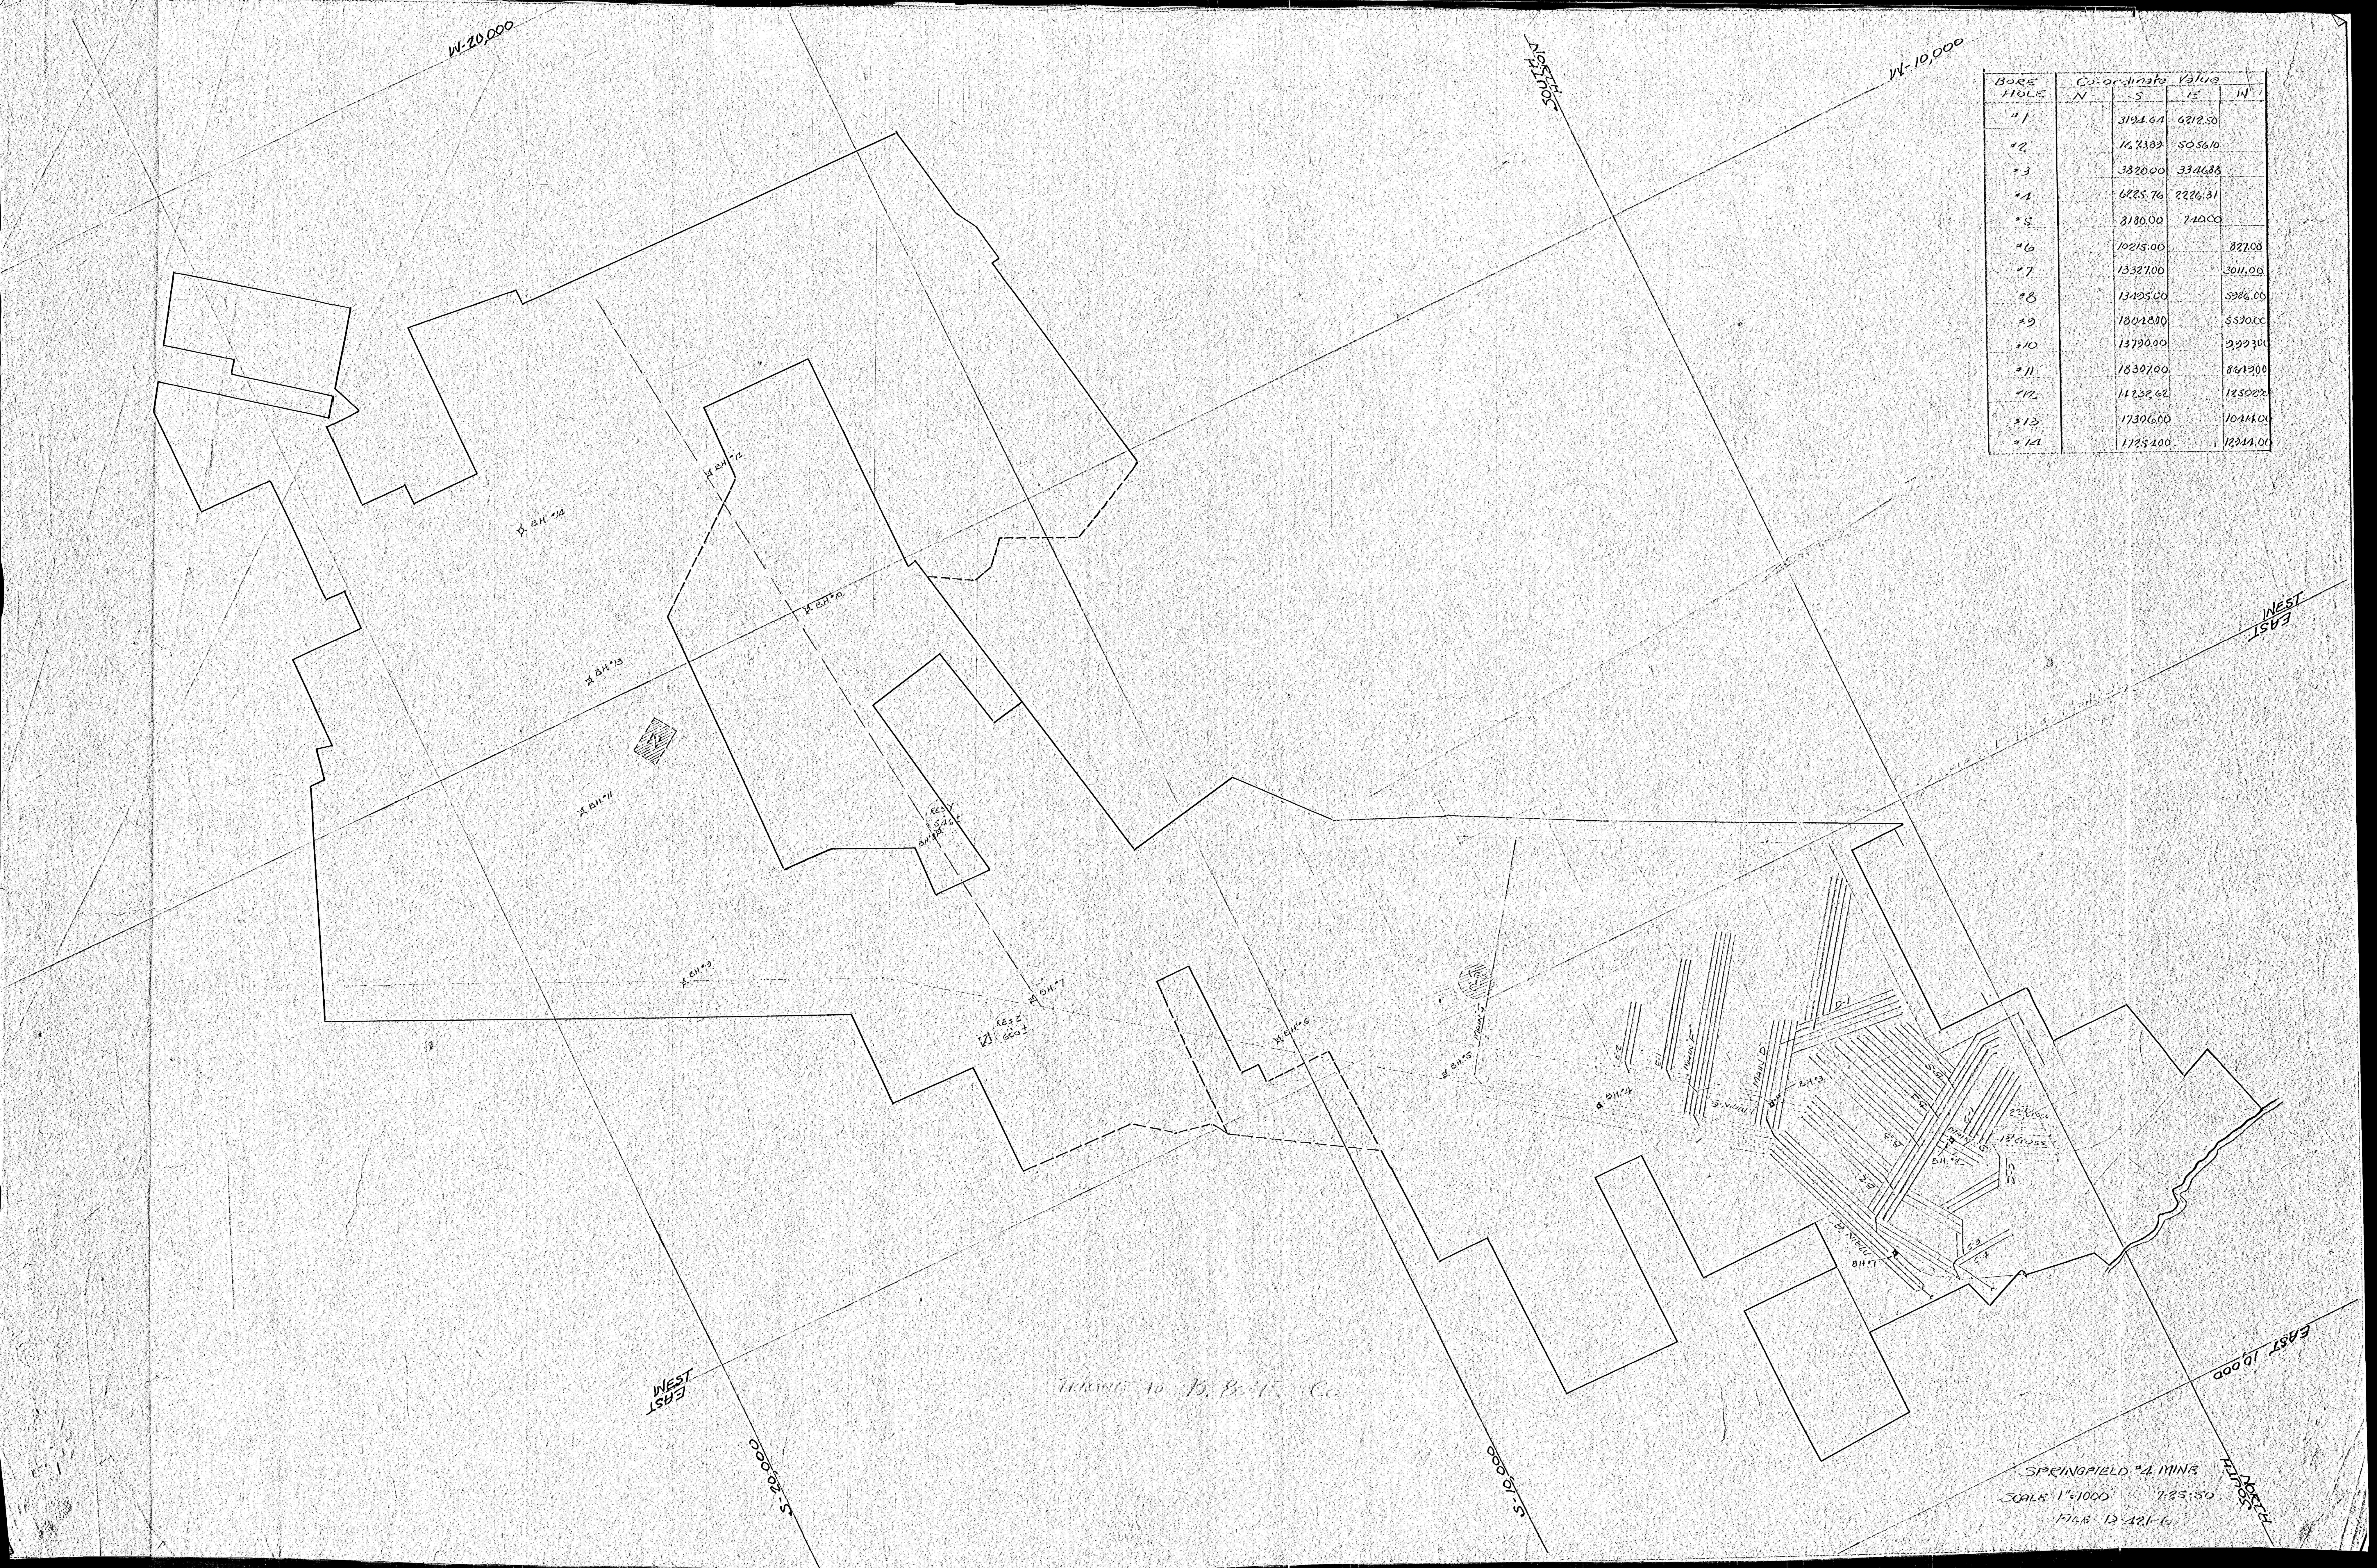

BORE HOLE	Co-ordinate Value N	S	E	W
#1		3194.64	6212.50	
#2		16,73.89	5056.10	
#3		3820.00	3346.88	
#4		6225.76	2226.31	
#5		8180.00	740.00	
#6		10215.00		822.00
#7		13327.00		3011.00
#8		13495.00		5986.00
#9		18048.00		5590.00
#10		13790.00		9993.00
#11		18307.00		8619.00
#12		14232.62		12502
#13		17306.00		10414.00
#14		17254.00		12944.00

SPRINGFIELD #4 MINE

SCALE 1" = 1000 7-25-50

FILE D-421-6