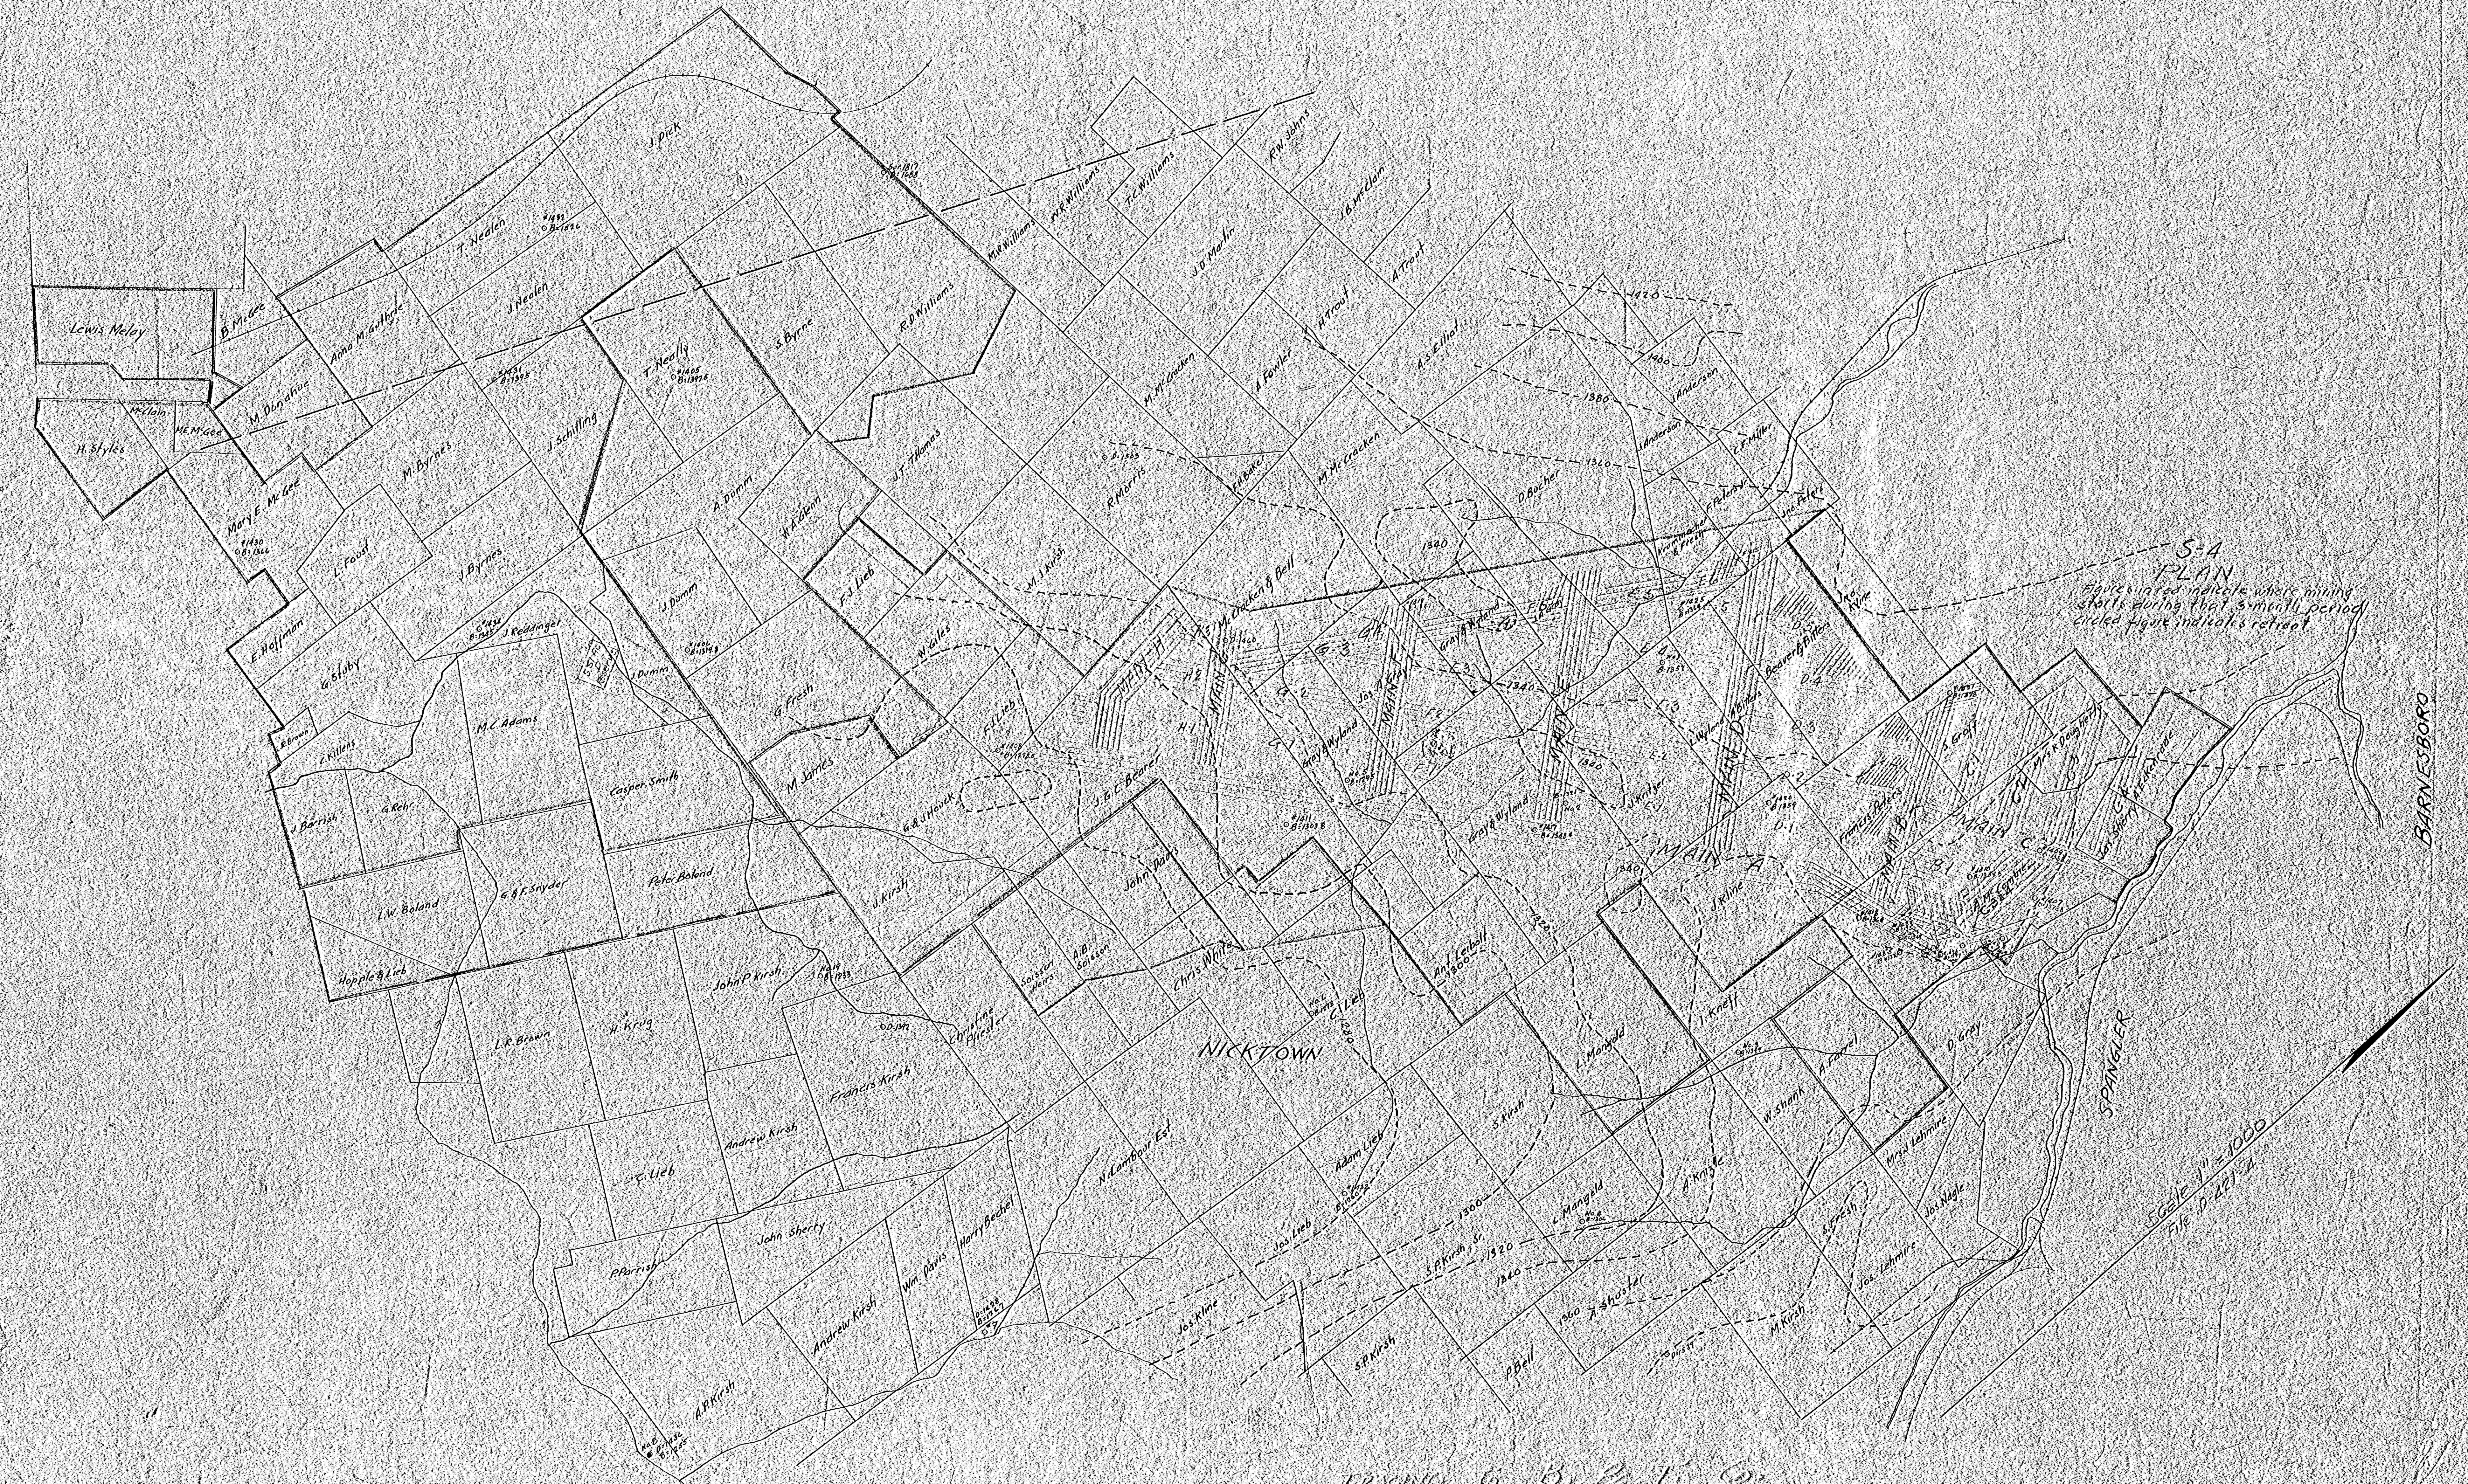
BARNESBORO
SPANGLER
NICKTOWN
Scale 1" = 1000
File D-421-4
MAIN A
MAIN B
MAIN C
MAIN D
MAIN H
Lewis Meloy
H. Styles
McClain
M.E. McGee
B. McGee
M. Donahoe
Anna M. Guthrie
Mary E. McGee
T. Neolen
J. Neolen
M. Byrnes
J. Byrnes
L. Foust
J. Schilling
E. Hoffman
G. Stoby
J. Reddinger
R. Brown
C. Killens
J. Barrish
G. Rehr
L.W. Boland
G.&F. Snyder
Hopple & Lieb
M.C. Adams
Casper Smith
Peter Boland
L.R. Brown
H. Krug
John P. Kirsh
T. Lieb
Andrew Kirsh
Francis Kirsh
Christina Pfeifer
P. Parrish
John Sherry
Harry Bechel
Wm. Davis
A.P. Kirsh
J. Pick
T. Neally
S. Byrne
R.D. Williams
J.T. Thomas
A. Damm
J. Damm
W. Adam
F.J. Lieb
G. Fresh
M. James
W. Giles
M.J. Kirsh
J. Kirsh
G.&J. Houck
J.&C. Beaver
John Davis
Soisson Heirs
A.B. Soisson
Chris White
C. Lieb
N. Lambour Est.
Adam Lieb
Jos. Lieb
Jos. Kline
S.P. Kirsh
P. Bell
S. Kirsh
S.P. Kirsh Sr.
A. Shuster
L. Mangold
A. Knigle
M. Kirsh
Jos. Lehmire
S. Fresh
Jos. Nagle
Mrs. J. Lehmire
W. Shank
A. Lorell
D. Gray
J. Kneff
J. Kline
And. Leiboll
Gray & Wyland
J.C. McCracken & Bell
J. Krieger
L. Wyland & Bihler
Beaver & Bihler
Francis Peters
C. Graff
Mrs. K. Dougherty
C. Dougherty
J. Ackenrode
Jno. Peters
F. Peters
Krumenacker & Fresh
C.F. Miller
J. Anderson
D. Boecher
M. McCracken
F. Baker
R. Morris
M. McCracken
A. Fowler
A.S. Elliot
H. Trout
A. Trout
J.D. Martin
J.B. McClain
R.W. Johns
T.C. Williams
W.R. Williams
M.W. Williams
TRACING to B. & T. Co.

S-4
PLAN

Figures in red indicate where mining starts during that 5-month period
circled figure indicates retreat