


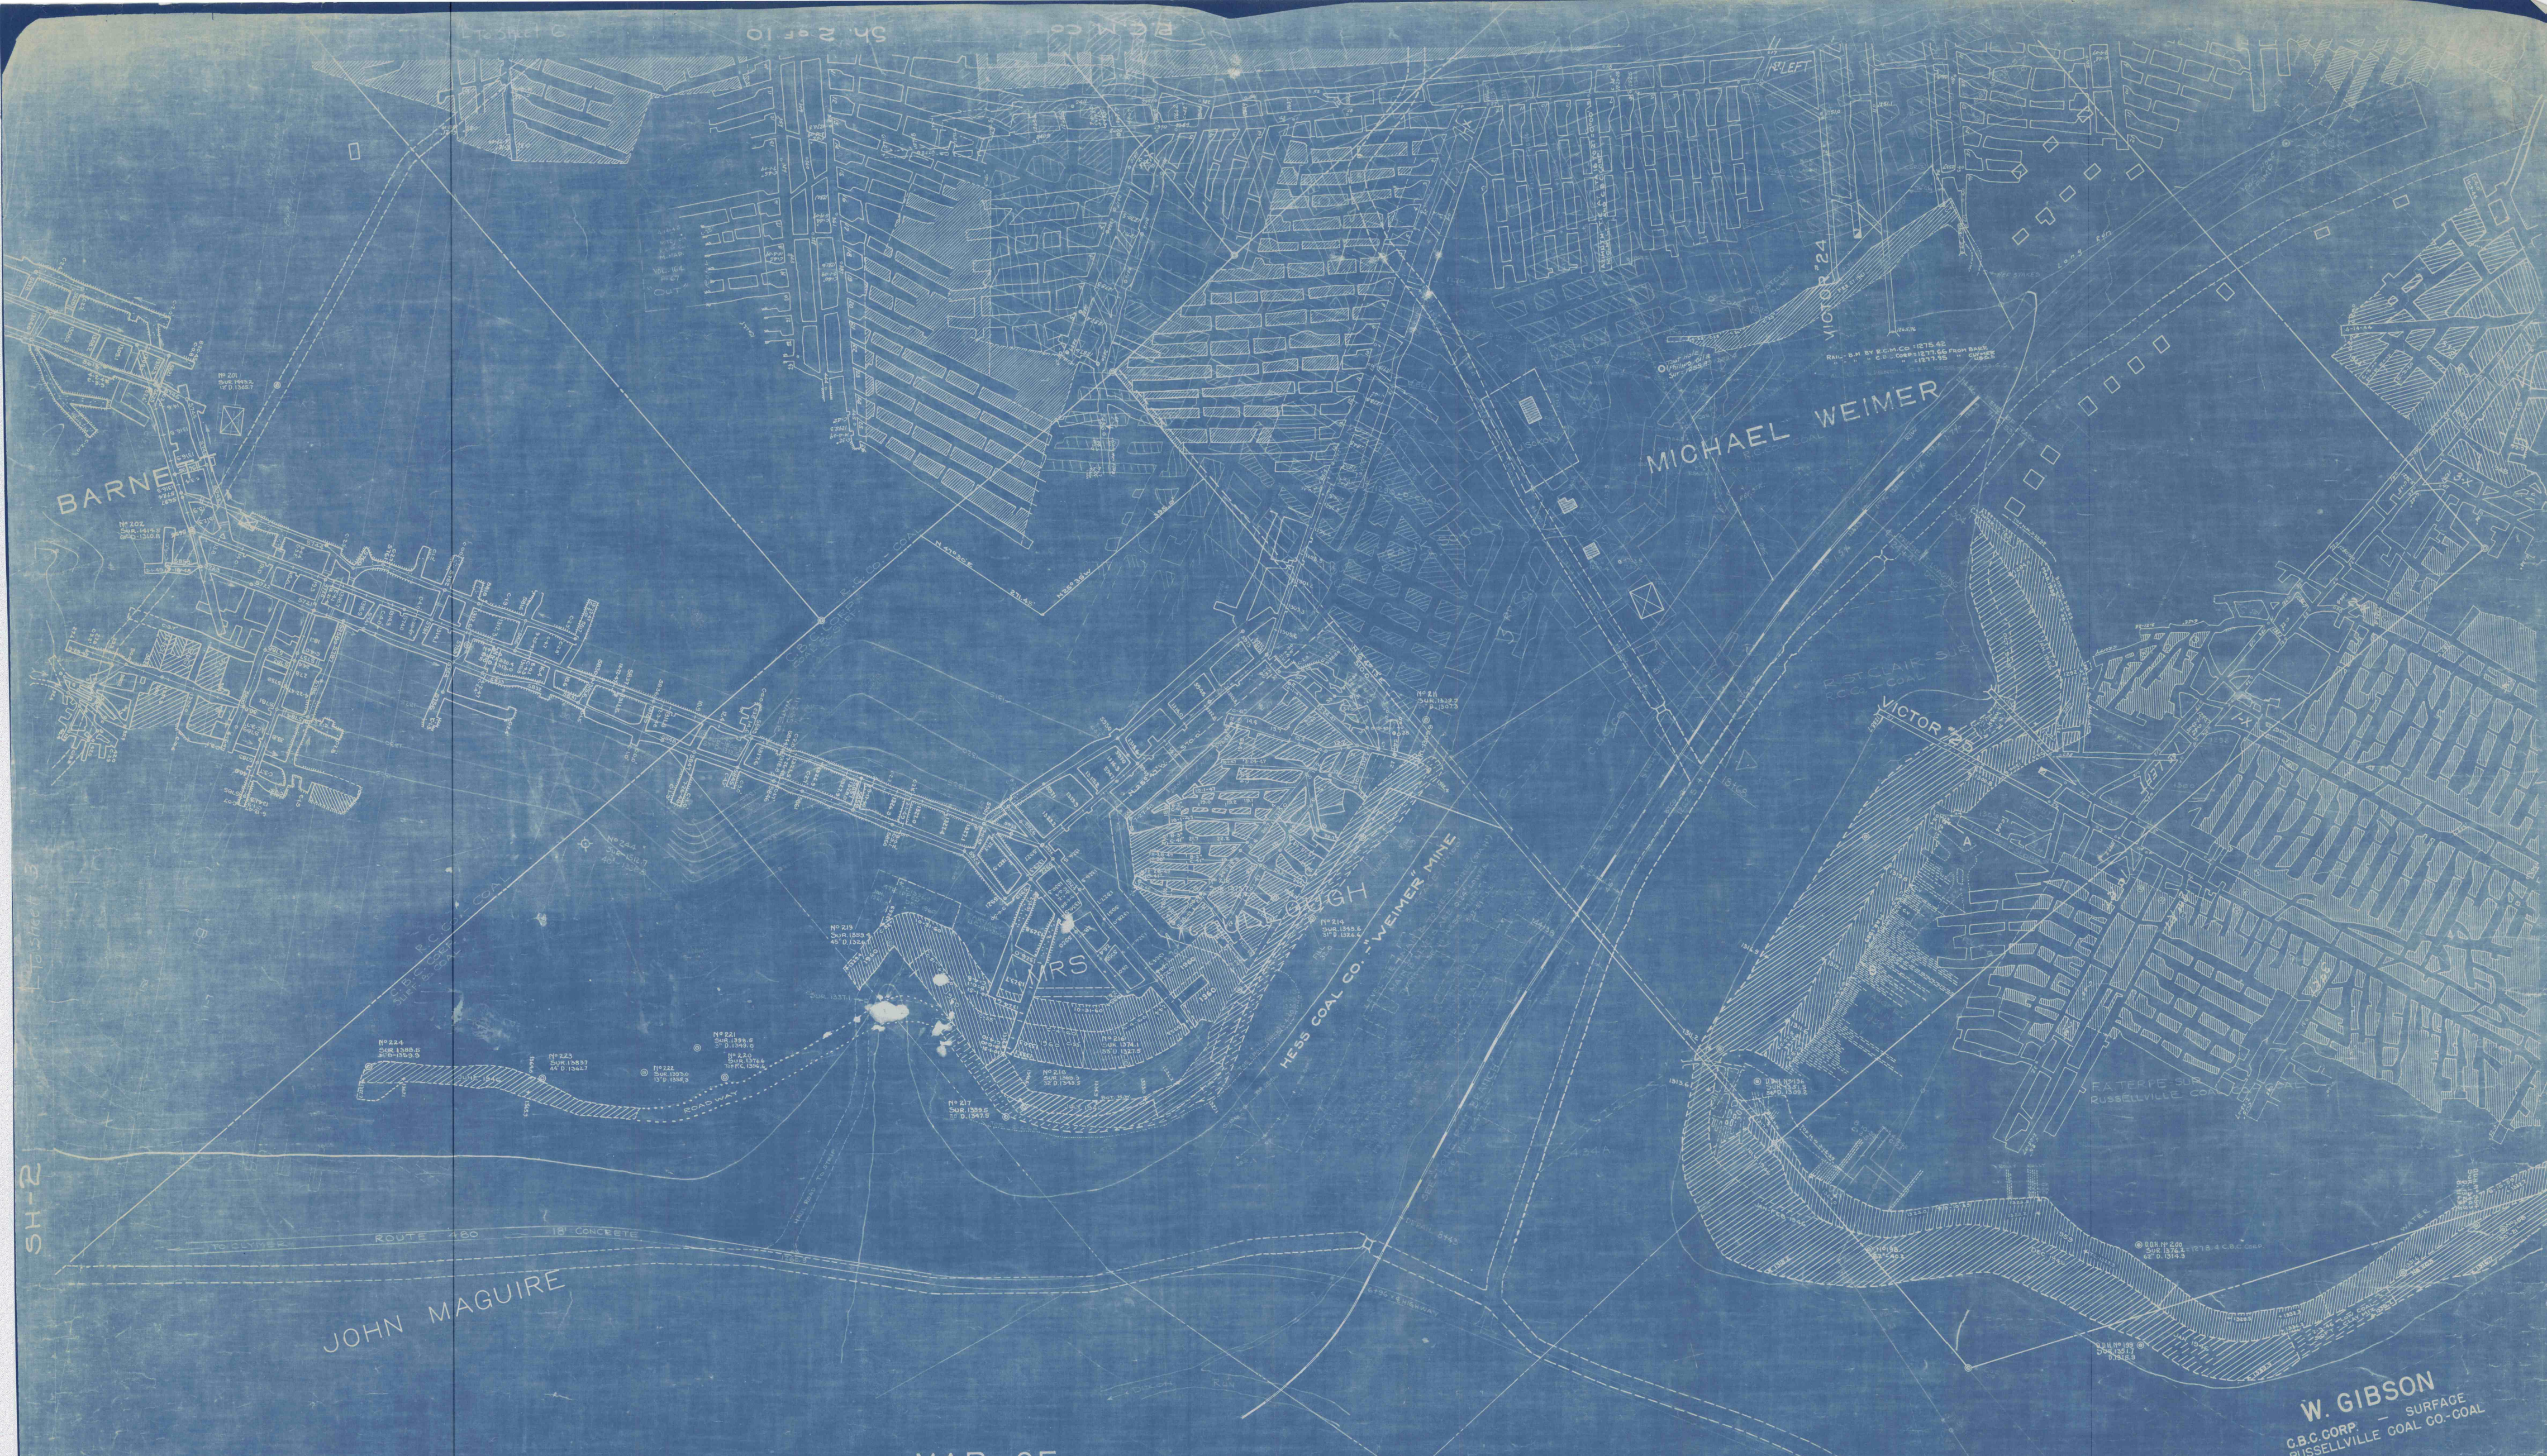

MAP OF
VICTOR 24 & 25 MINE
RUSSELL COAL MINING CO.
CLYMER, INDIANA CO., PA.
SCALE - 1 IN. = 100 FT.

REVISED APRIL 13, 1940 (SURFACE STRIP)
REVISED JUNE 6, 1950 (MINE STRIP)
COR. 31,102.0 (MINE STRIP)

W. GIBSON
C.B.C. CORP. - SURFACE
RUSSELLVILLE COAL CO. - COAL