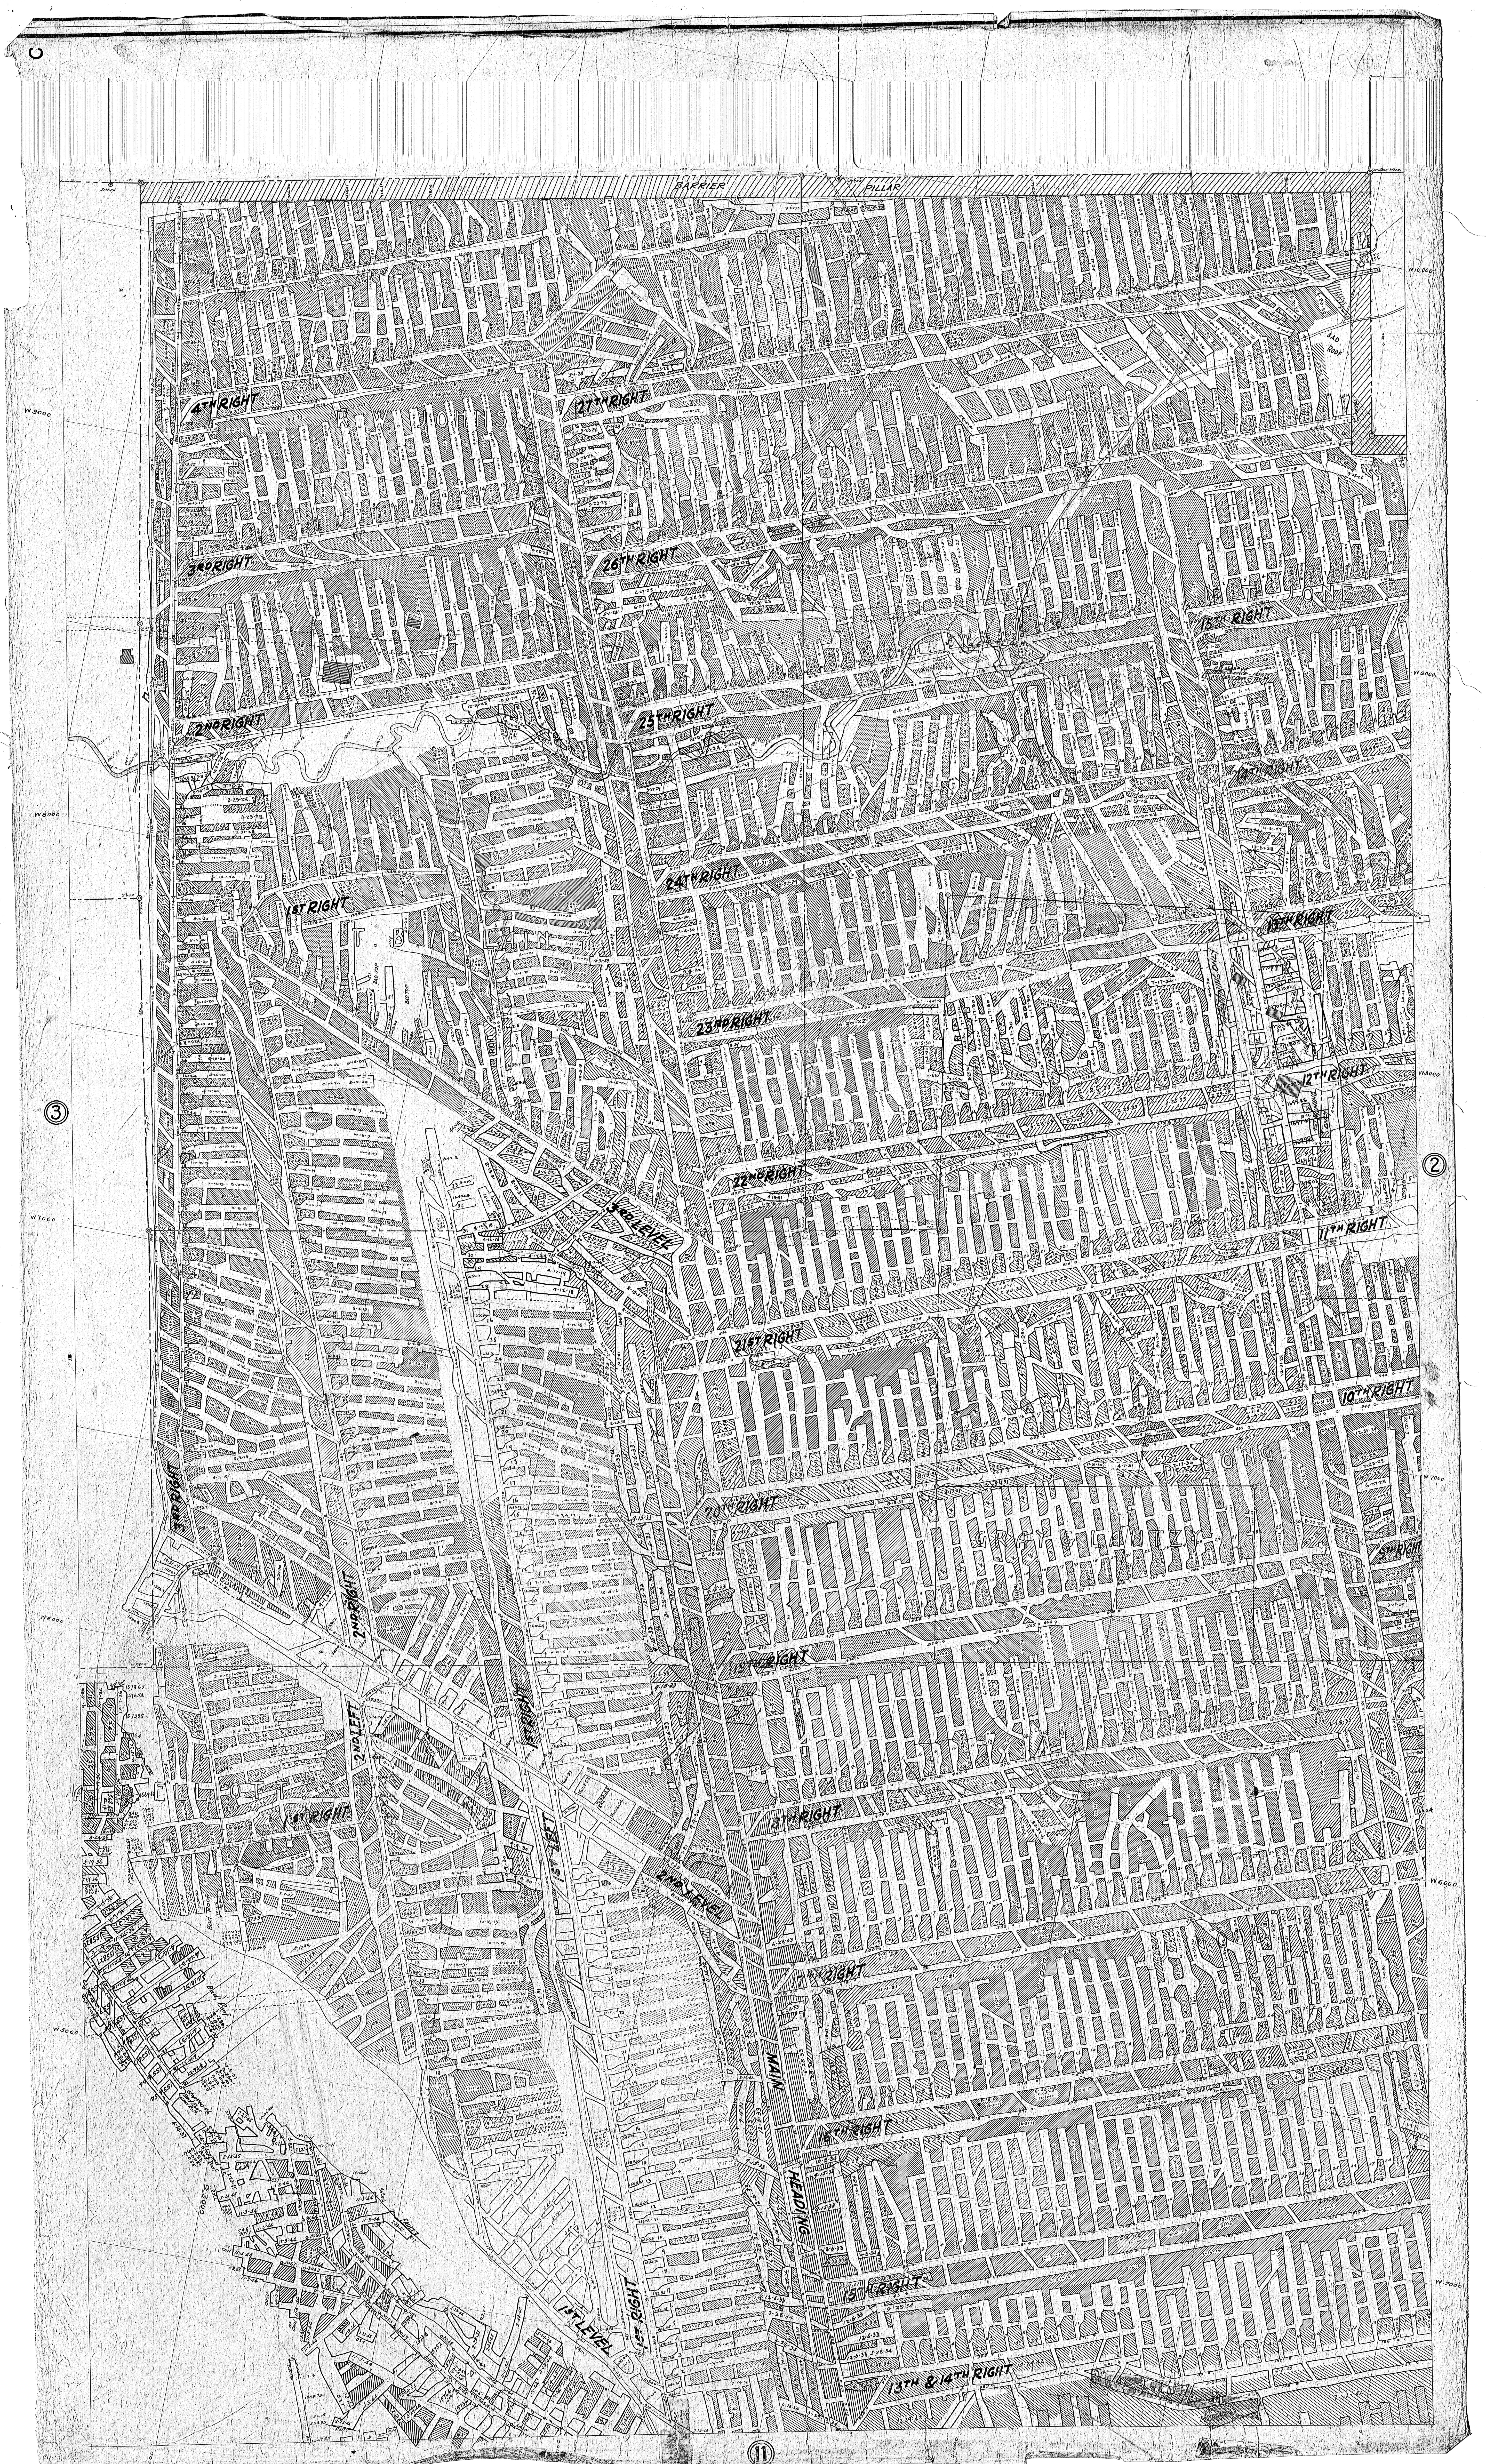C
BARRIER PILLAR
BAD ROOF
4TH RIGHT
27TH RIGHT
3RD RIGHT
26TH RIGHT
15TH RIGHT
2ND RIGHT
25TH RIGHT
14TH RIGHT
1ST RIGHT
24TH RIGHT
13TH RIGHT
23RD RIGHT
12TH RIGHT
3RD LEVEL
22ND RIGHT
11TH RIGHT
21ST RIGHT
10TH RIGHT
3RD RIGHT
20TH RIGHT
9TH RIGHT
2ND RIGHT
19TH RIGHT
2ND LEFT
1ST RIGHT
1ST LEFT
1ST RIGHT
18TH RIGHT
2ND LEVEL
17TH RIGHT
MAIN HEADING
16TH RIGHT
15TH RIGHT
1ST LEVEL
1ST RIGHT
13TH & 14TH RIGHT
JONES
ELLIOTT
W 9000
W 8000
W 7000
W 6000
③
②
⑪