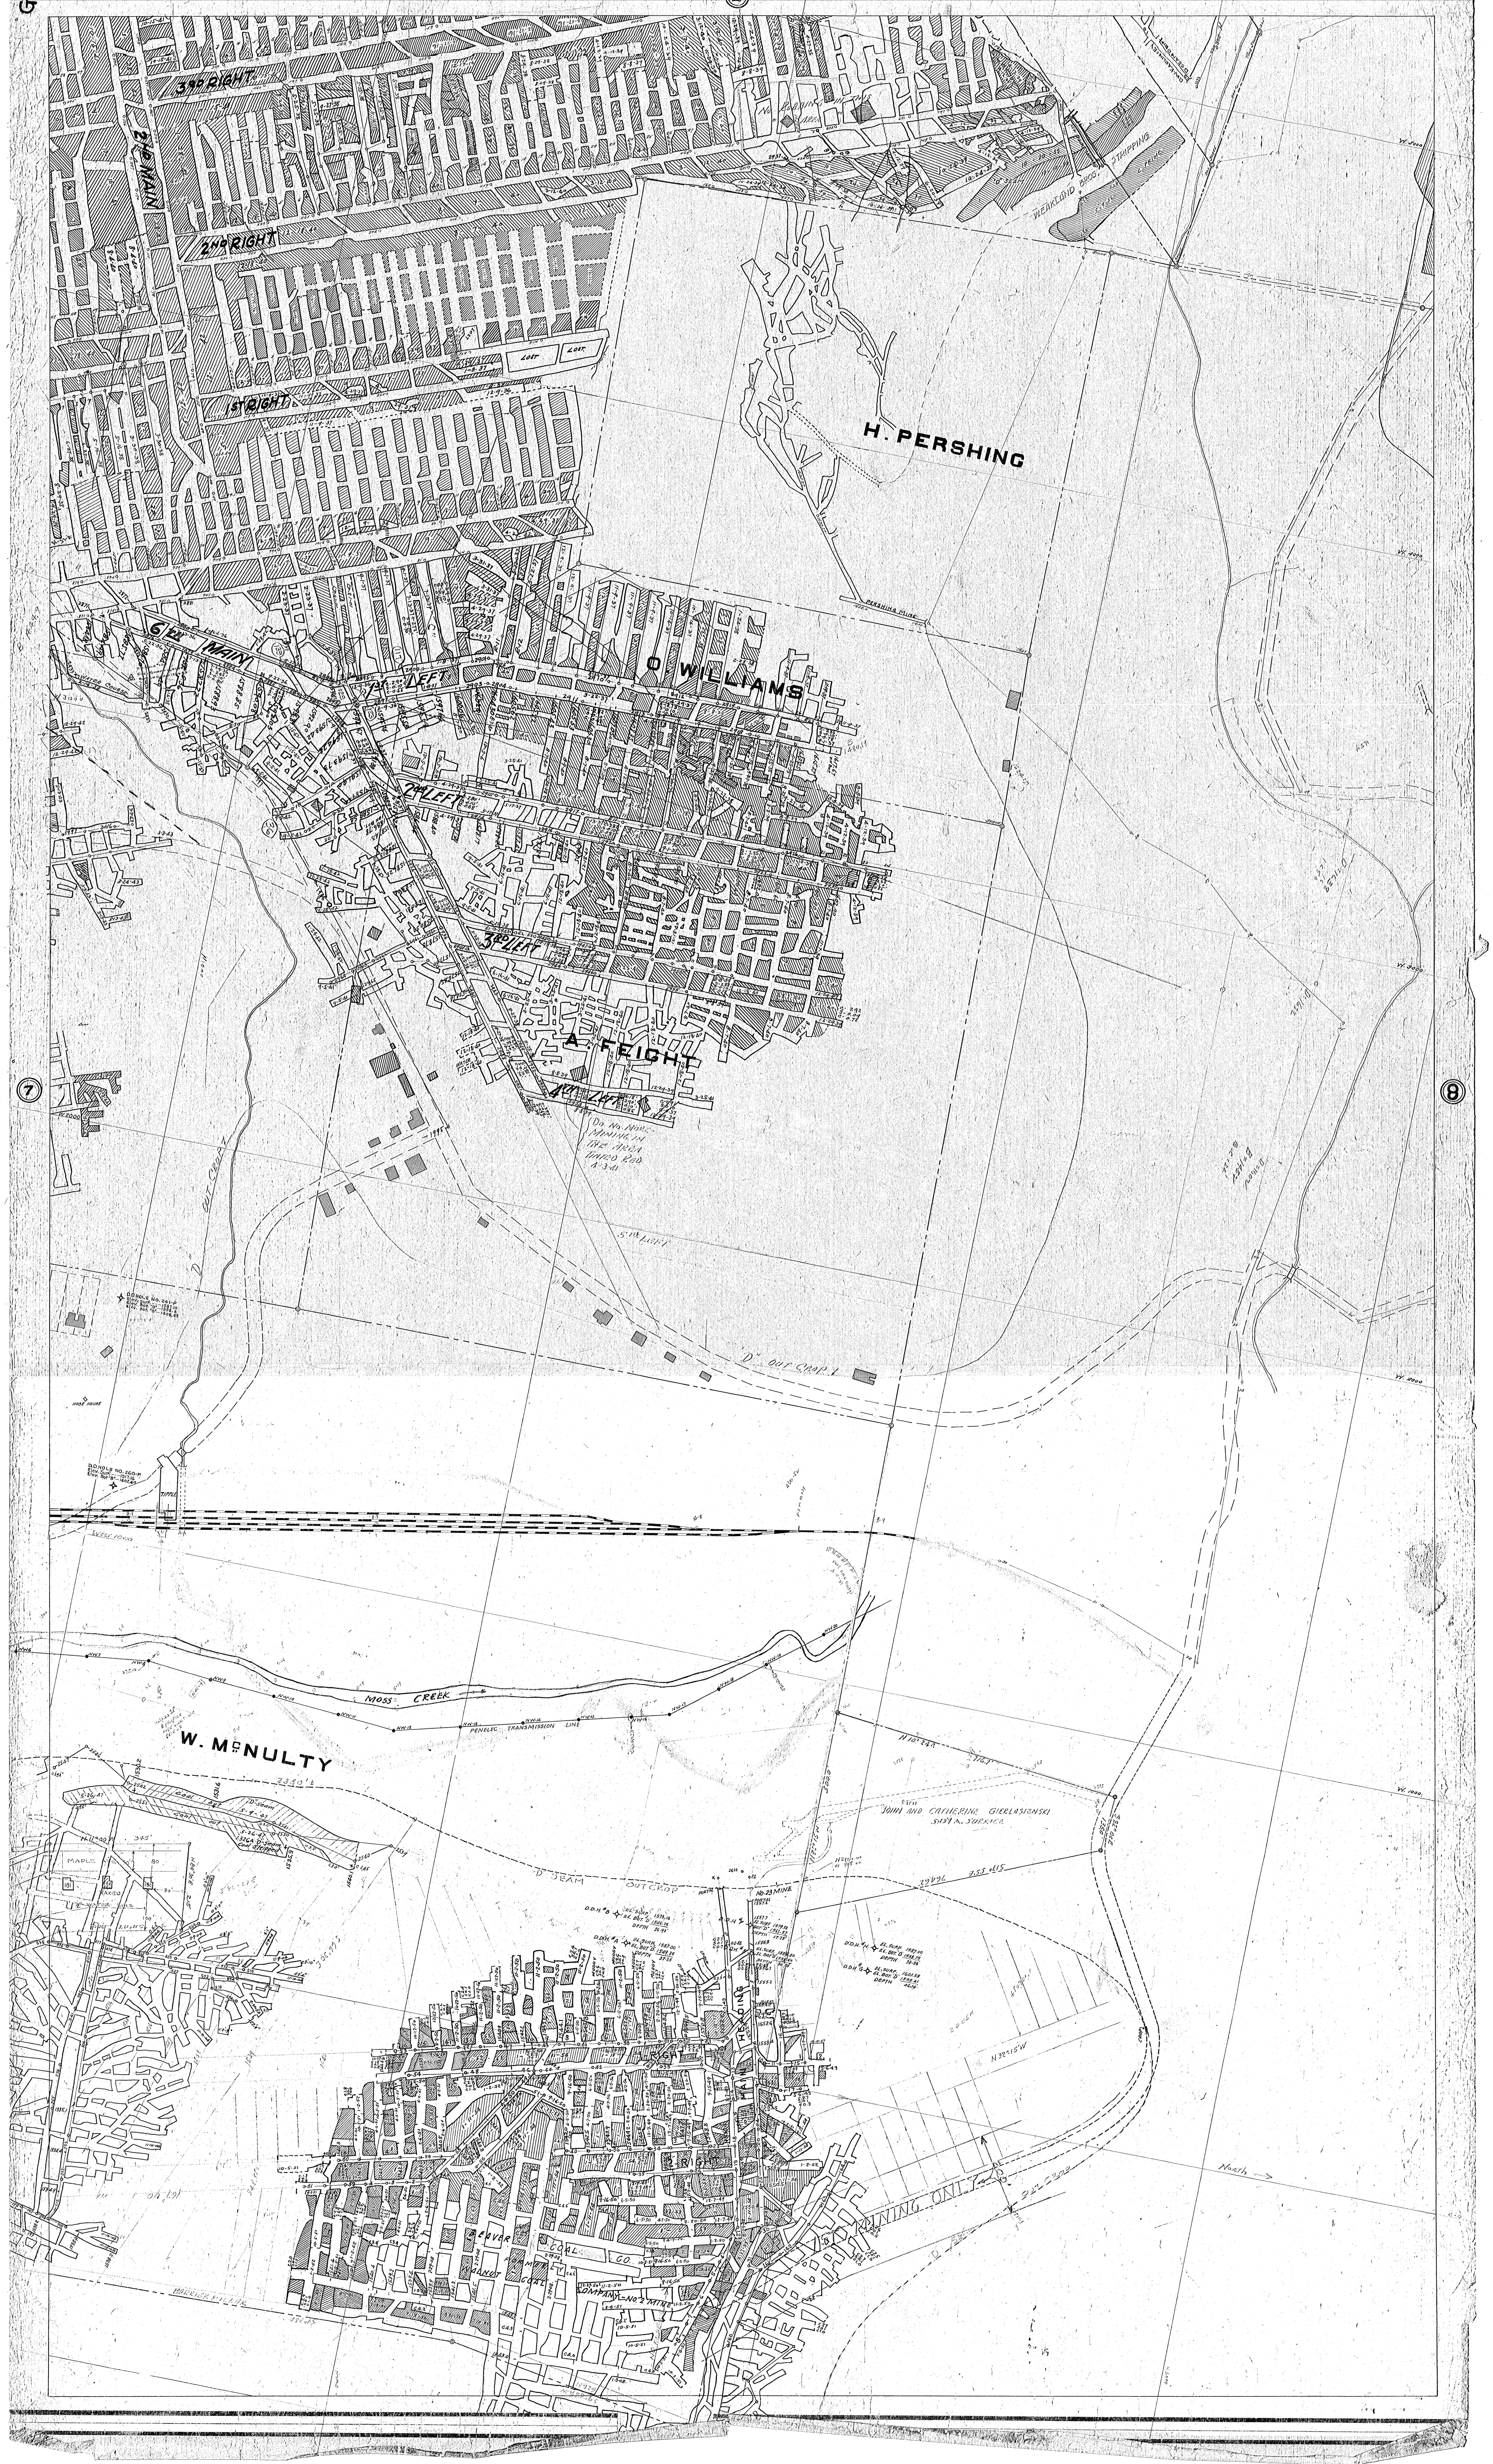

G
3RD RIGHT
2ND MAIN
2ND RIGHT
1ST RIGHT
H. PERSHING
PERSHING PLINE
O. WILLIAMS
6TH MAIN
1ST LEFT
2ND LEFT
3RD LEFT
A. FEIGHT
4TH LEFT
Do No More Mining In The Area Tinted Red 4-3-41
5TH LEFT
"D" OUT CROP
7
8
MOSS CREEK
PENELEC TRANSMISSION LINE
W. McNULTY
JOHN AND CATHERINE GIERLASIENSKI
5.151 A. SURFACE
N 10° 24 E 716.1'
500.0'
S 11° 55' E 764.62'
1350'
"D" SEAM OUTCROP
NO. 23 MINE
PORTAL 1557.2
D.D.H. #H EL. SURF. 1587.00 EL. BOT. "D" 1555.75 DEPTH 31.25
D.D.H. #G EL. SURF. 1601.55 EL. BOT. "D" 1555.41 DEPTH 46.14
BEAVER COAL CO. FORMERLY WALNUT COAL COMPANY NO. 2 MINE
MINING ONLY
North →