


DISCLAIMER: This map is provided as a courtesy to the Pennsylvania Bureau of Deep Mine Safety by American Premier Underwriters, Inc. (the "Premier Corporation") and is not to be used for any purpose other than the one for which it was intended. The Premier Corporation does not warrant, represent, or agree that the map is accurate, complete, or reliable, and it is not to be used for any purpose other than the one for which it was intended. The Premier Corporation does not assume any liability for any damage or loss arising from its use.

DANIEL GRAY
W. D. BIGLER & CO. - COAL

JOS. LEHMIRE
GEO. H. ASHMAN - COAL

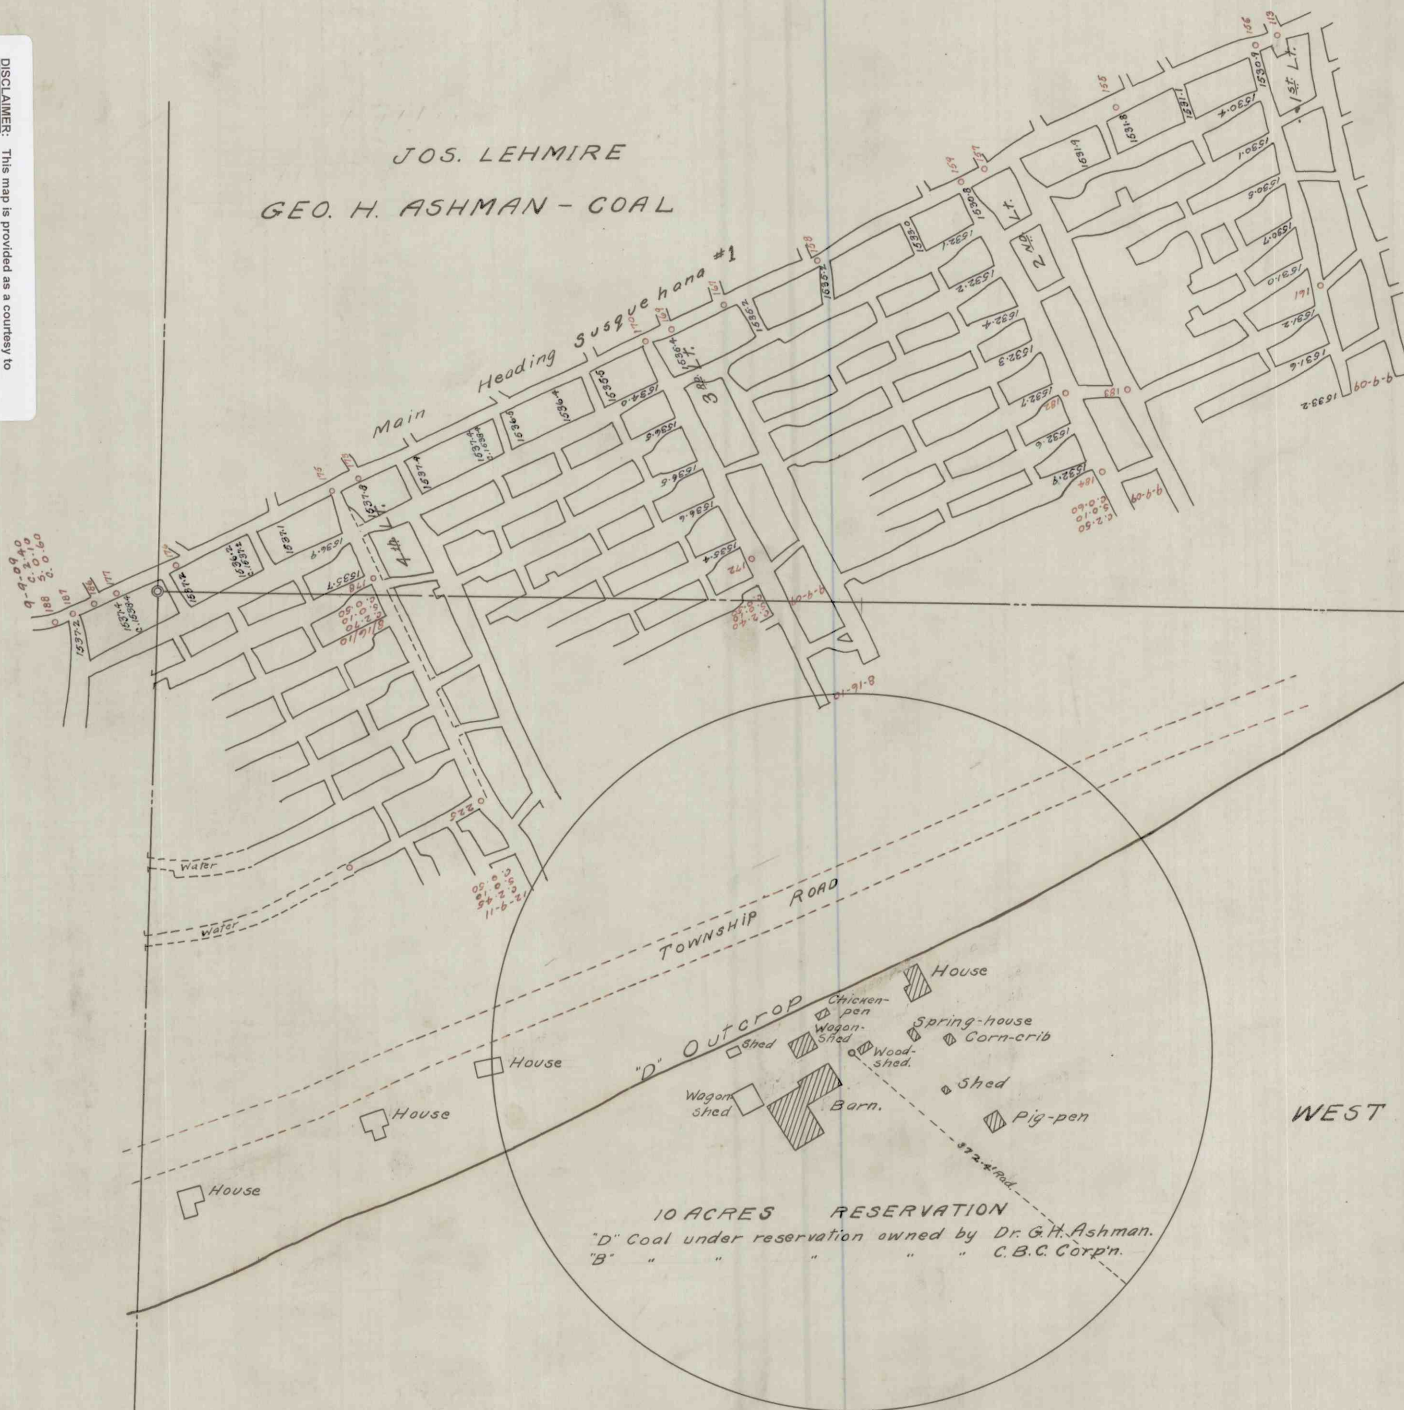

ARCHIE FARRELL
WEST BRANCH COAL CO. - COAL

Map Showing
PROPERTY OF
WEST BRANCH COAL CO.
LOWER FREEPORT OR "D" SEAM
LEASED TO
WOODLAND C. & C. CO
BARR TWP. - CAM. CO., PA.
Scale 1"=100' Dec.-1911