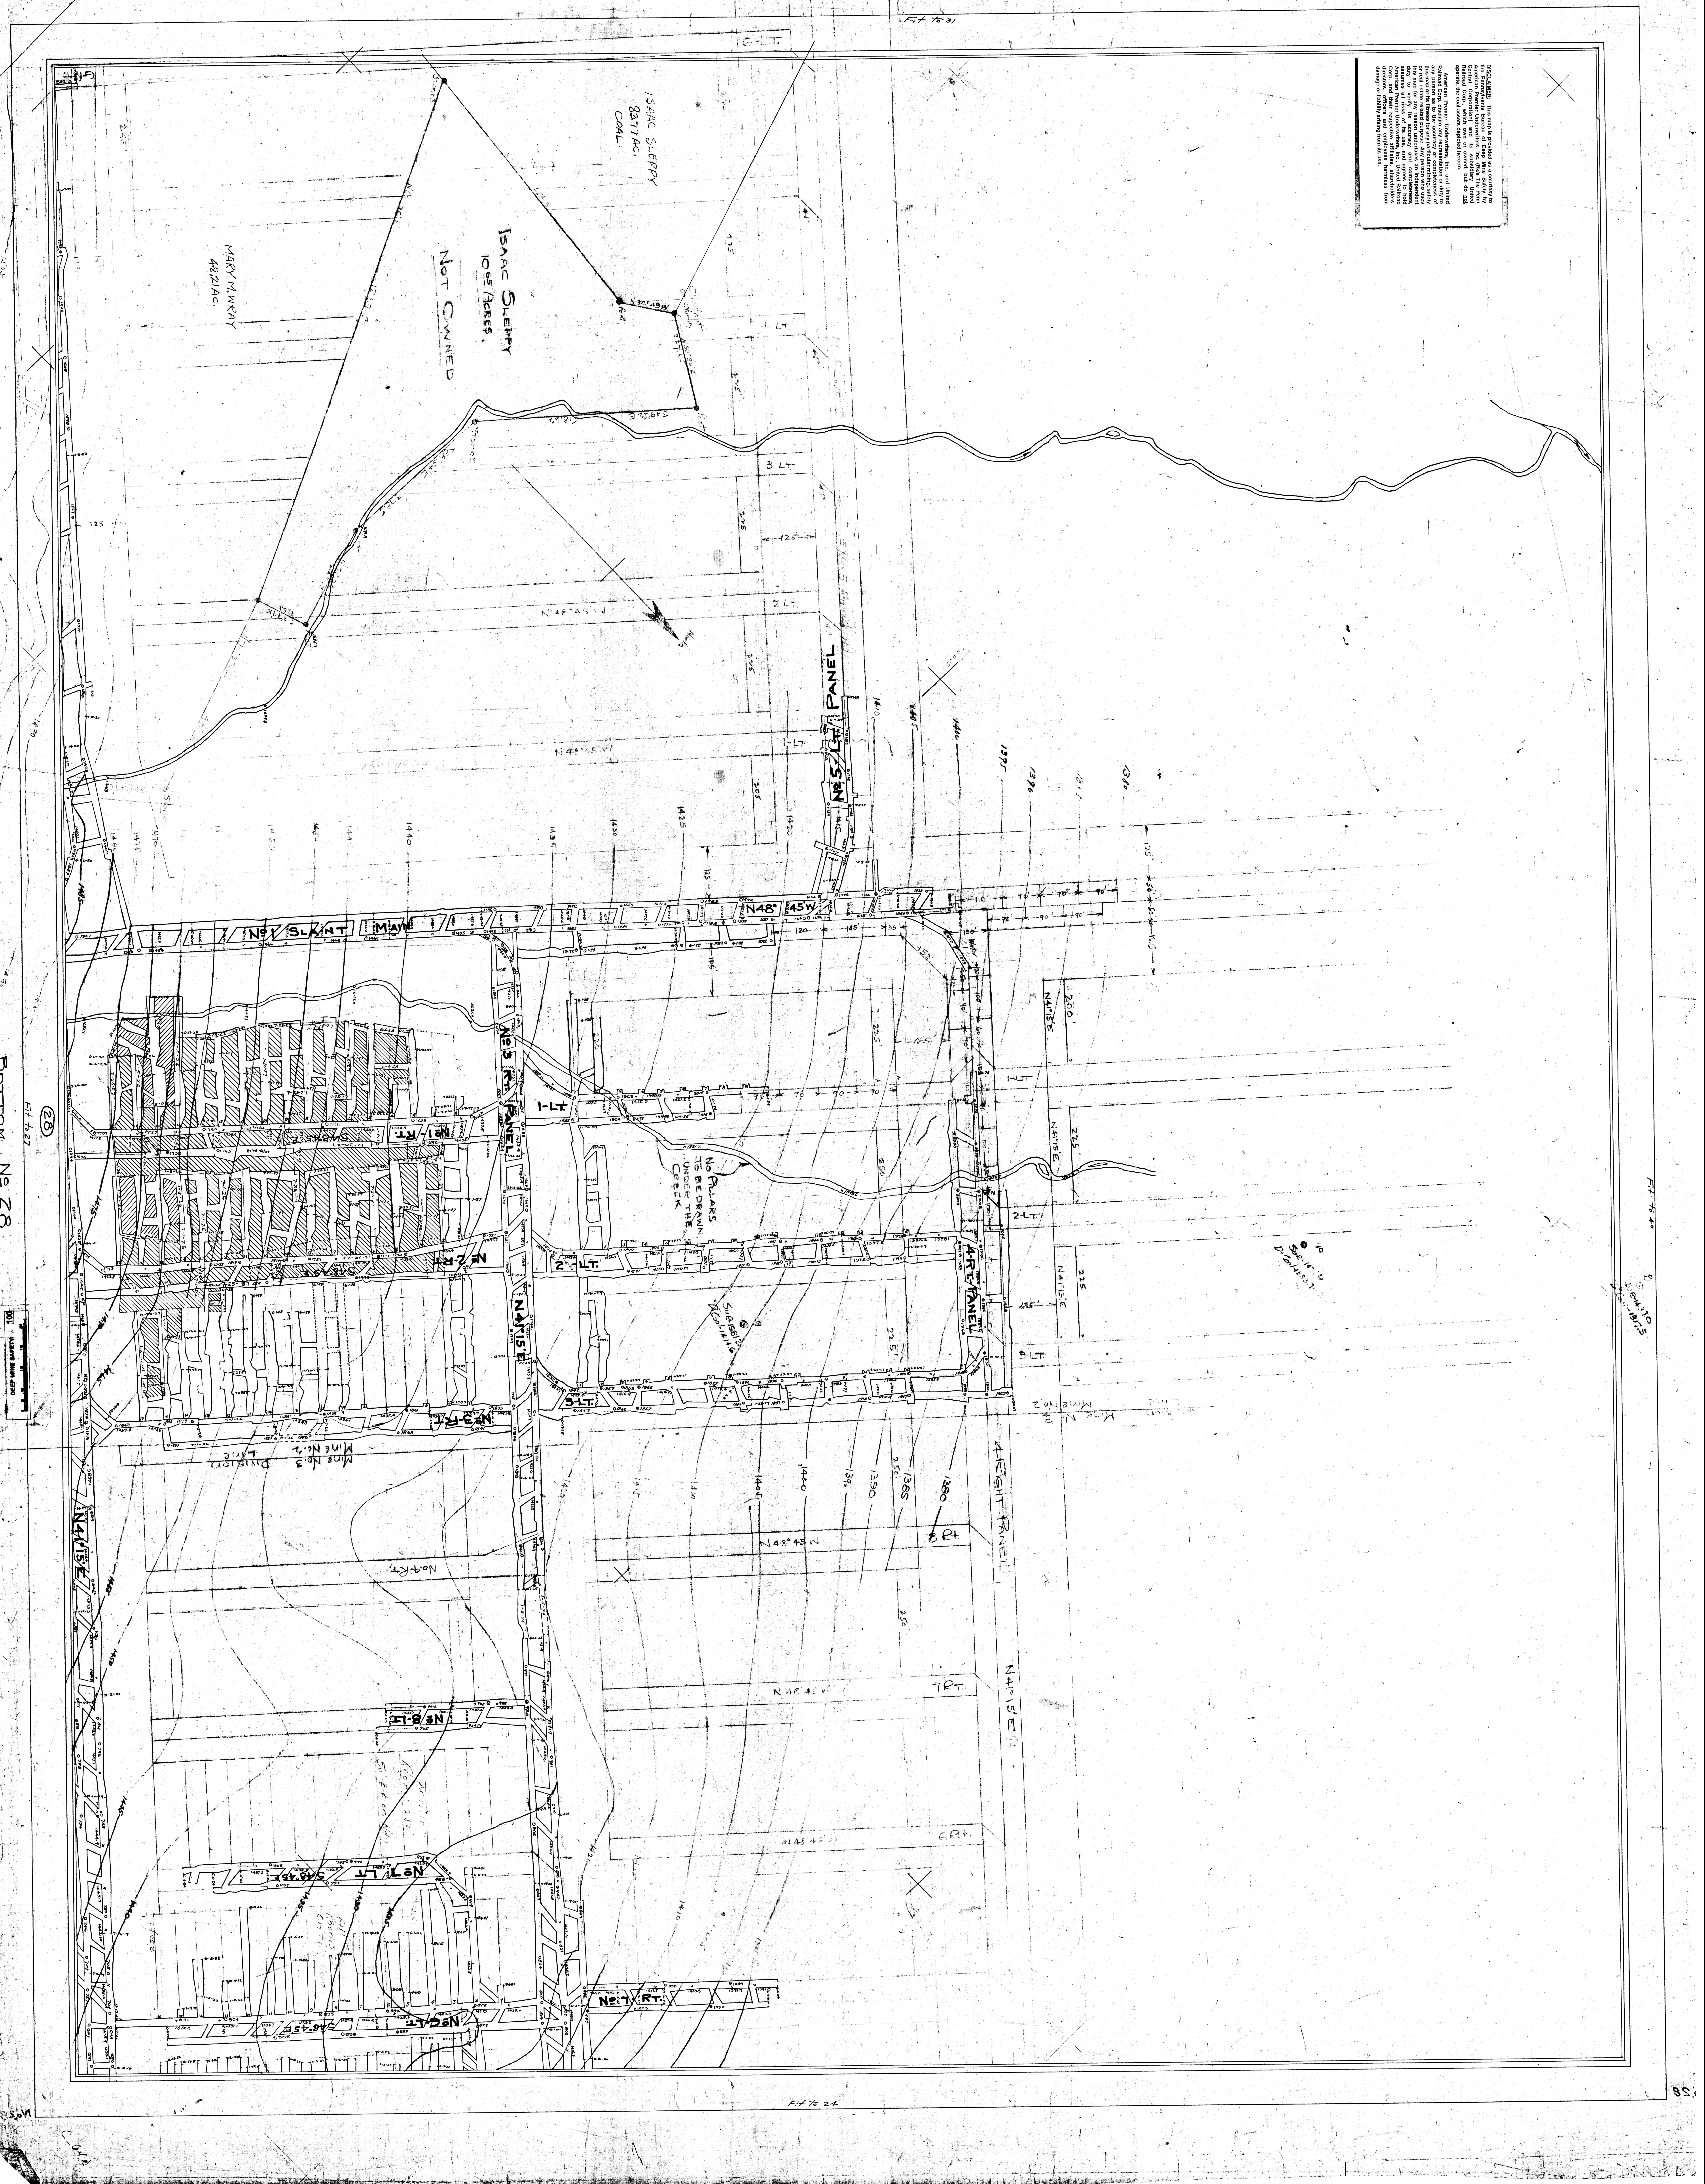
BOTTOM No 28
28
Fit to 27
Fit to 31
Fit to 40
Fit to 24
ISAAC SLEPPY 83.77 AC. COAL
ISAAC SLEPPY 10.65 ACRES NOT OWNED
MARY M. WRAY 48.21 AC.
Stones
Post
N 34° 49' W
S 49° 52' E
North
6-LT.
4 LT.
3 LT.
2 LT.
1-LT
N 48° 45' W
125
225
No 5 LT PANEL
No 1 SLANT MAIN
N48° 45'W
120
145'
110'
90'
90'
90'
50'
50'
125
125
200'
Water
No 3 RT PANEL
1-LT.
No 1 RT.
S 48° 45' E
No 2 RT
2 LT.
No PILLARS TO BE DRAWN UNDER THE CREEK
N41°15'E
3-LT.
No 3 RT
4-RT-PANEL
2-LT.
3-LT
N41°15'E
225
Mine No 3
Mine No 2
Division Line
No.9 Rt.
No 8 LT
No 7 LT
No 6 LT
No 7 RT.
8 Rt.
7 Rt.
6 Rt.
4 RIGHT PANEL
N 41°15' E
250
1440
1435
1430
1425
1420
1415
1410
1405
1400
1395
1390
1385
1380
DEEP MINE SAFETY
100

DISCLAIMER: This map is provided as a courtesy to the Pennsylvania Bureau of Deep Mine Safety by American Premier Underwriters, Inc. (f/k/a The Penn Central Corporation) and its subsidiary United Railroad Corp., which own or owned, but do not operate, the coal assets depicted hereon.

American Premier Underwriters, Inc. and United Railroad Corp. disclaim any representation or duty to any person as to the accuracy or completeness of this map or its fitness for any particular mining, safety or real estate related purpose. Any person who uses this map for any reason undertakes an independent duty to verify its accuracy and completeness, assumes all risks of its use, and agrees to hold American Premier Underwriters, Inc., United Railroad Corp. and their respective affiliates, shareholders, directors, officers and employees harmless from damage or liability arising from its use.