


X



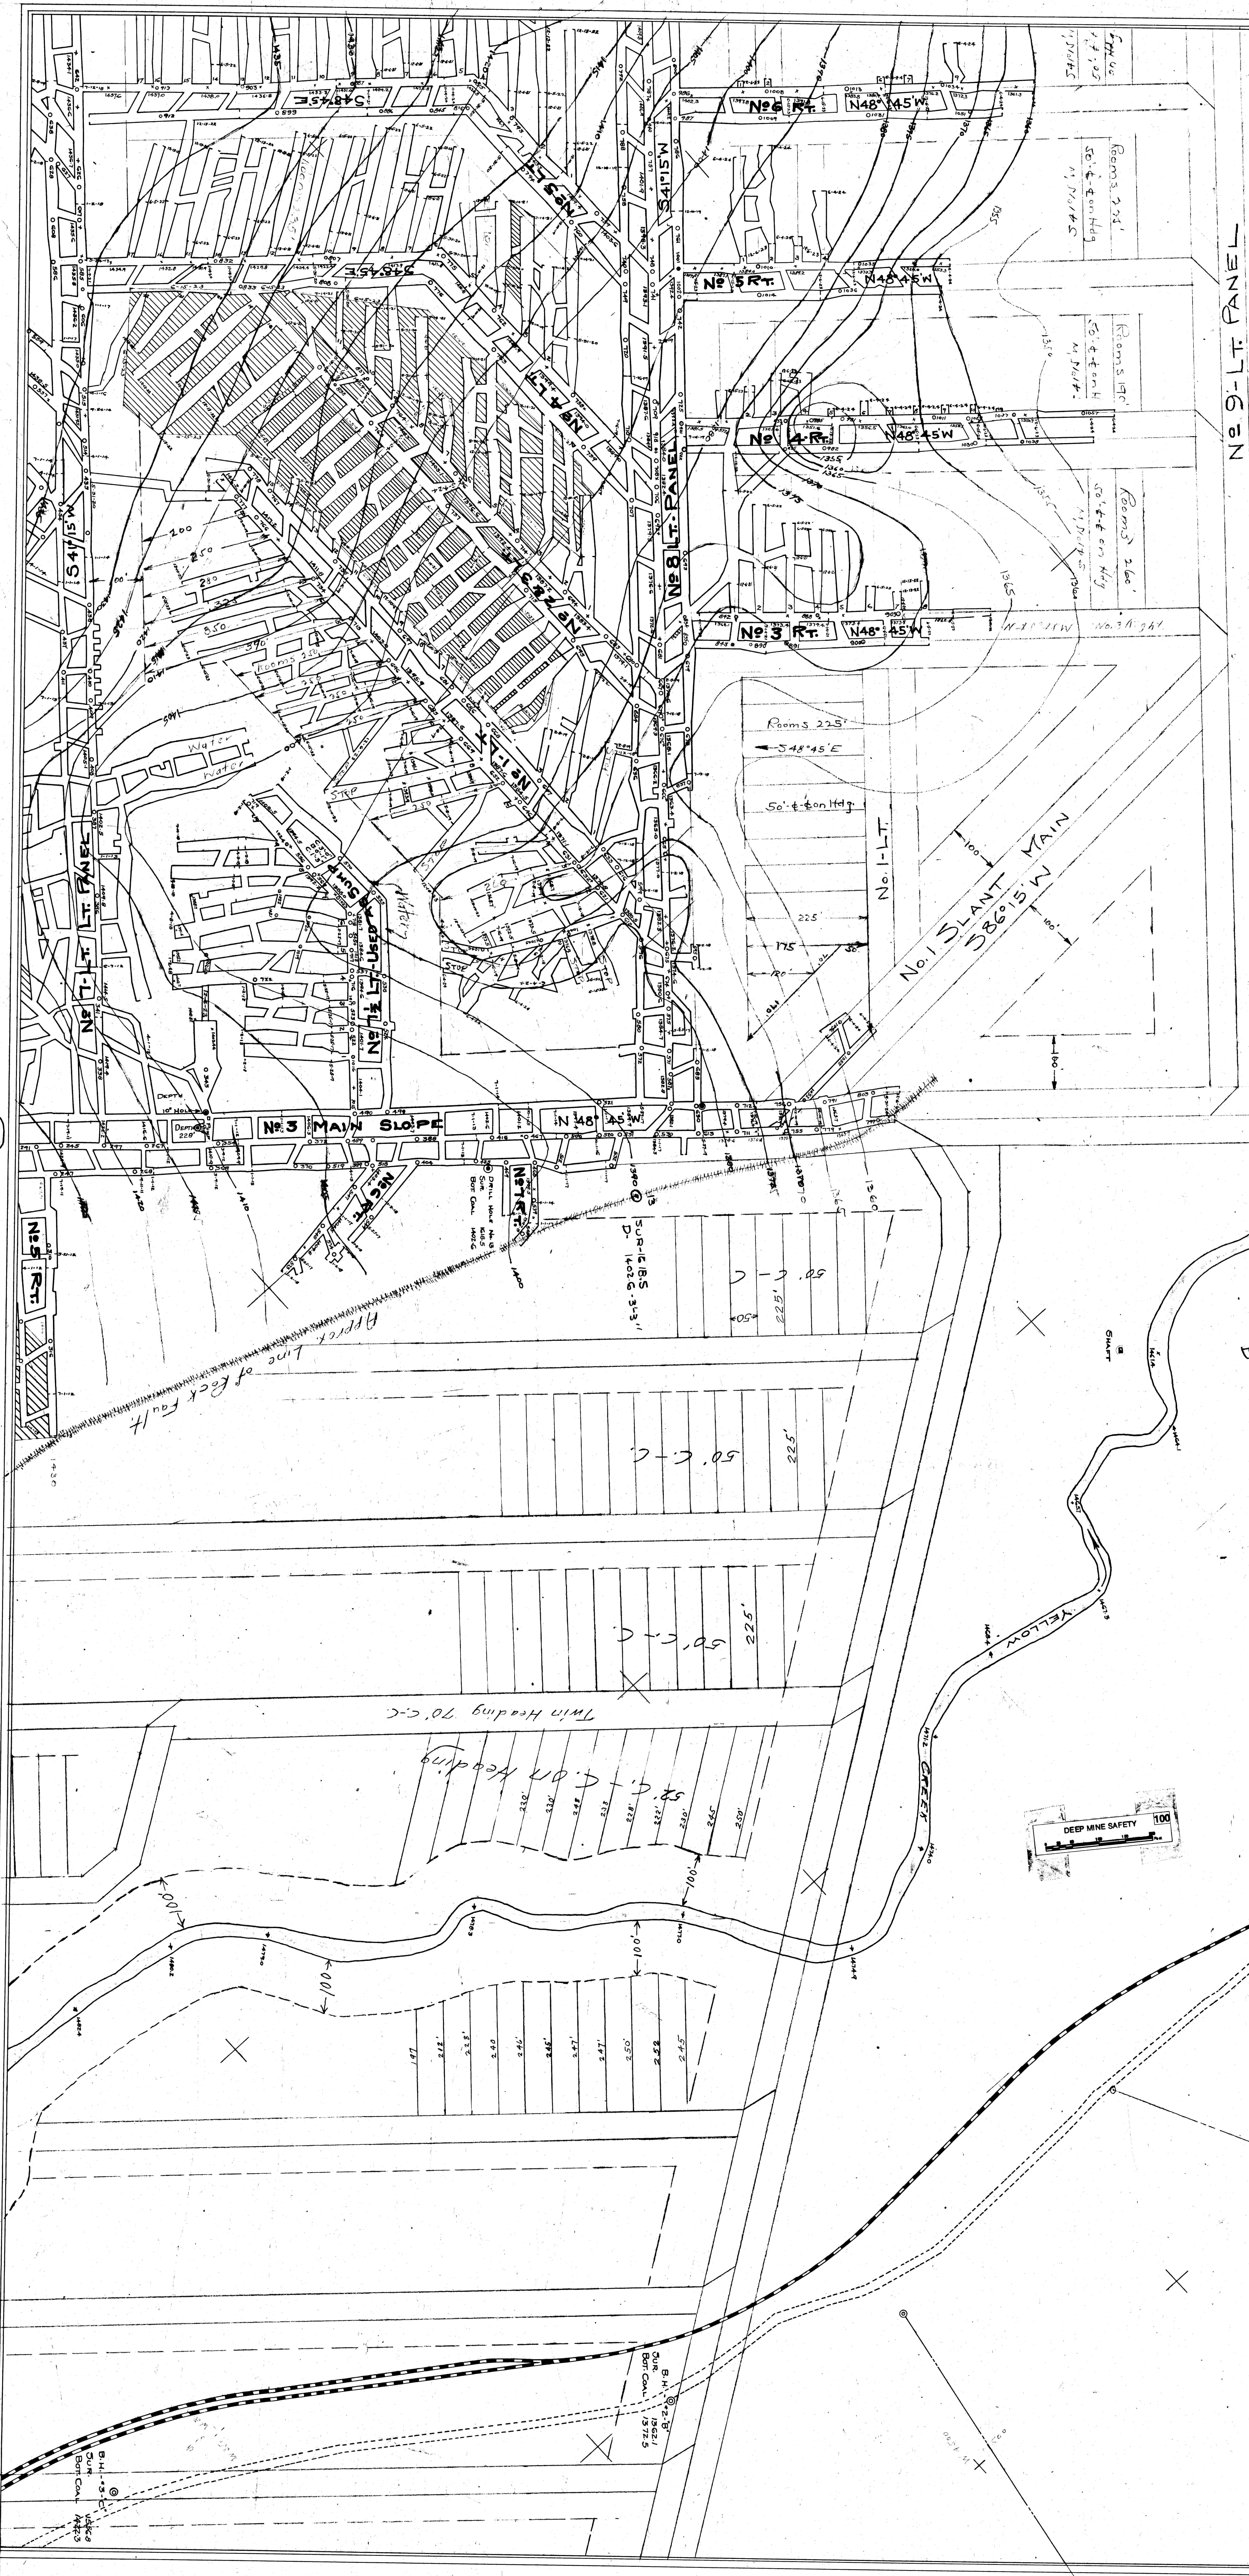

SUB-1515.0
D - 1388.0
AIN SLOPE
N 48° 45' W

S 84° 2
S 154° 0
D - 1344.0

