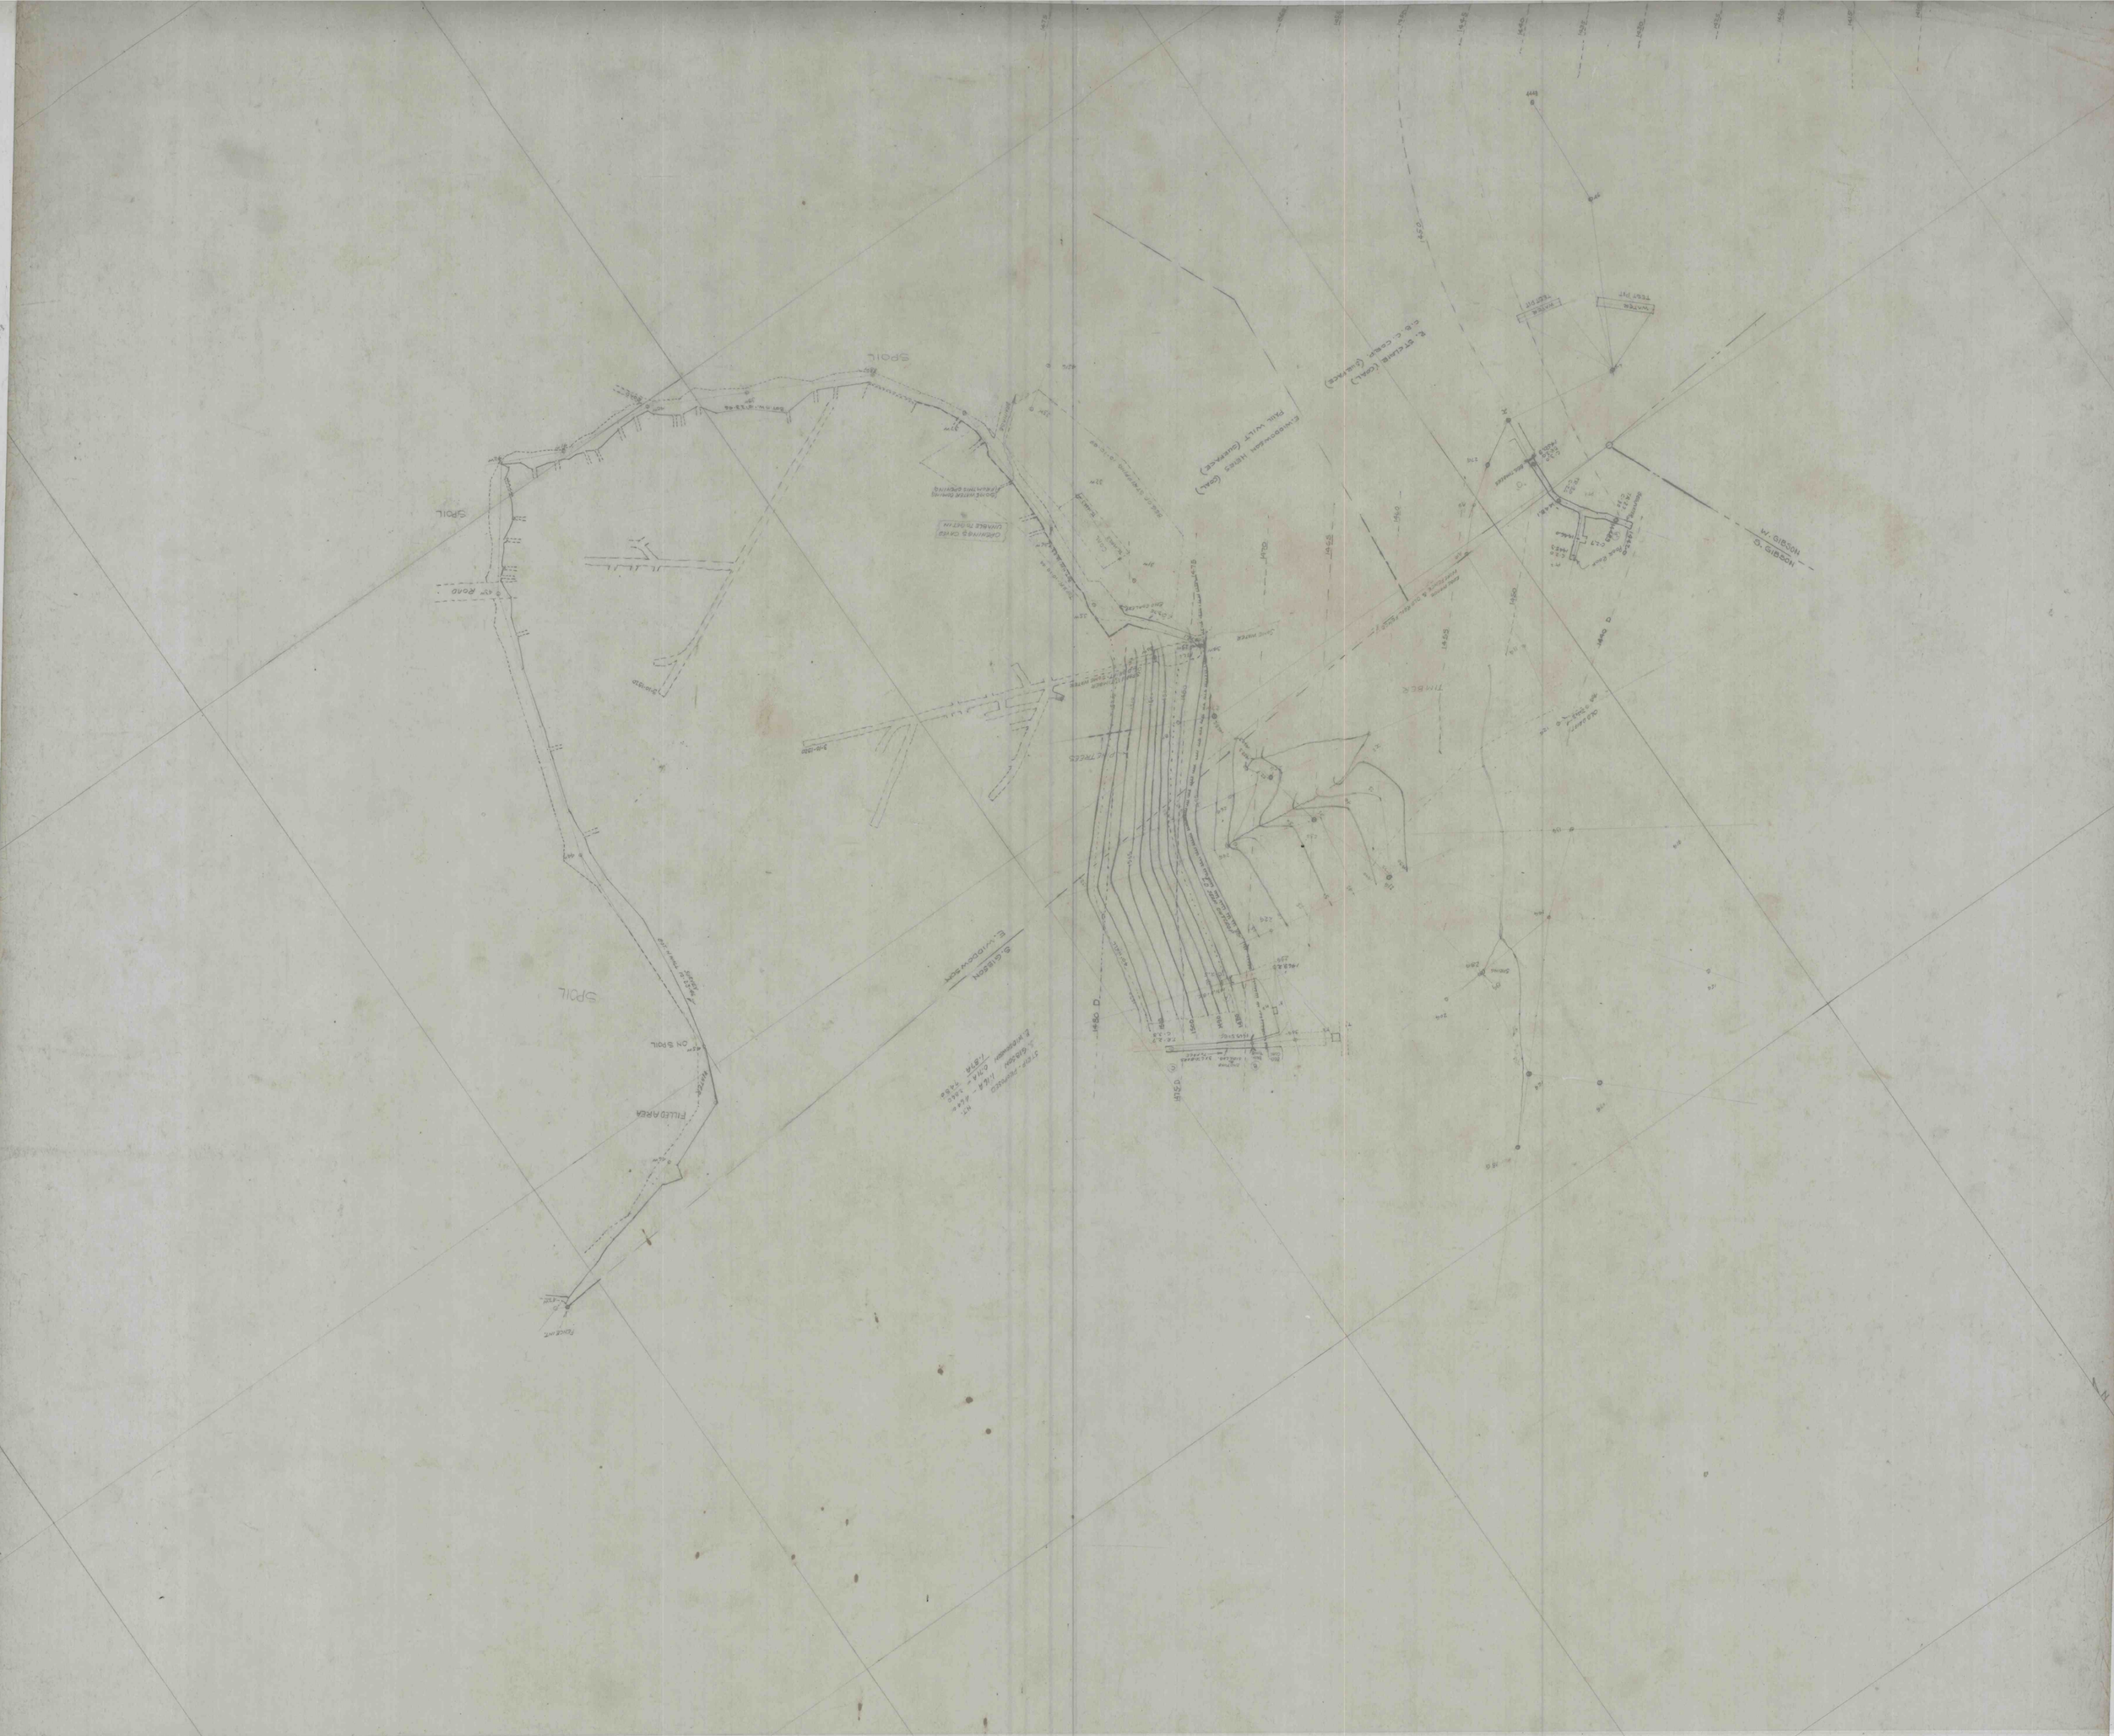
SPOIL
SPOIL
SPOIL
FILLED AREA
ON SPOIL
TIMBER
TIMBER
G. GIBSON
N. GIBSON
N. GIBSON
G. GIBSON
OPENING OVER UNABLE TO GET IN
STOPE REMOVED
GIBSON VIDA - 1945
E. WINDSOR - 1945
NT
NT