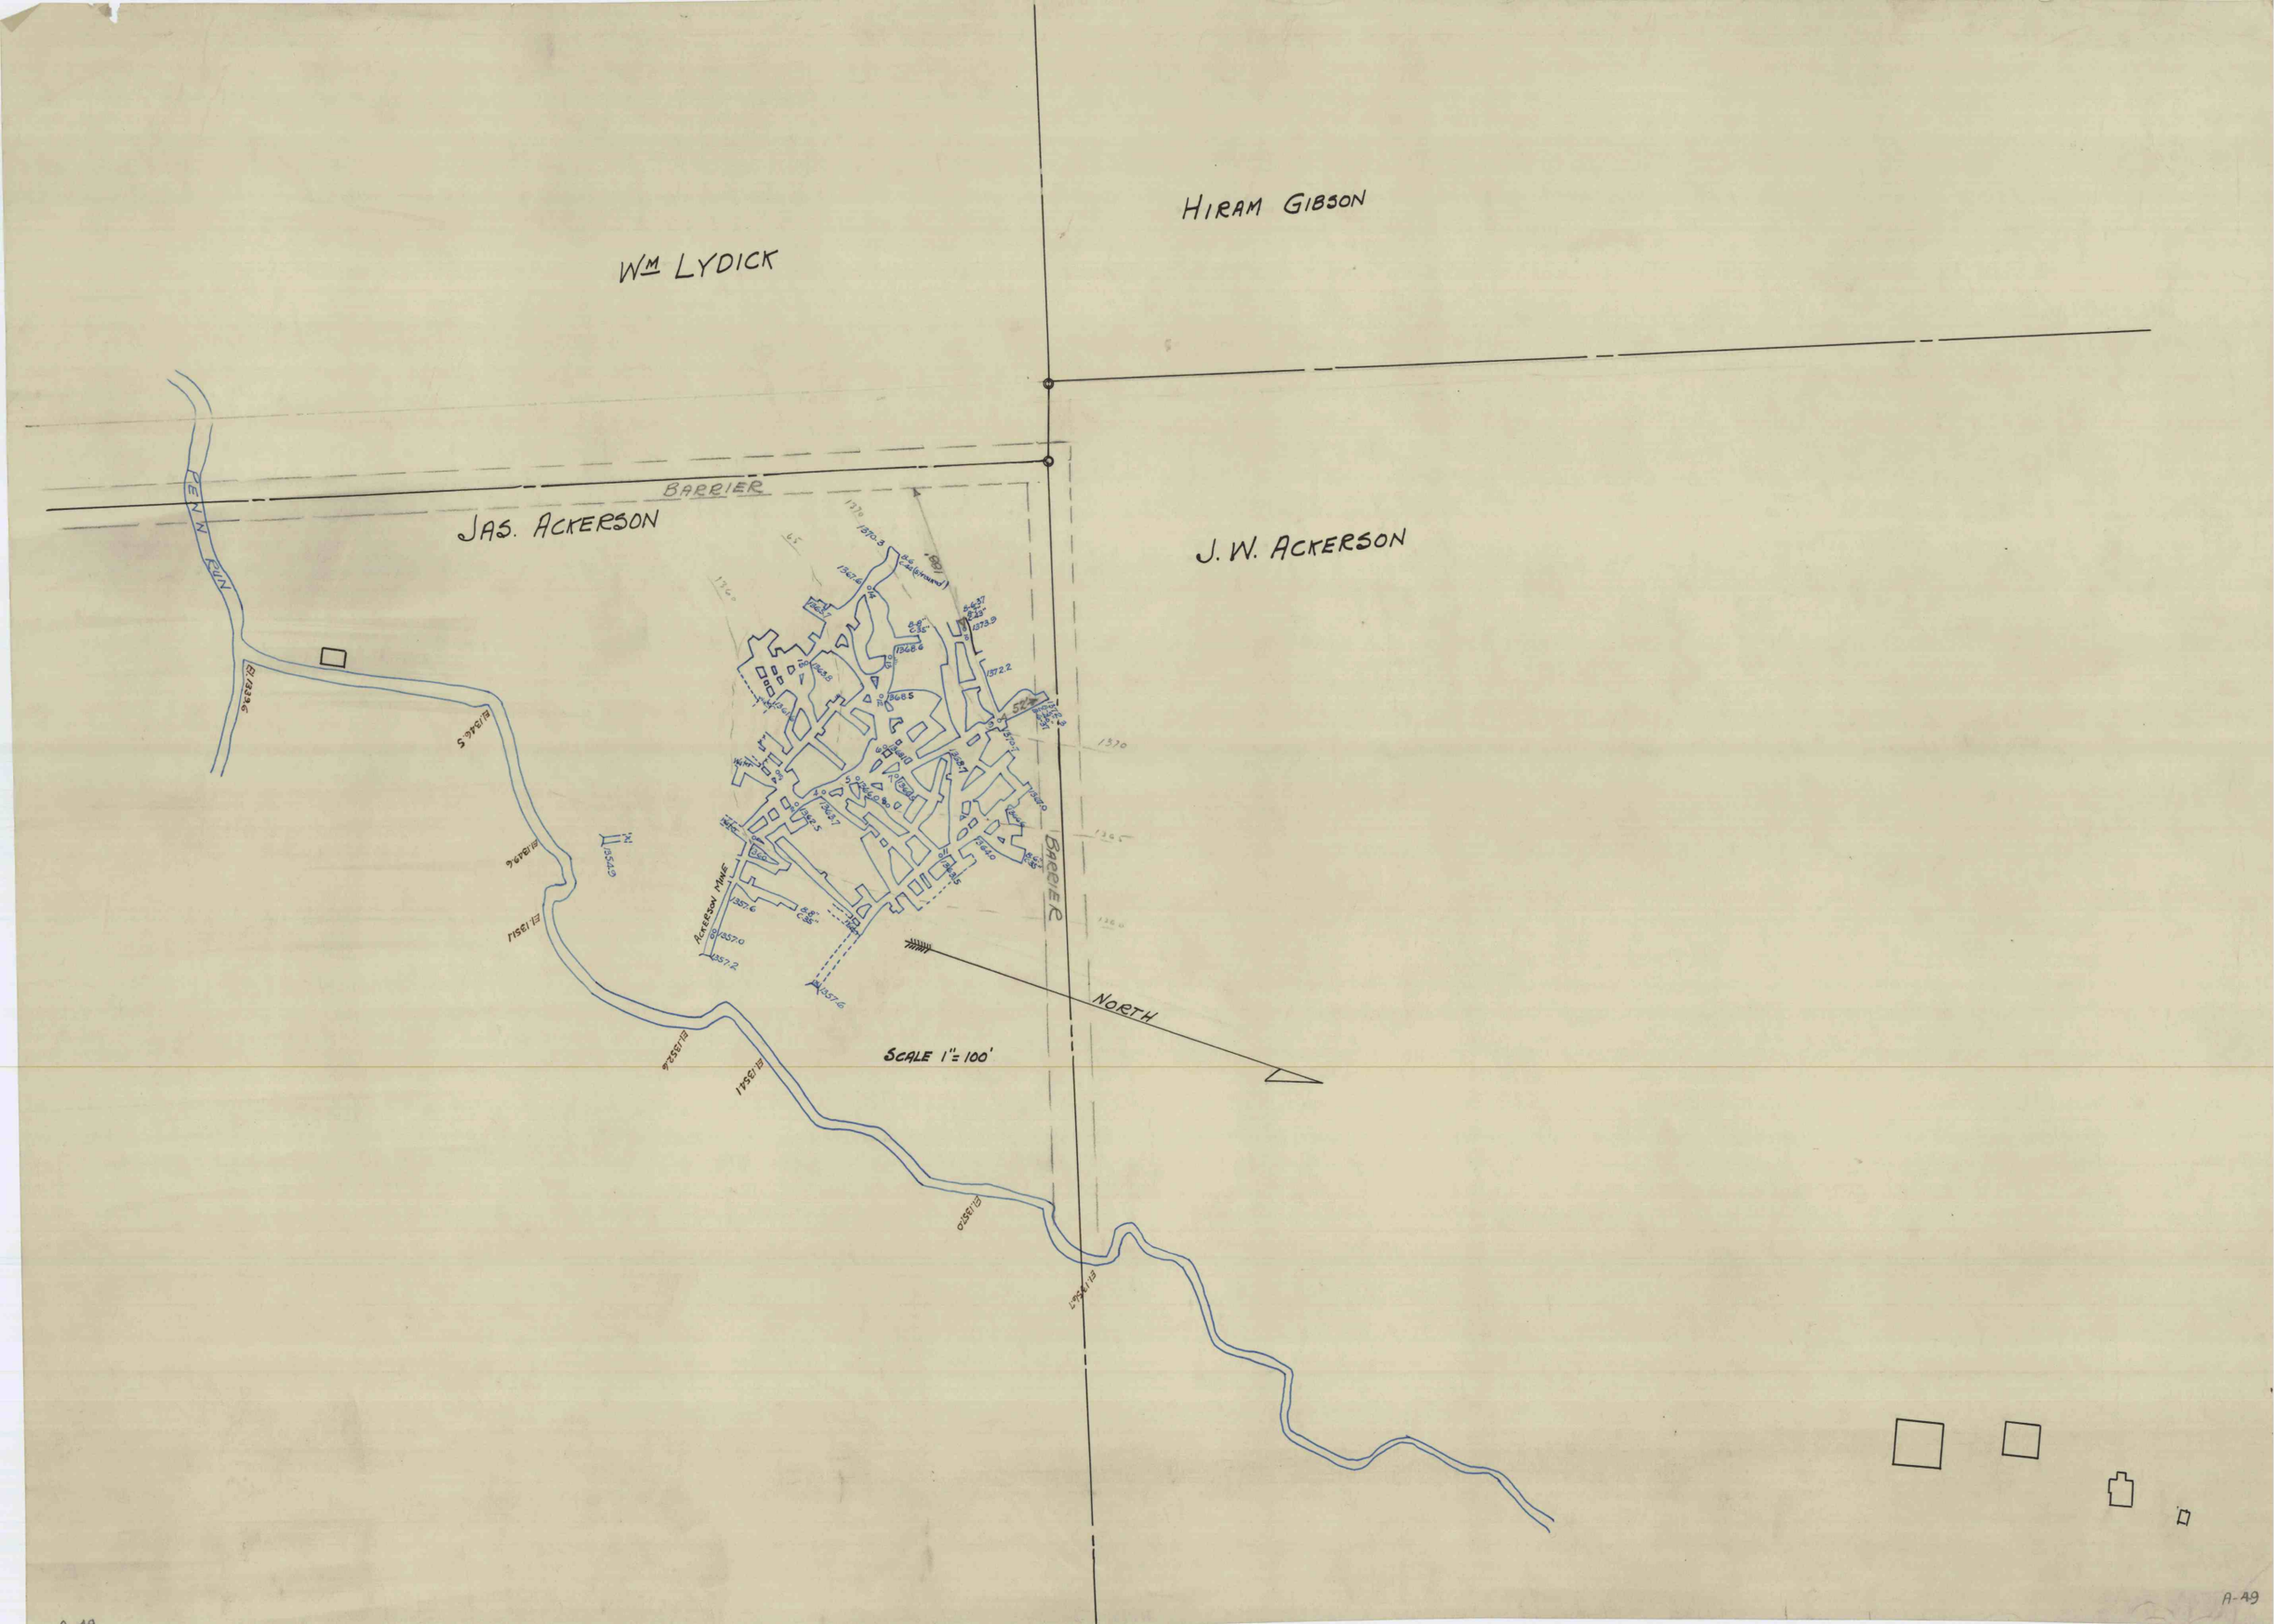
HIRAM GIBSON
WM LYDICK
BARRIER
JAS. ACKERSON
J. W. ACKERSON
PENN RUN
ACKERSON MINE
BARRIER
NORTH
SCALE 1" = 100'
A-A9