


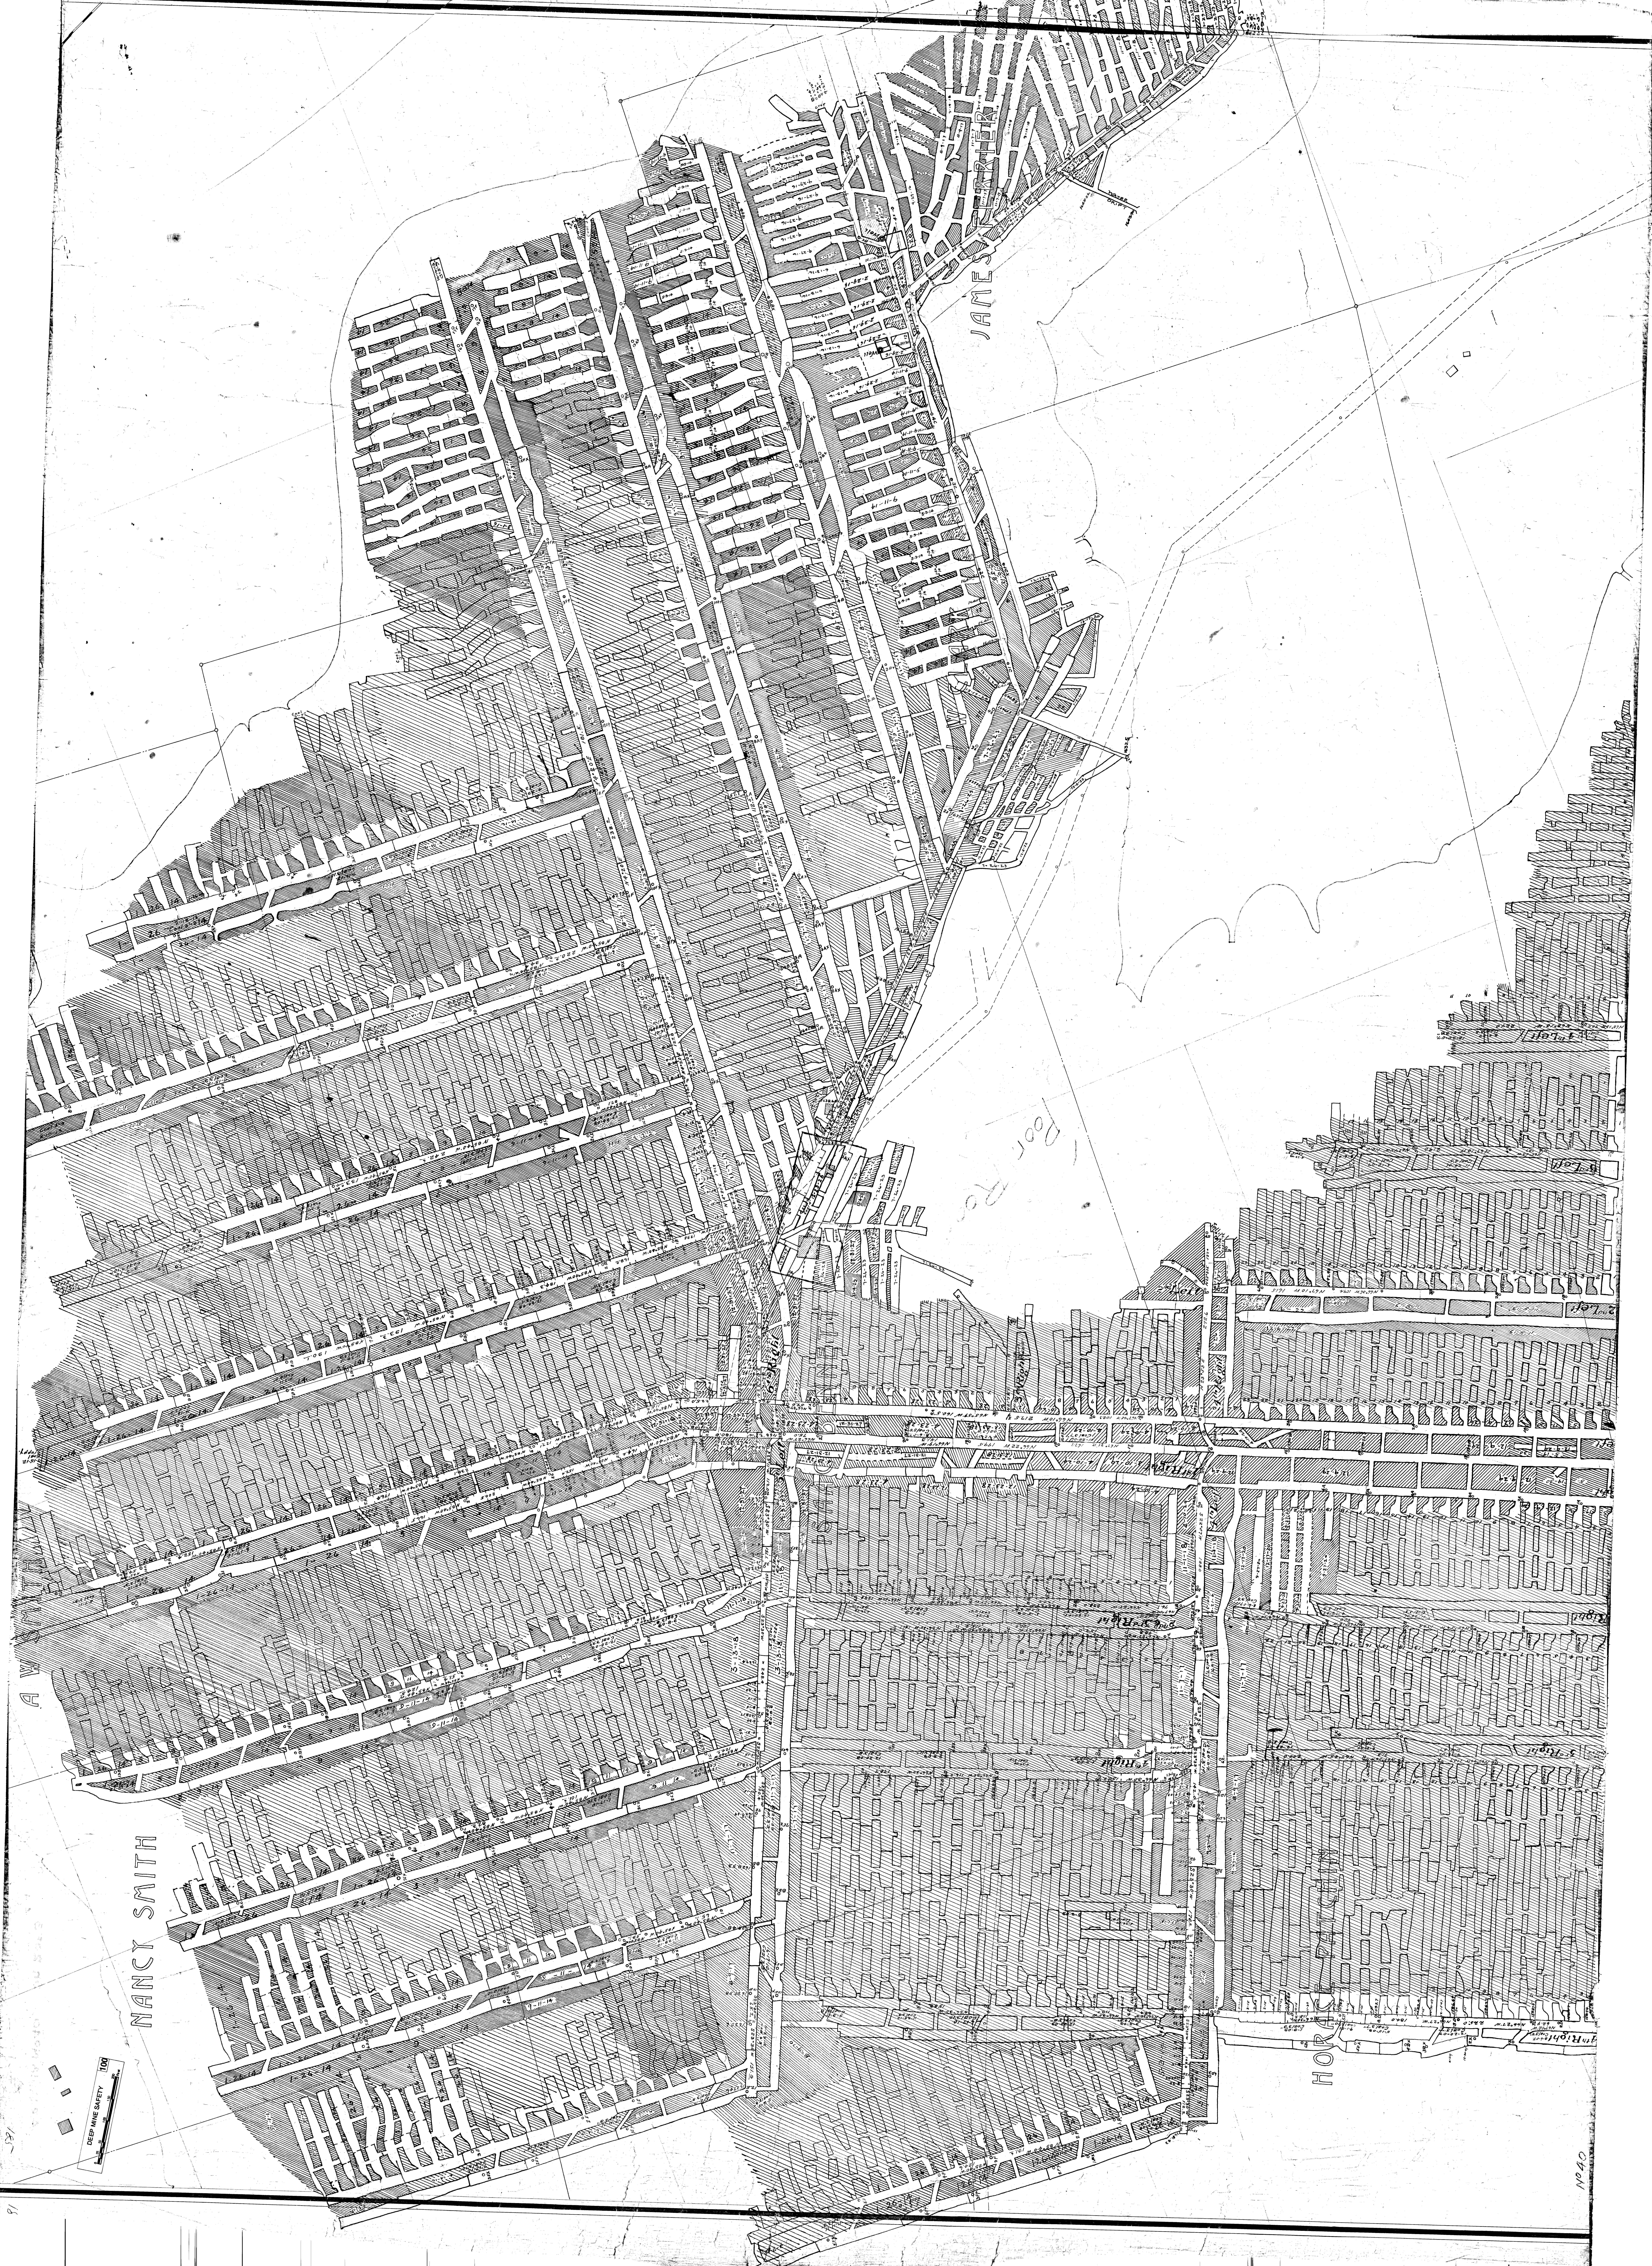

NANCY SMITH


100