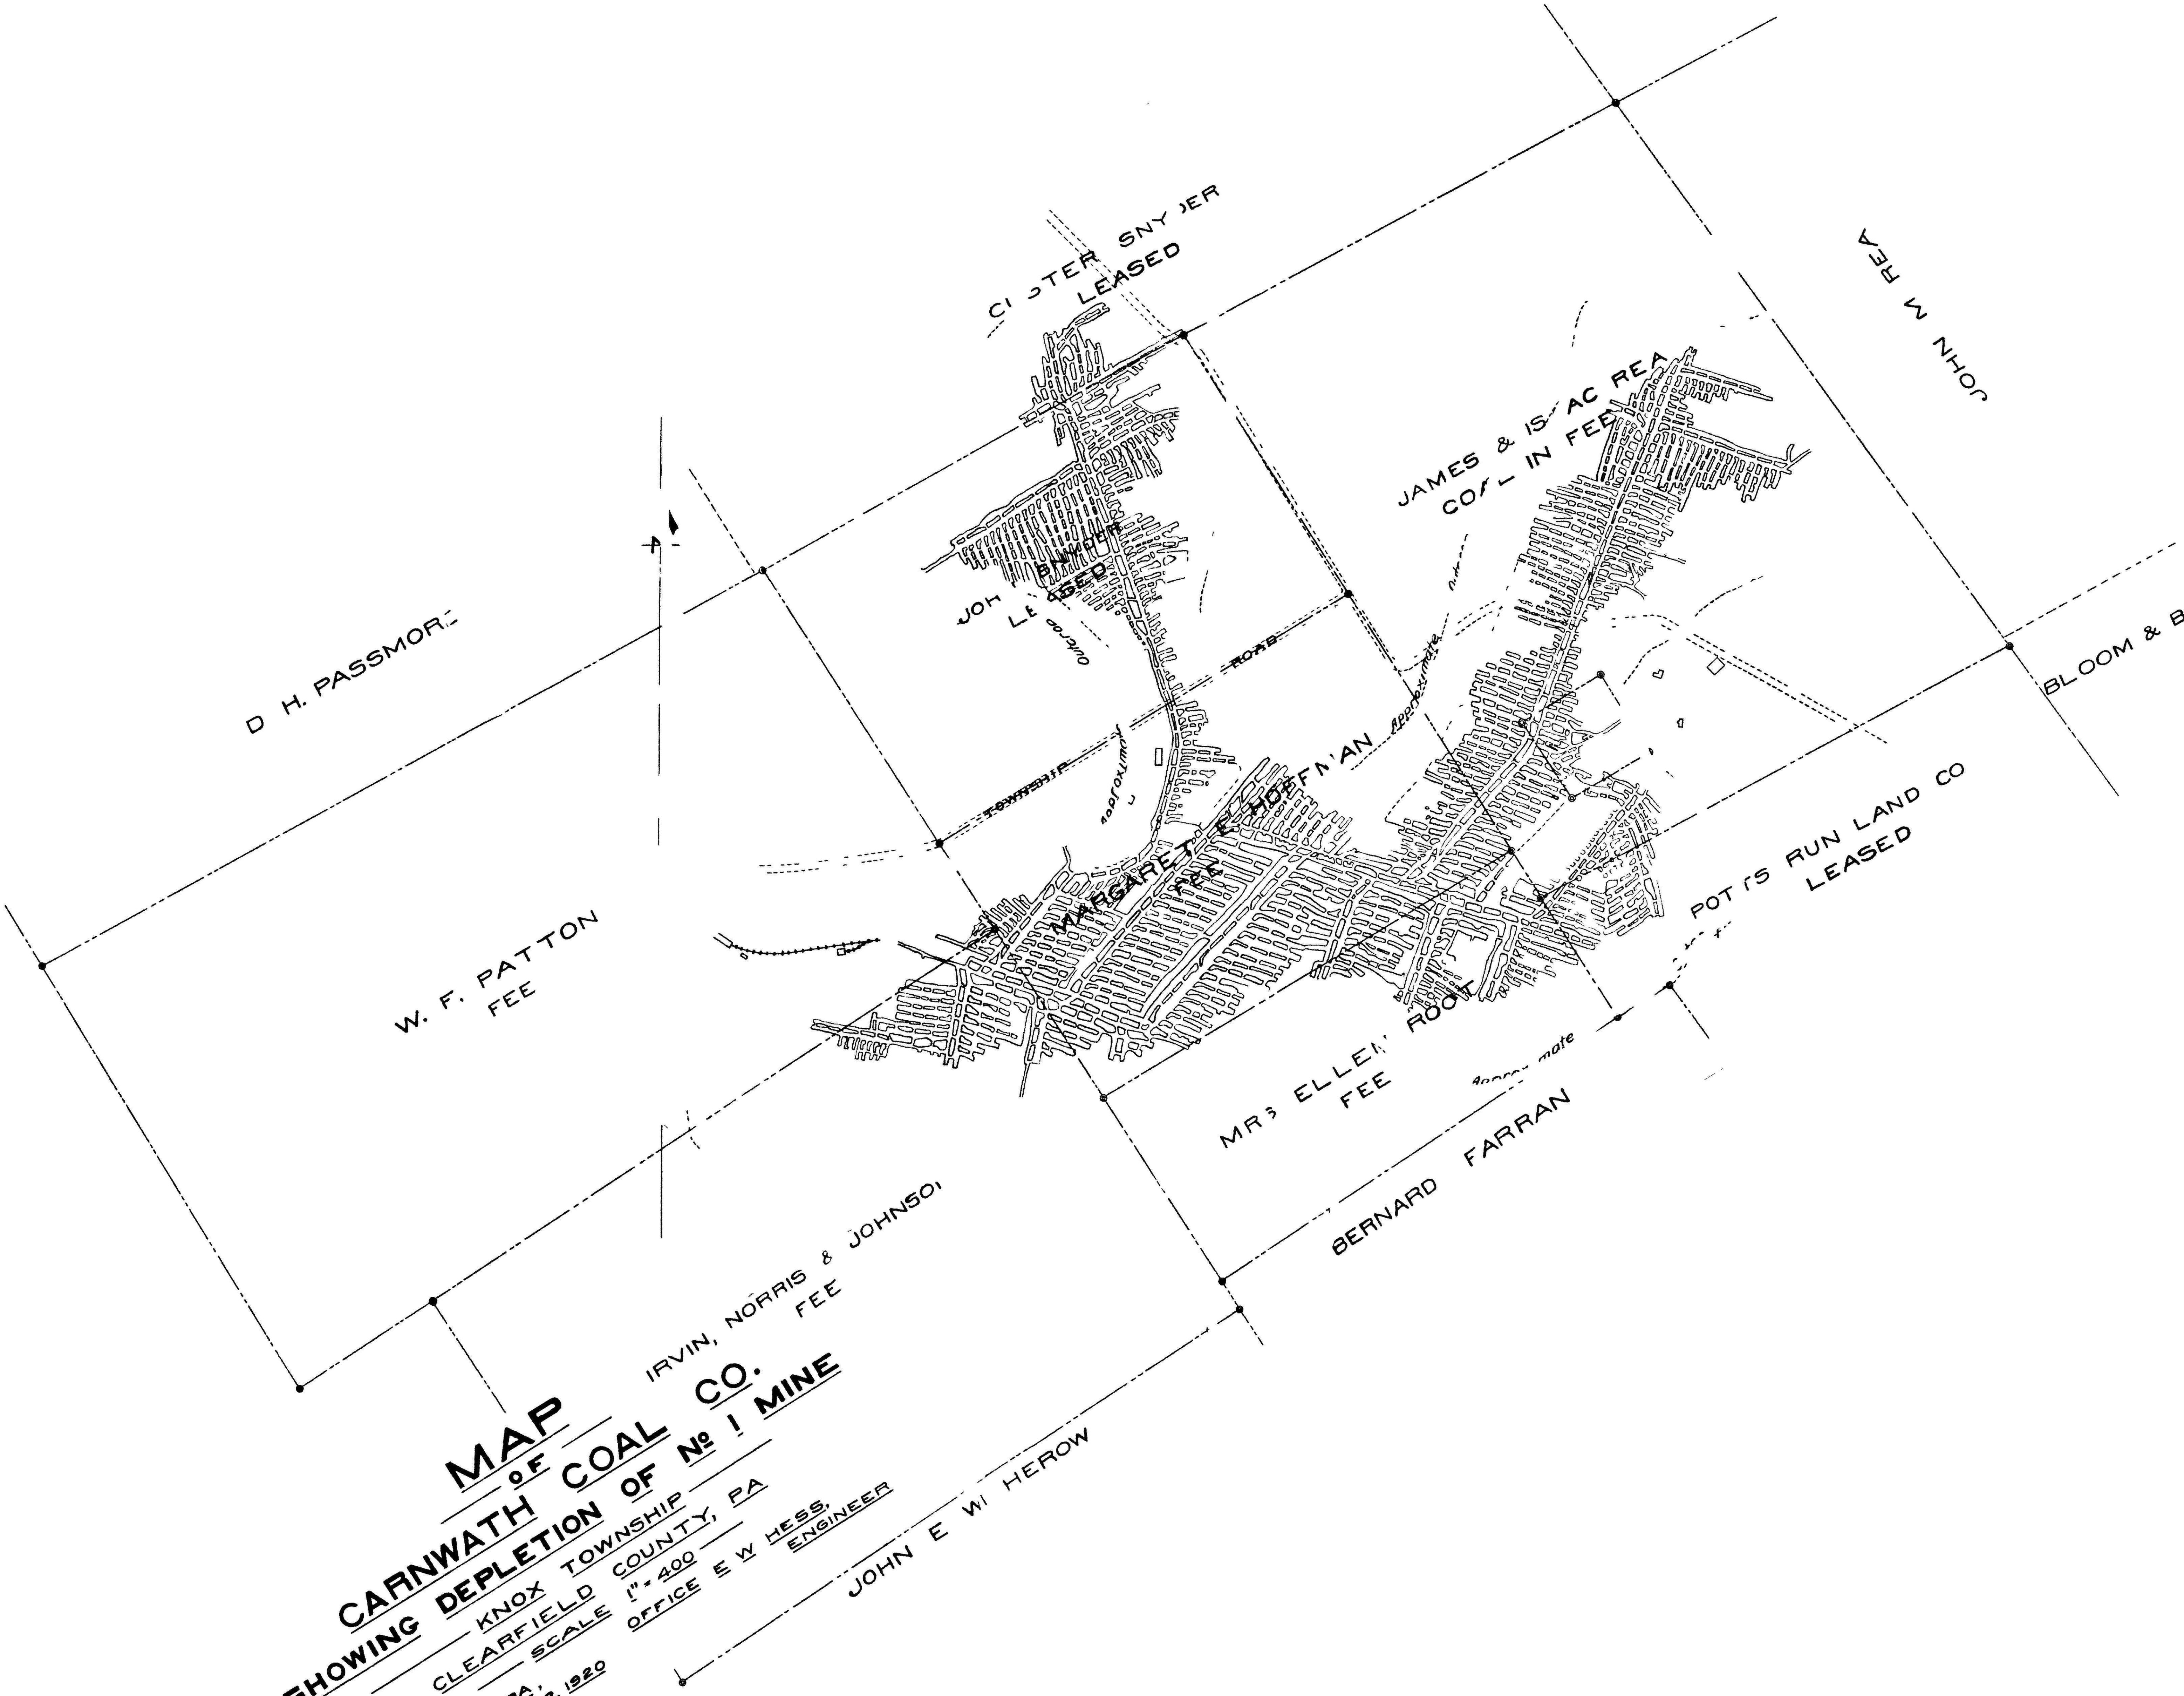

MAP
OF
CARNWATH COAL CO.
SHOWING DEPLETION OF № 1 MINE

KNOX TOWNSHIP
CLEARFIELD COUNTY, PA
SCALE 1" = 400
OFFICE E W HESS, ENGINEER
CLEARFIELD, PA,
JUNE 12, 1920