DEEP MINE SAFETY 100

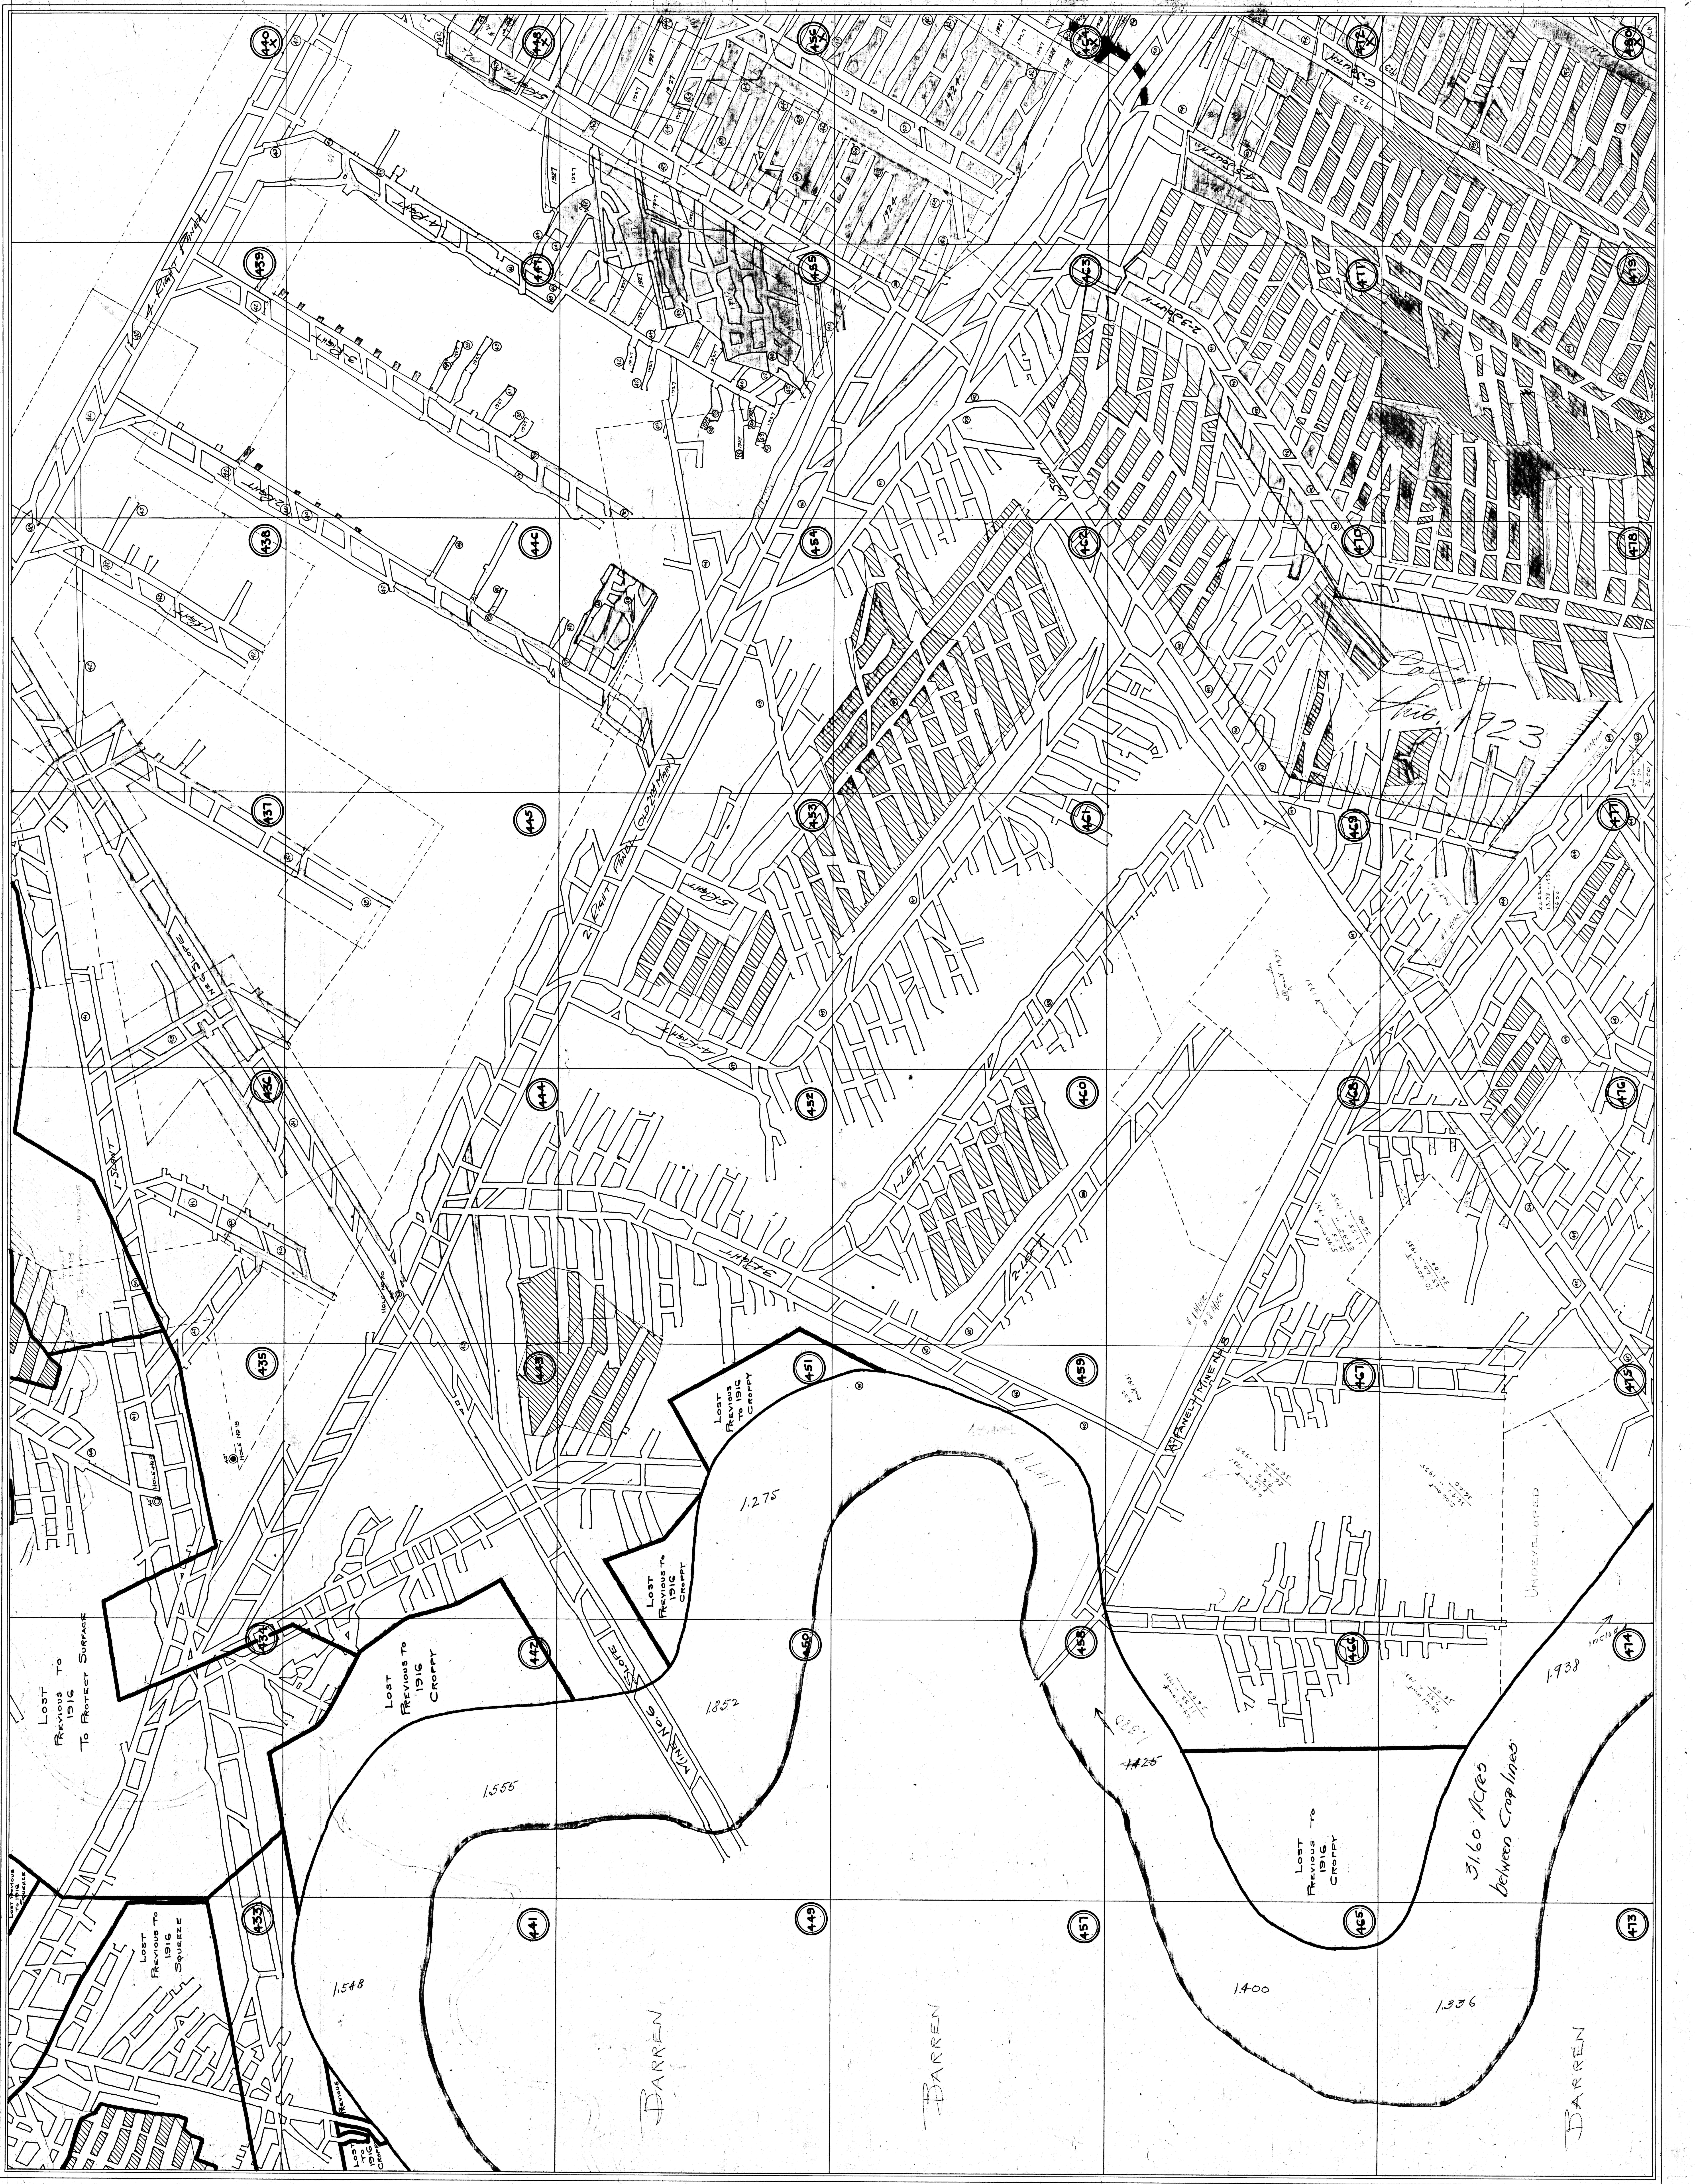
440 X
448 X
456 X
464 X
472 X
480 X
439
447
455
463
471
479
438
446
454
462
470
478
437
445
453
461
469
477
436
444
452
460
468
476
435
443
451
459
467
475
434
442
450
458
466
474
433
441
449
457
465
473
4-Right Panel
5-Right
4-Right
3-Right
2-Right
1-Right
6-South
4-5 South
2-3 South
1-South
1923
1924
1927
1928
2 Right Panel (Old 2nd Main)
5-Right
4-Right
No 2 Slope
1-Slant
3-Right
1-Left
2-Left
Aug. 1923
Hole No 20
Hole No 18
Hole No 8
"A" Panel Mine No. 8
#1 Mine
#8 Mine
Mine No. 9 Slope
Lost Previous to 1916 To Protect Surface
Lost Previous to 1916 Croppy
Lost Previous to 1916 Squeeze
Lost Previous to 1916 Croppy
1.275
1.852
1.555
1.548
1.400
1.336
1.938
~~1.425~~
31.60 Acres between Crop lines
Included
Undeveloped
Barren
Barren
Barren

Bottom – No. 10 – Working