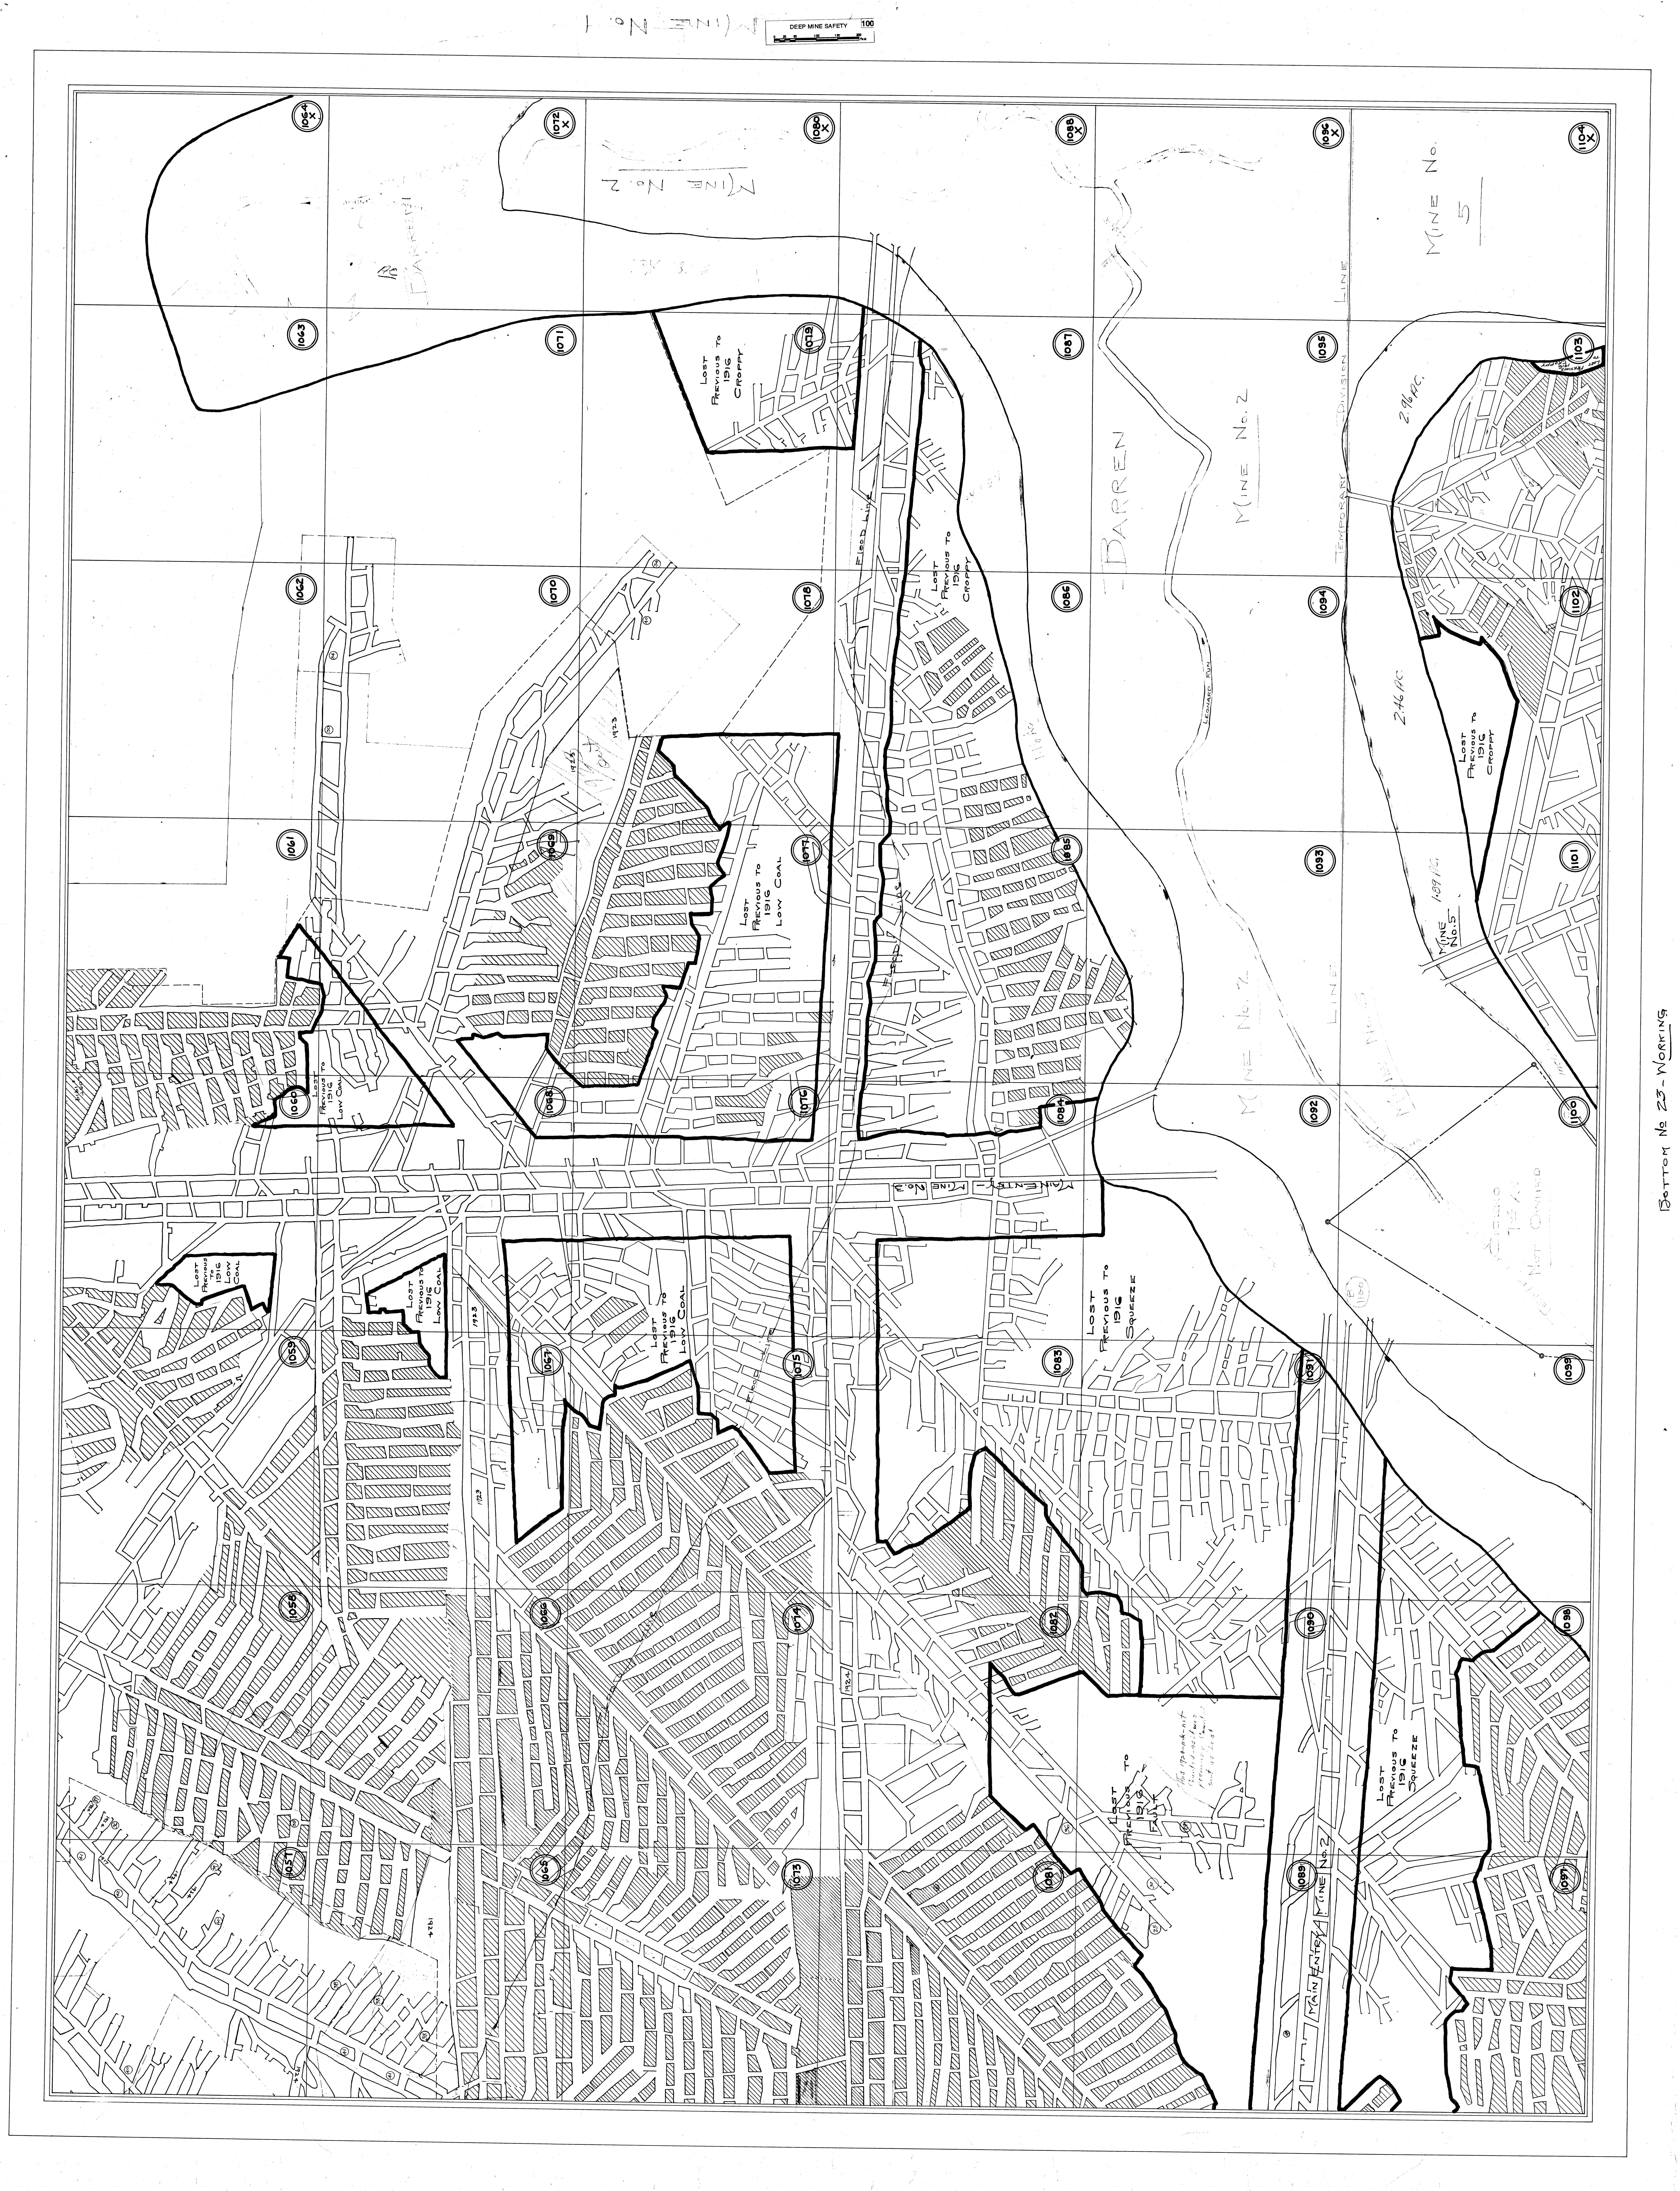Mine No. 1
DEEP MINE SAFETY 100
0 25 50 100 150 200 Feet
1064 X
1072 X
1080 X
1088 X
1096 X
1104 X
1063
1071
1079
1087
1095
1103
1062
1070
1078
1086
1094
1102
1061
1069
1077
1085
1093
1101
1060
1068
1076
1084
1092
1100
1059
1067
1075
1083
1091
1099
1058
1066
1074
1082
1090
1098
1057
1065
1073
1081
1089
1097
Mine No. 2
Barren
Mine No. 5
Temporary Division Line
Leonard Run
2.96 Ac.
2.46 Ac
1.89 Ac
Mine No. 5
Mine No. 2
Line
Mine No. 5
Lost Previous to 1916 Croppy
Lost Previous to 1916 Croppy
Lost Previous to 1916 Croppy
Lost Previous to 1916 Croppy
Lost Previous to 1916 Low Coal
Lost Previous to 1916 Low Coal
Lost Previous to 1916 Low Coal
Lost Previous to 1916 Low Coal
Lost Previous to 1916 Low Coal
Lost Previous to 1916 Squeeze
Lost Previous to 1916 Squeeze
Lost Previous to 1916 Fault
This 1924 work not counted as it was previously counted as lost
Flood Line
Flood Line
Flood Line
Main Entry - Mine No. 3
Main Entry Mine No. 2
1923
1923
1923
1923
1923
1924
1924
1924
1924
1917
Bottom No 23 - Working