


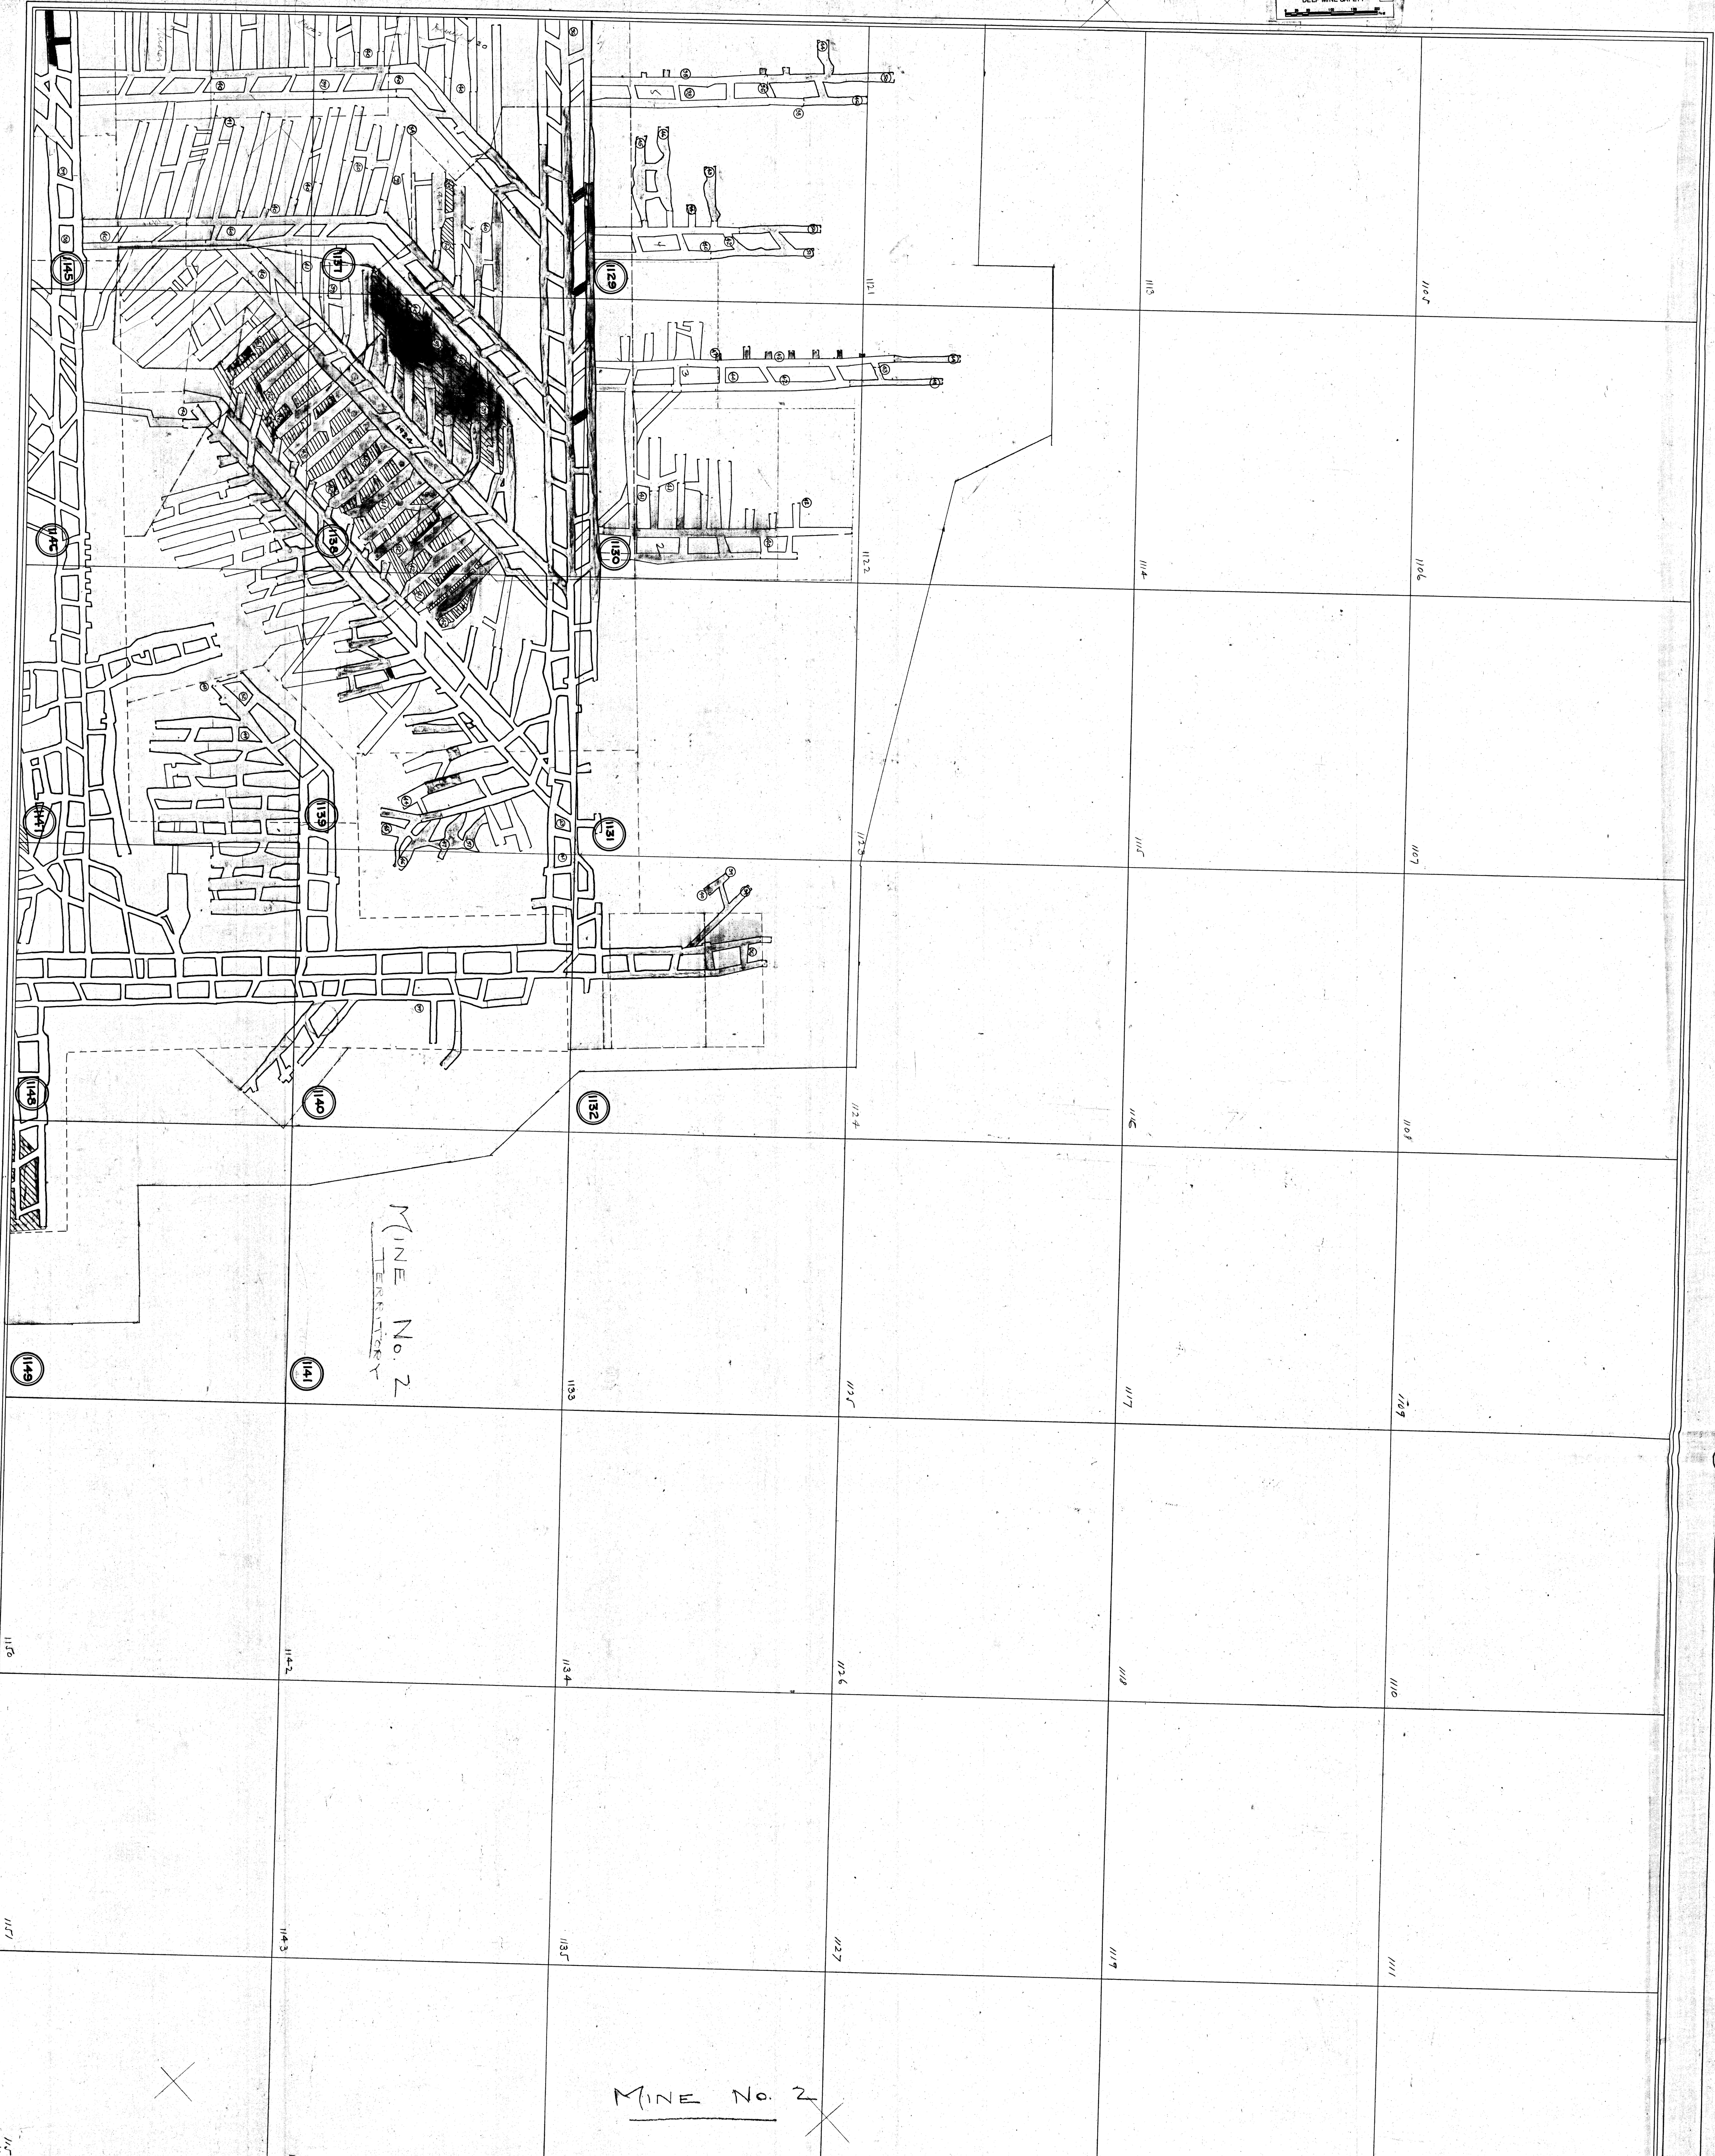

BOTTOM NEZAR WORKING

MINE No. 2