DEEP MINE SAFETY
100

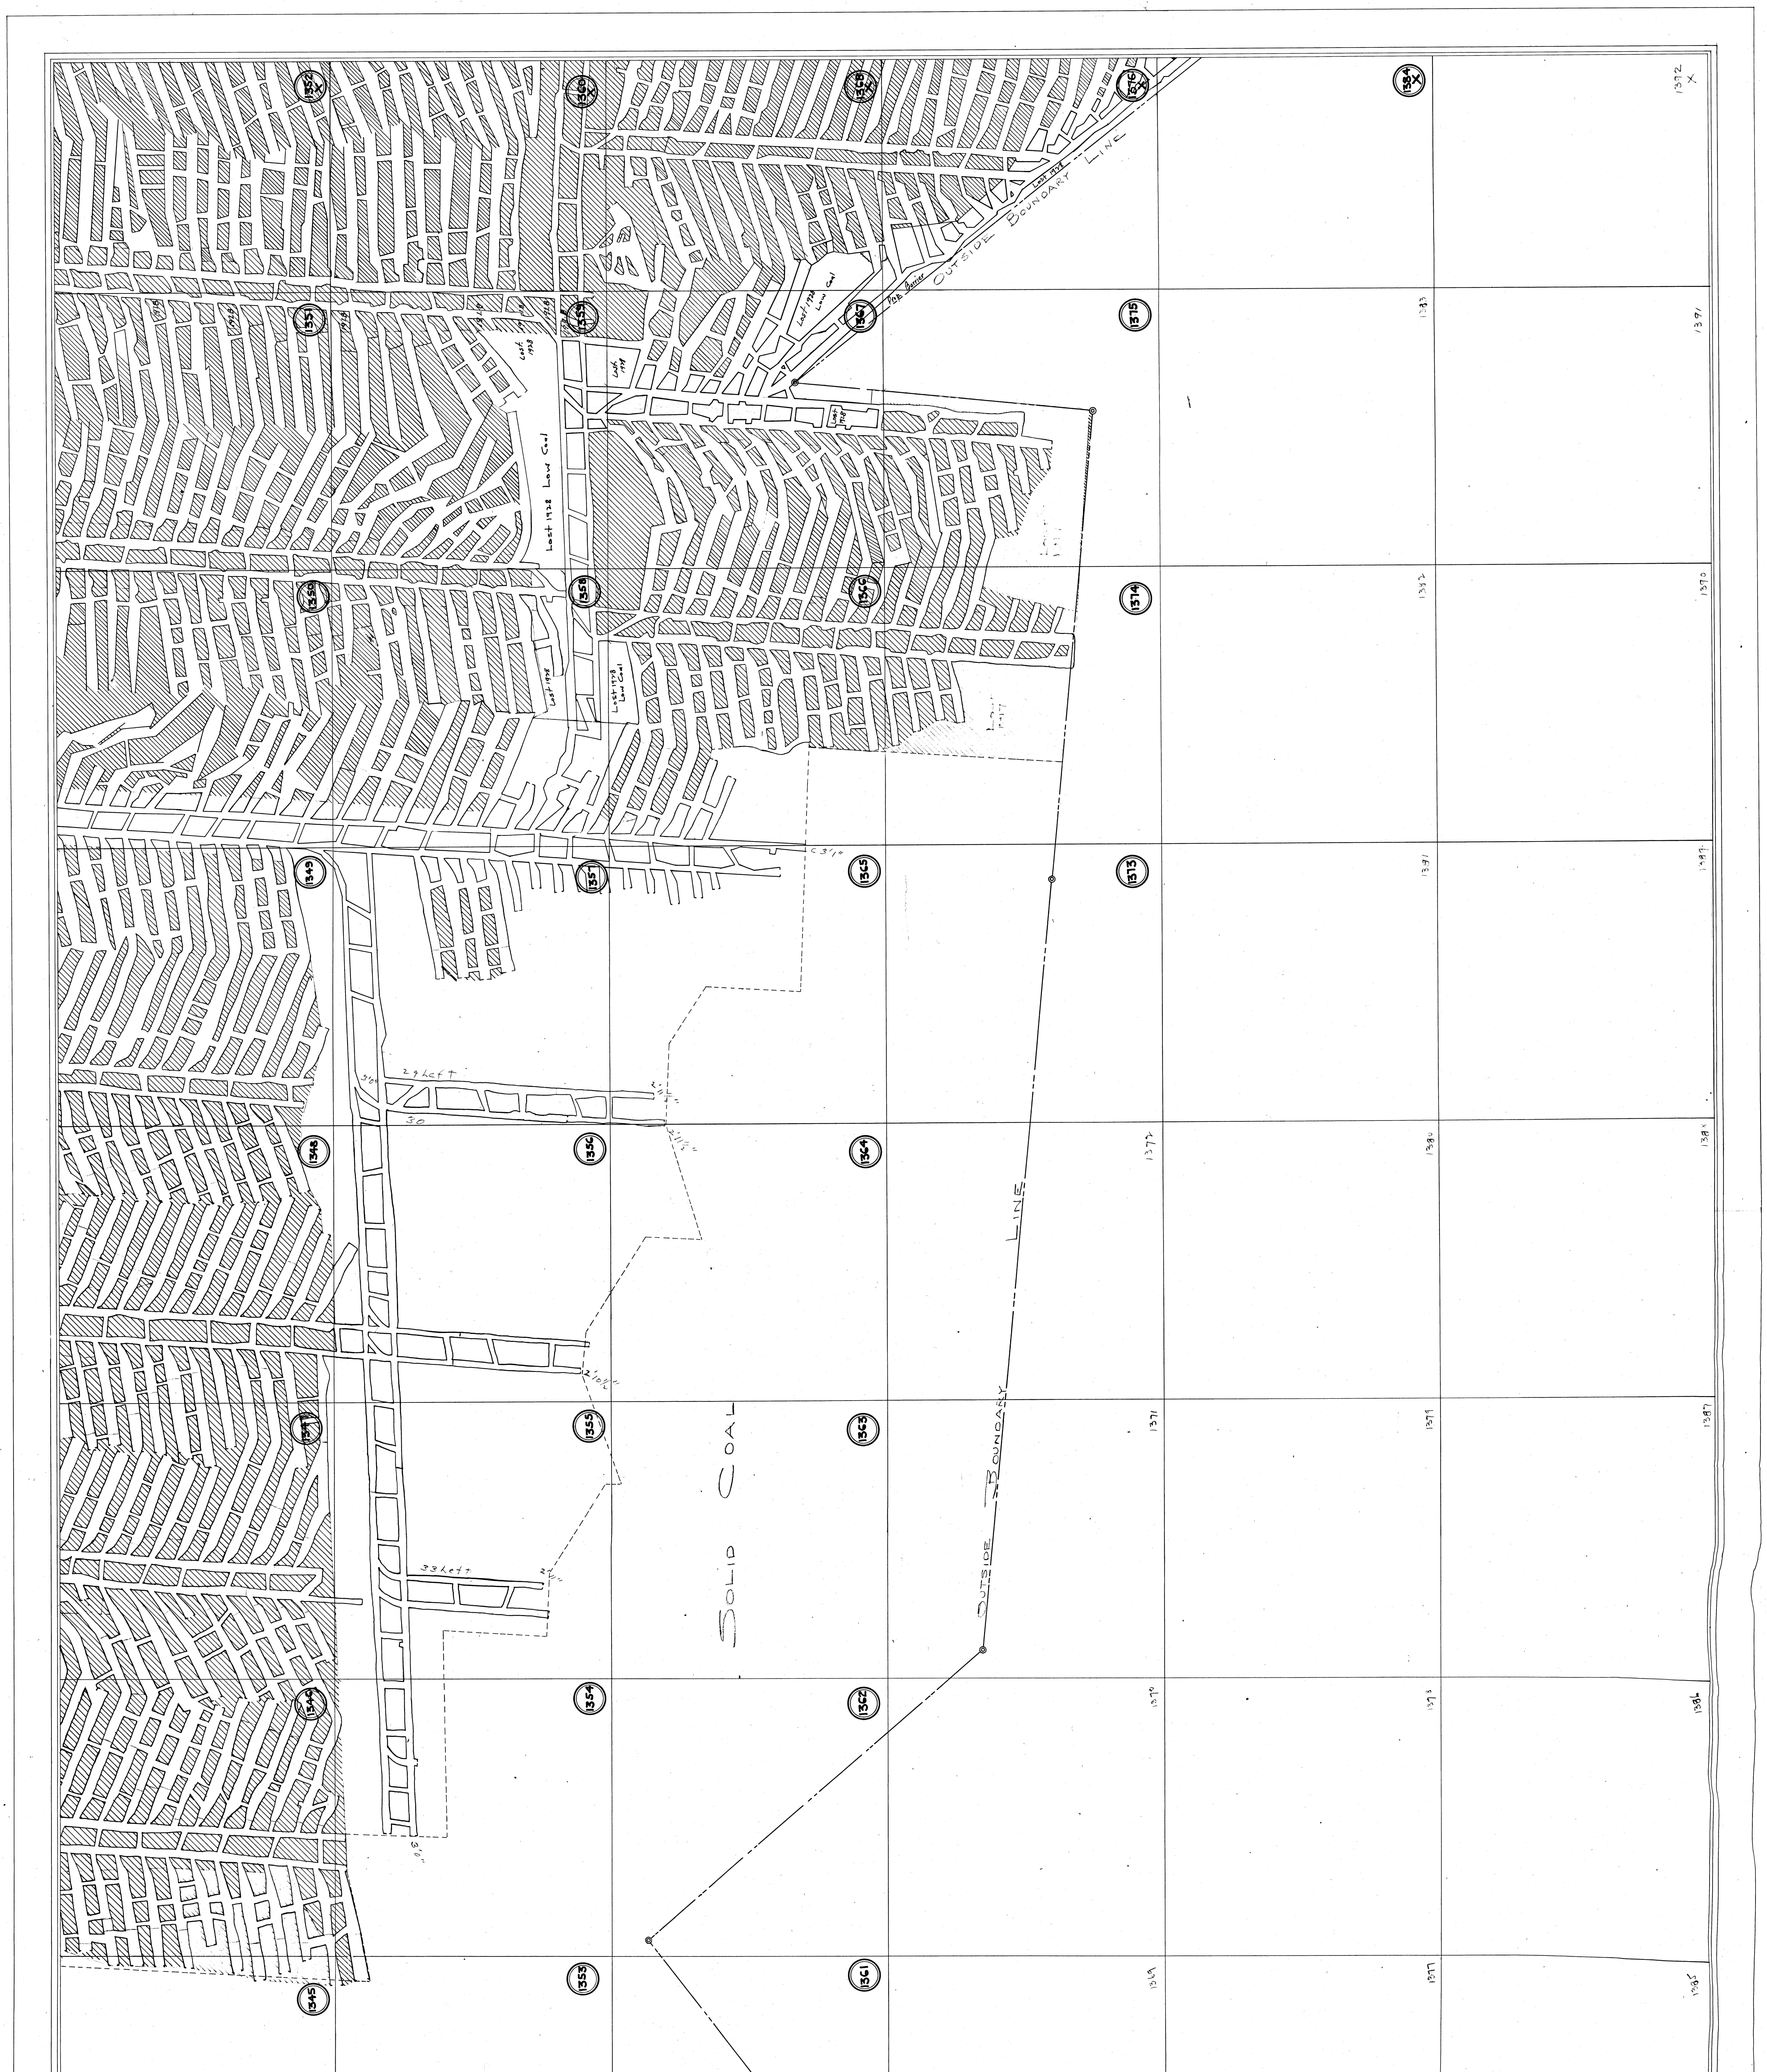
1352 X
1360 X
1368 X
1376 X
1384 X
1372 X
1351
1359
1367
1375
1383
1391
1350
1358
1366
1374
1382
1390
1349
1357
1365
1373
1381
1389
1348
1356
1364
1372
1380
1388
1347
1355
1363
1371
1379
1387
1346
1354
1362
1370
1378
1386
1345
1353
1361
1369
1377
1385
1928
1928
1928
1928
1928
1928
1928
Lost 1928
Lost 1928
Lost 1928 Low Coal
Lost 1928
Lost 1928 Low Coal
Lost 1928
Lost 1928 Low Coal
Lost 1928
Lost 1928
Lost 1928
Prop. Barrier
Outside Boundary Line
Outside Boundary Line
Solid Coal
C 3'1"
24 Left
3'0"
30
2'1"
2'1½"
2'10½"
33 Left
2'1"
3'0"

No 29 – Working

Working No 29