


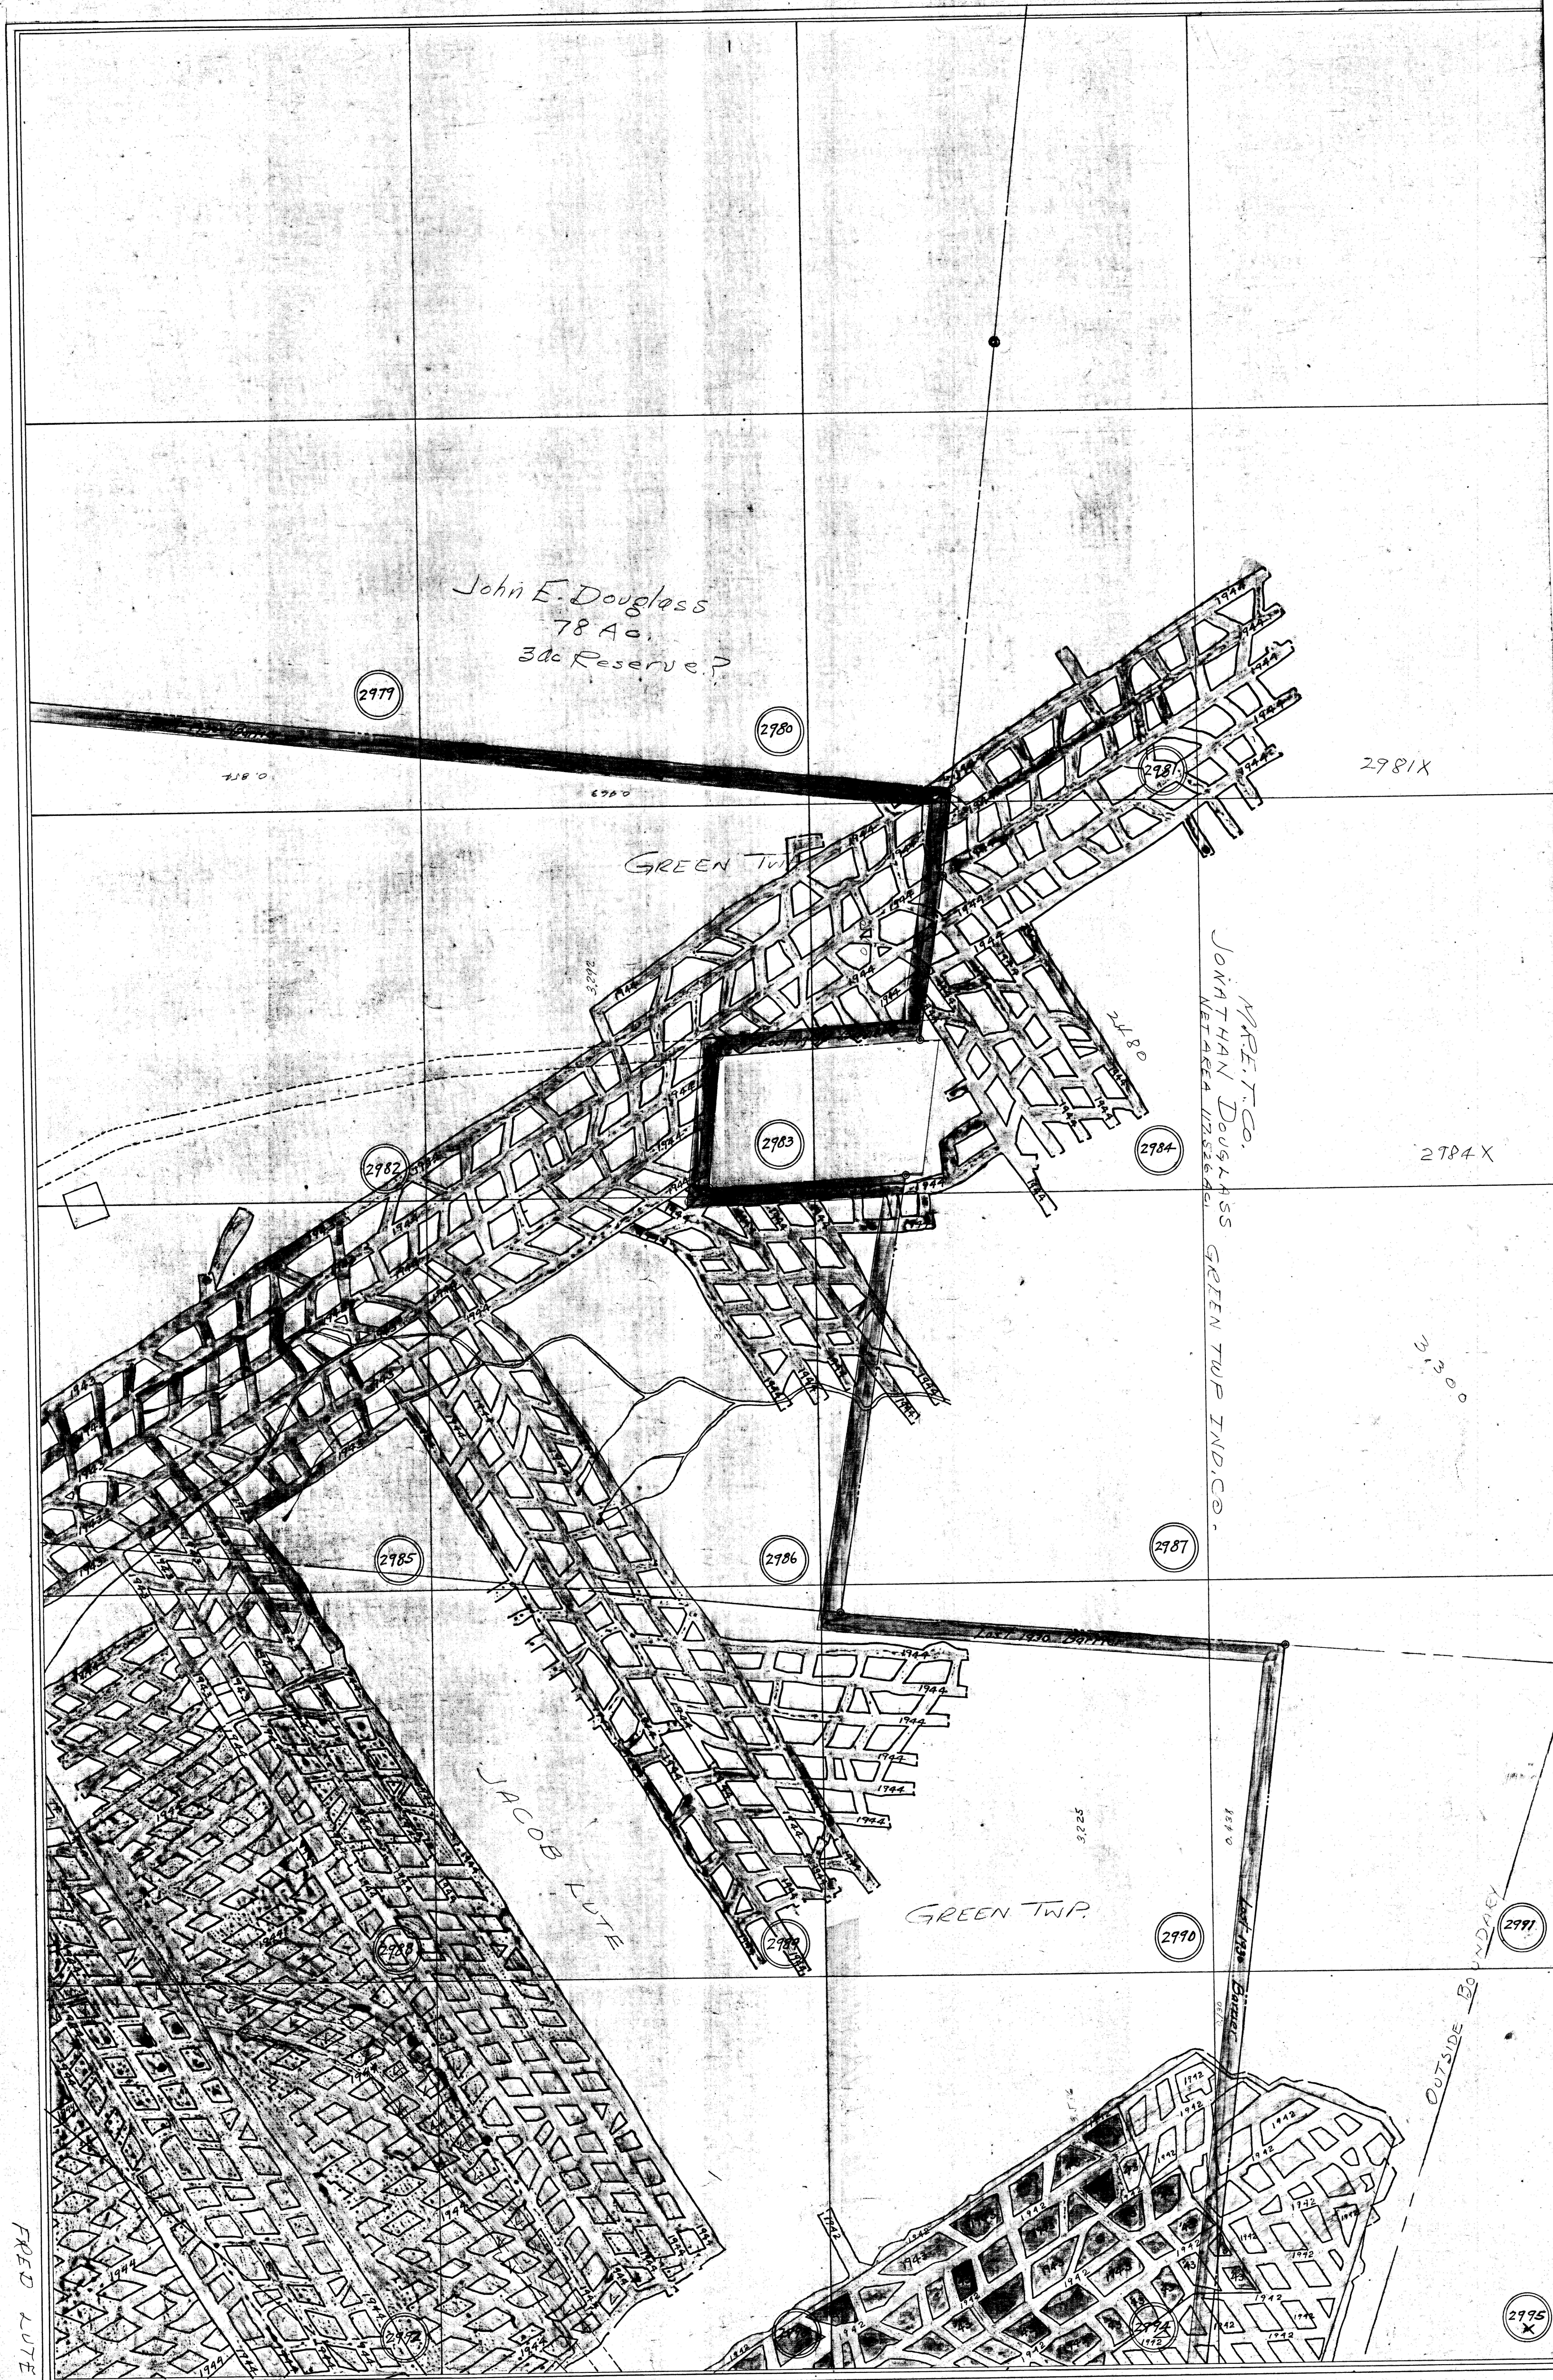

John E. Douglass
78 Ac.
300 Reserve?

GREEN TWP.

JACOB LUTE

GREEN TWP.

FRED LUTE

FRED LUTE

Bottom No. 68-Working Tracing

OUTSIDE BOUNDARY

