


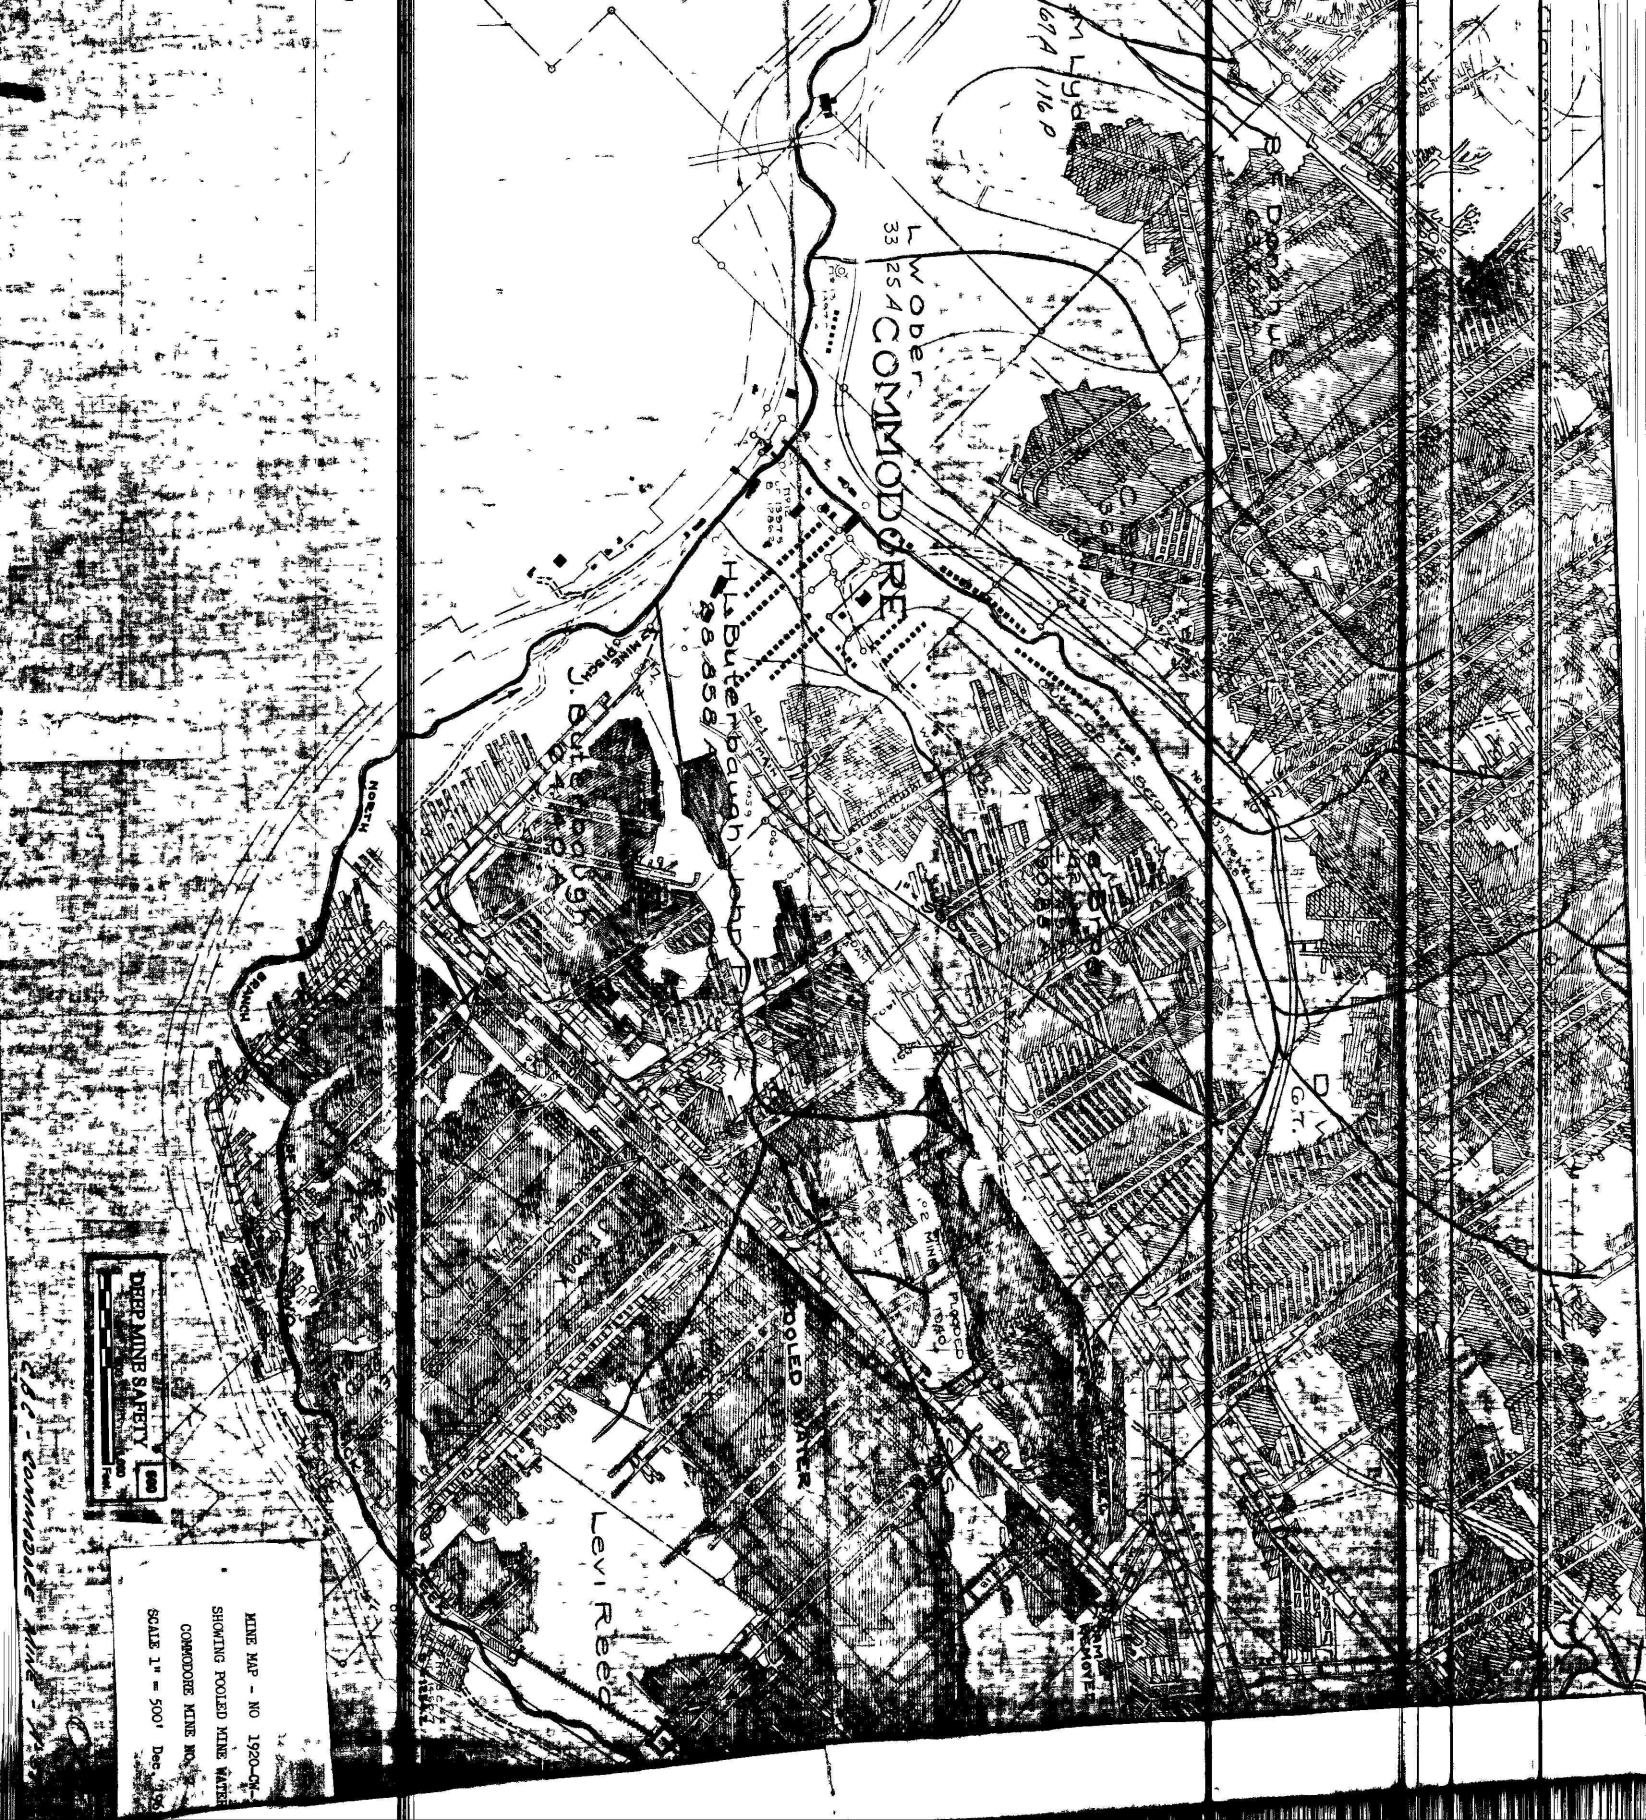

L WOODER
33 254 COMMODORE

H. B. Butenbaugh

Levi Reed

POLED JAMES

DEEP MINE SAFETY

MINE MAP - NO 1920-04
SHOWING POOLED MINE WATER
COMMODORE MINE NO. 33
SCALE 1" = 500' Dec 1920