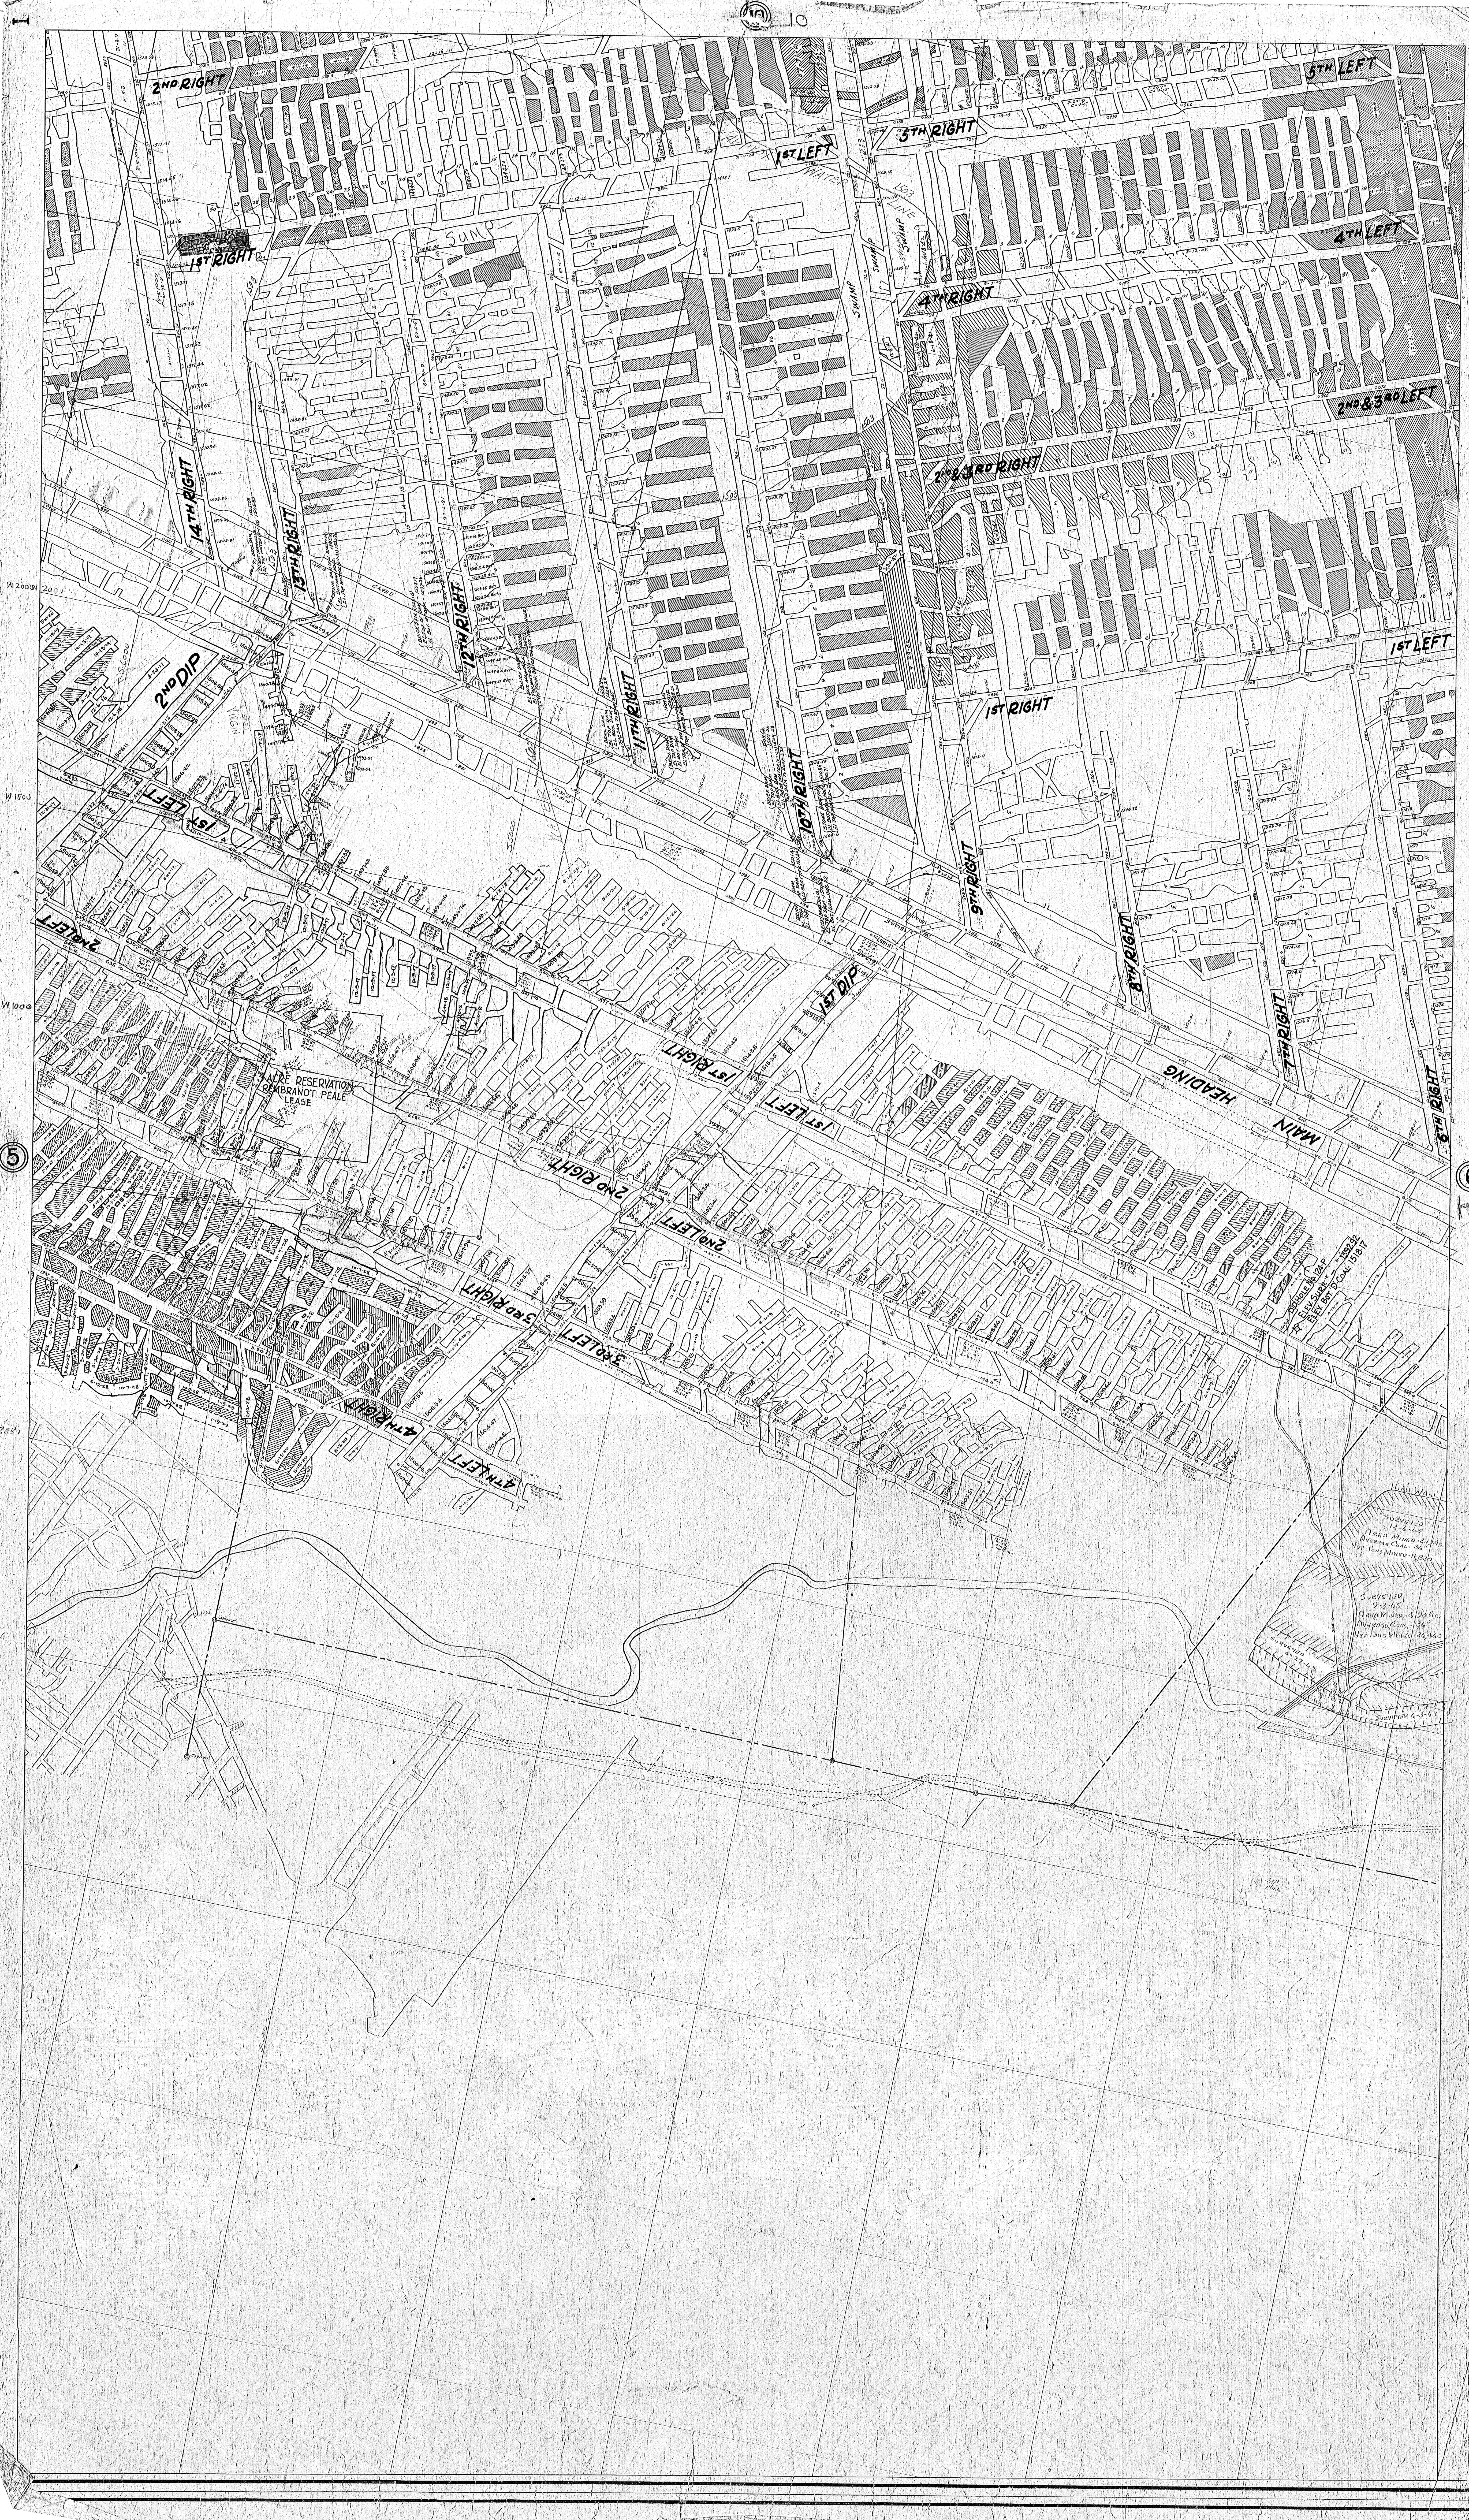⑤ 10
2ND RIGHT
1ST RIGHT
1ST LEFT
5TH RIGHT
5TH LEFT
4TH LEFT
4TH RIGHT
2ND & 3RD LEFT
2ND & 3RD RIGHT
SUMP
14TH RIGHT
13TH RIGHT
12TH RIGHT
11TH RIGHT
10TH RIGHT
9TH RIGHT
8TH RIGHT
7TH RIGHT
6TH RIGHT
1ST LEFT
1ST RIGHT
2ND DIP
1ST LEFT
2ND LEFT
1ST DIP
MAIN HEADING
3 ACRE RESERVATION
REMBRANDT PEALE
LEASE
1ST RIGHT
1ST LEFT
2ND RIGHT
2ND LEFT
3RD RIGHT
3RD LEFT
4TH RIGHT
4TH LEFT
⑤
⑥
HIGH WALL
SURVEYED 12-6-65
AREA MINED - 2.19 AC.
AVERAGE COAL - 36"
NET TONS MINED - 11,830
SURVEYED 9-3-65
AREA MINED - 4.90 AC.
AVERAGE COAL - 36"
NET TONS MINED - 26,460
SURVEYED 4-27-65
SURVEYED 6-3-65