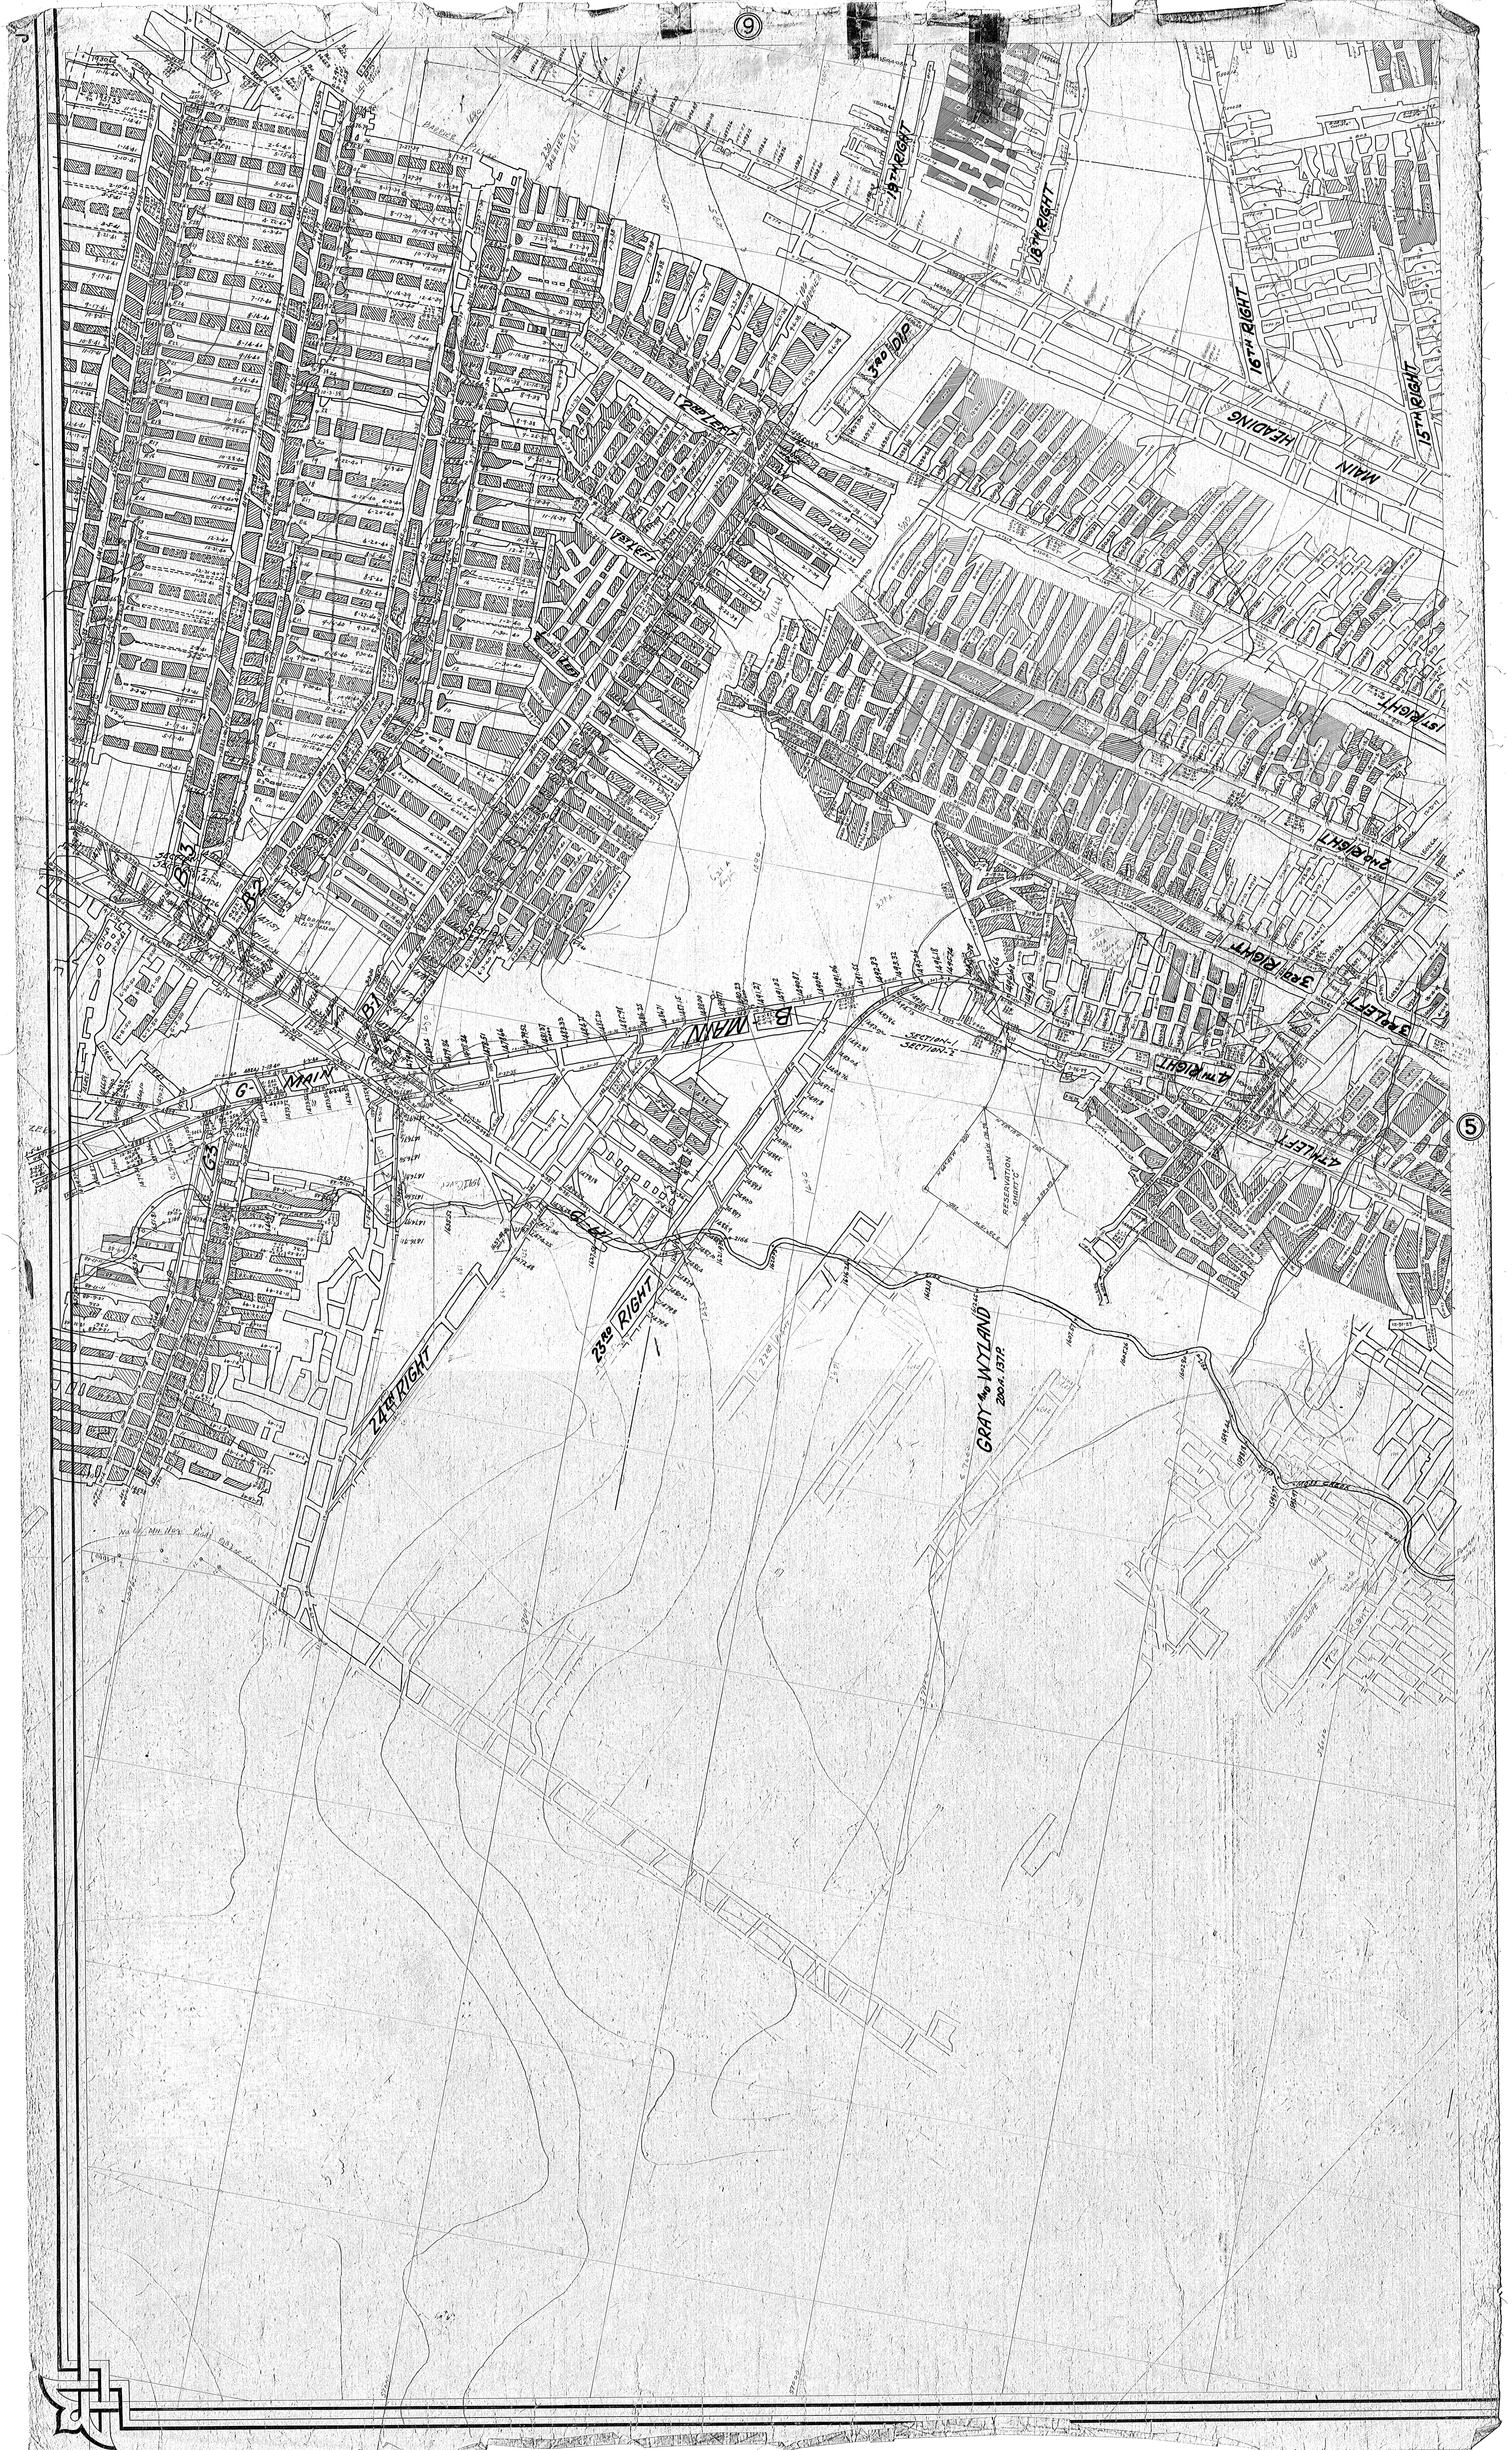
⑨
19TH RIGHT
18TH RIGHT
16TH RIGHT
15TH RIGHT
MAIN HEADING
3RD DIP
2ND LEFT
1ST LEFT
1ST RIGHT
2ND RIGHT
3RD RIGHT
3RD LEFT
4TH RIGHT
4TH LEFT
⑤
B3
B2
B1
B MAIN
G MAIN
G3
G B1
SECTION-1
SECTION-2
RESERVATION SHAFT "C"
N 25°.15' E 250.
S 64°.45' E
S 25°.15' W 250.
N 64°.45' W 250.
S 30°.15' W 176.78
23RD RIGHT
22ND RIGHT
24TH RIGHT
GRAY AND WYLAND
200 A. 137 P.