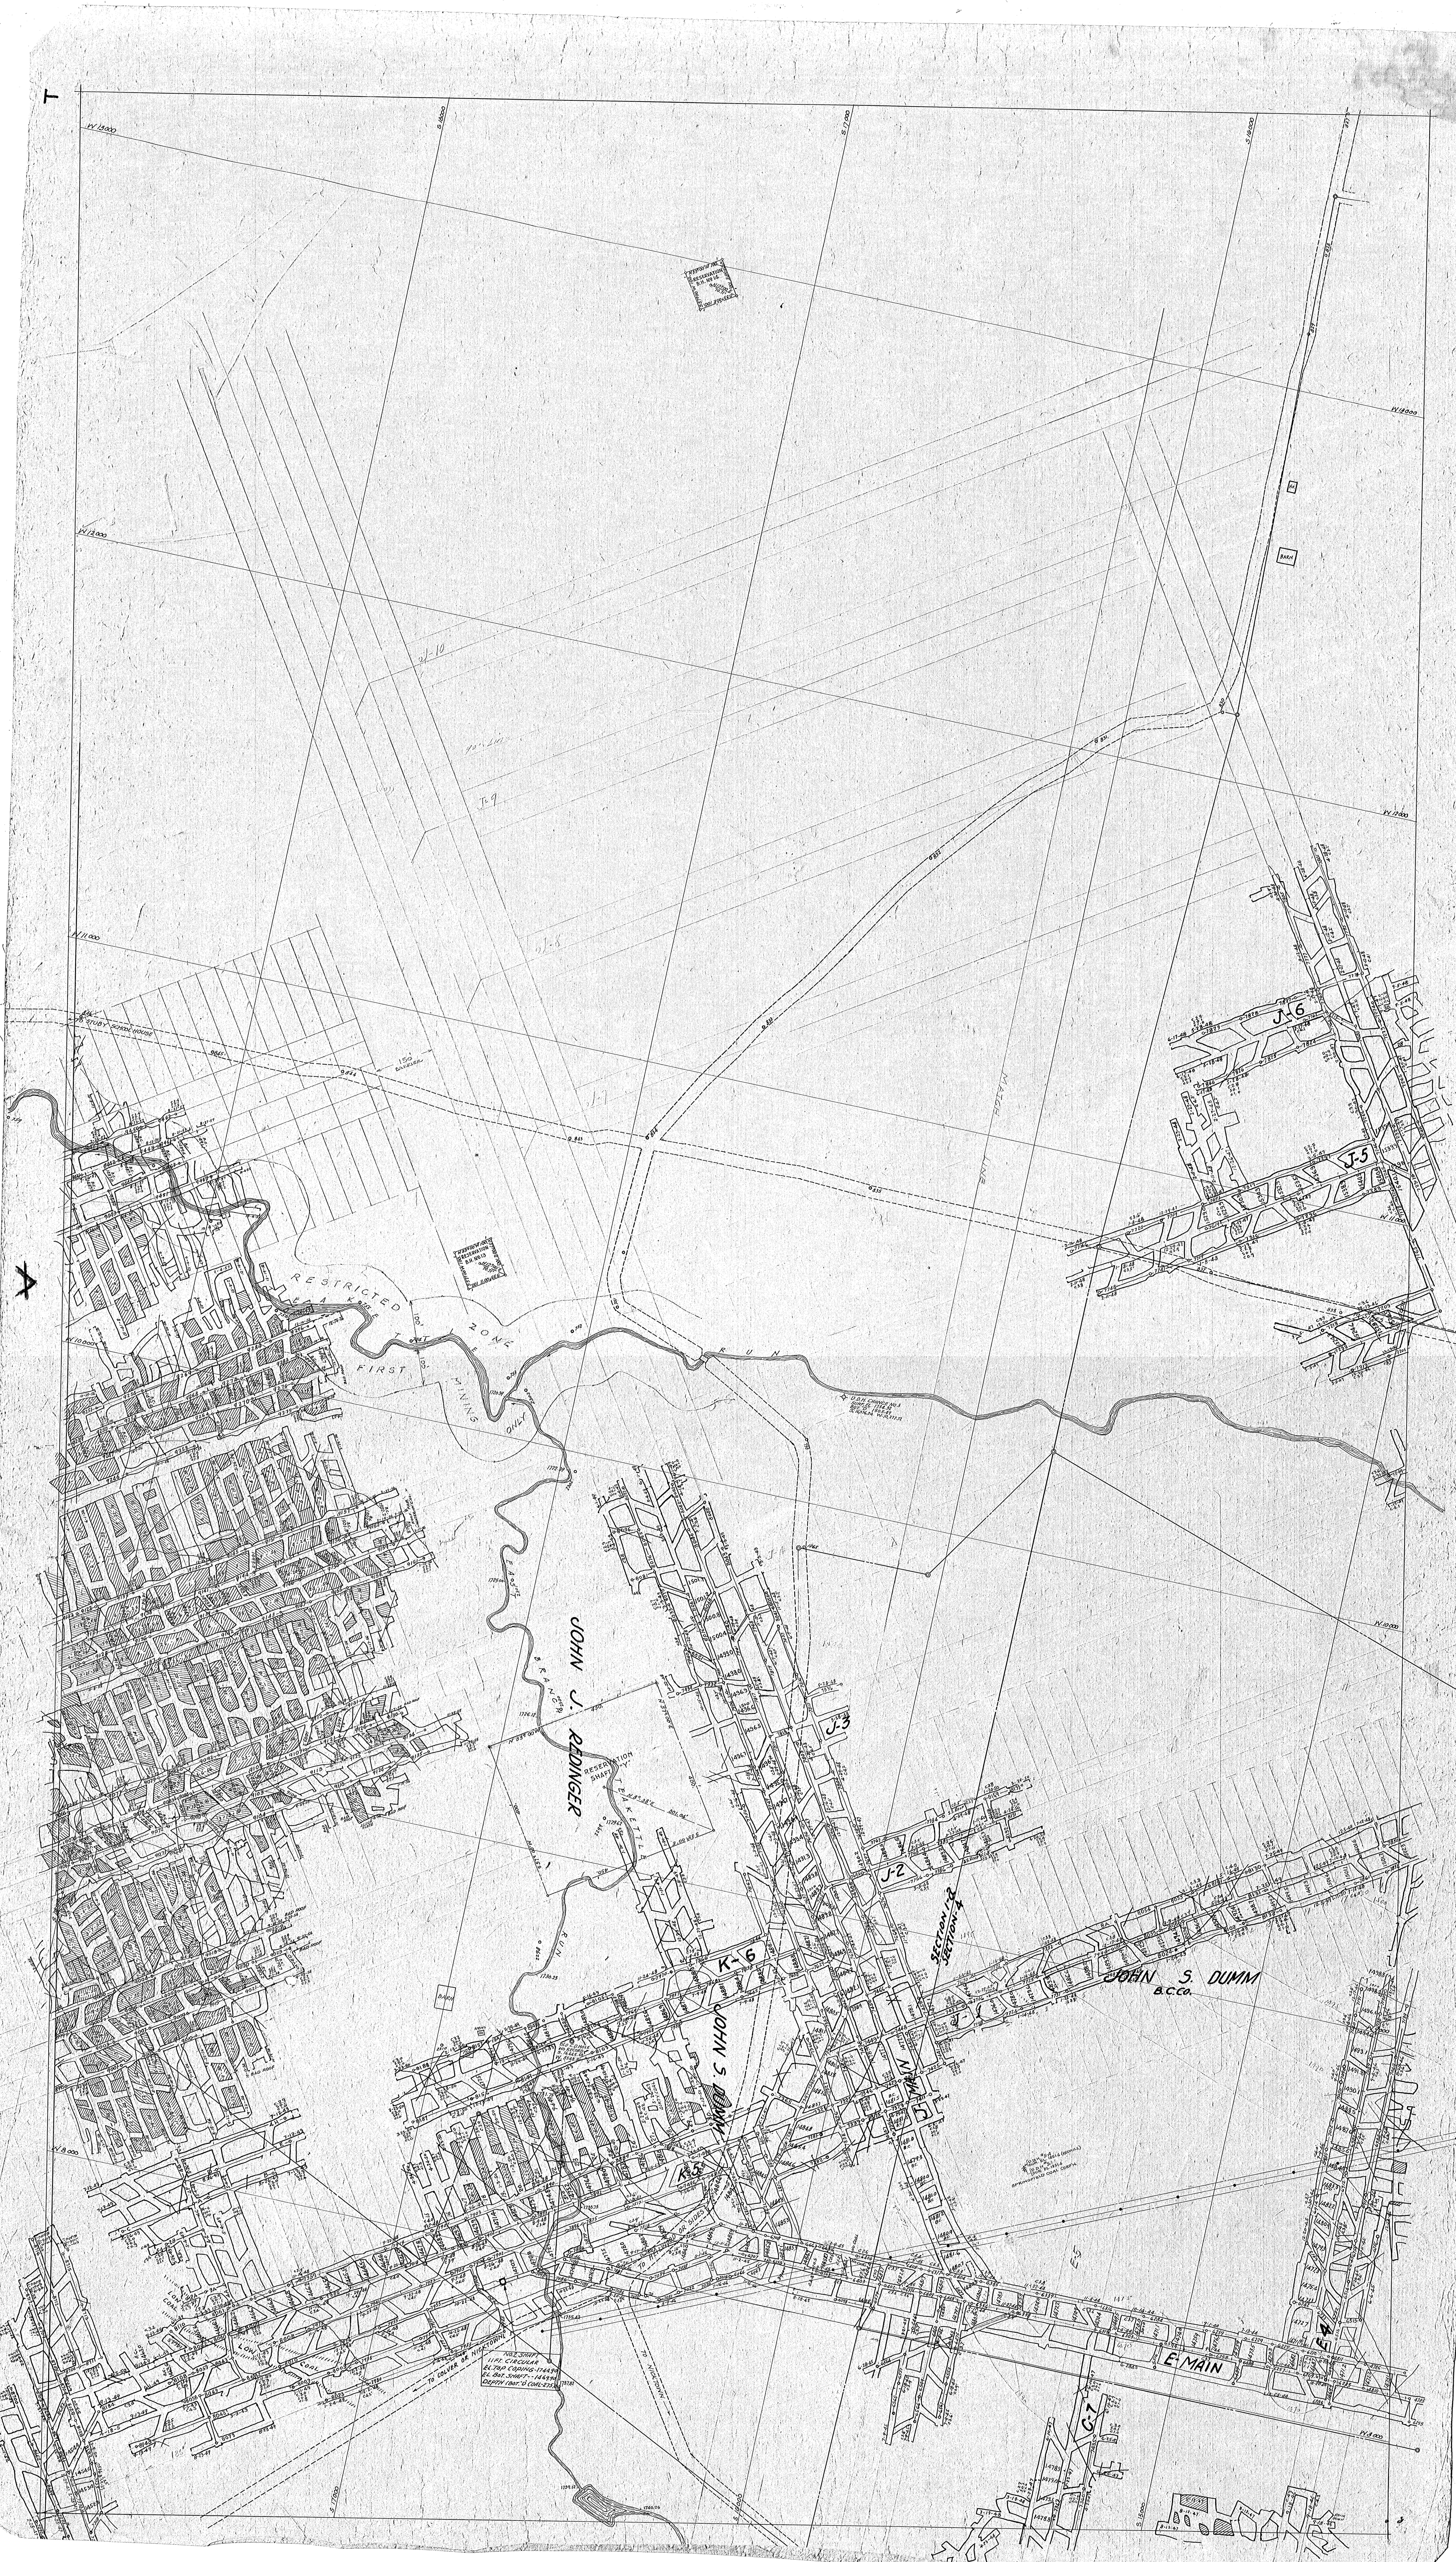
T
RESTRICTED ZONE
FIRST MINING ONLY
LAKE
RESERVATION B.H. No 13
J-6
J-5
J-3
J-2
JOHN J. REDINGER
RESERVATION SHAFT
K-6
K-5
JOHN S. DUMM
JOHN S. DUMM
B.C.Co.
SECTION 1-2
SECTION 4
D.D.H. #5-A SUR. EL. 1851.6 (REDRILL)
D.D.H. #5 SUR. EL. 1851.4
SPRINGFIELD COAL CORP'N.
E MAIN
E-4
C-7
BAD ROOF
RUN