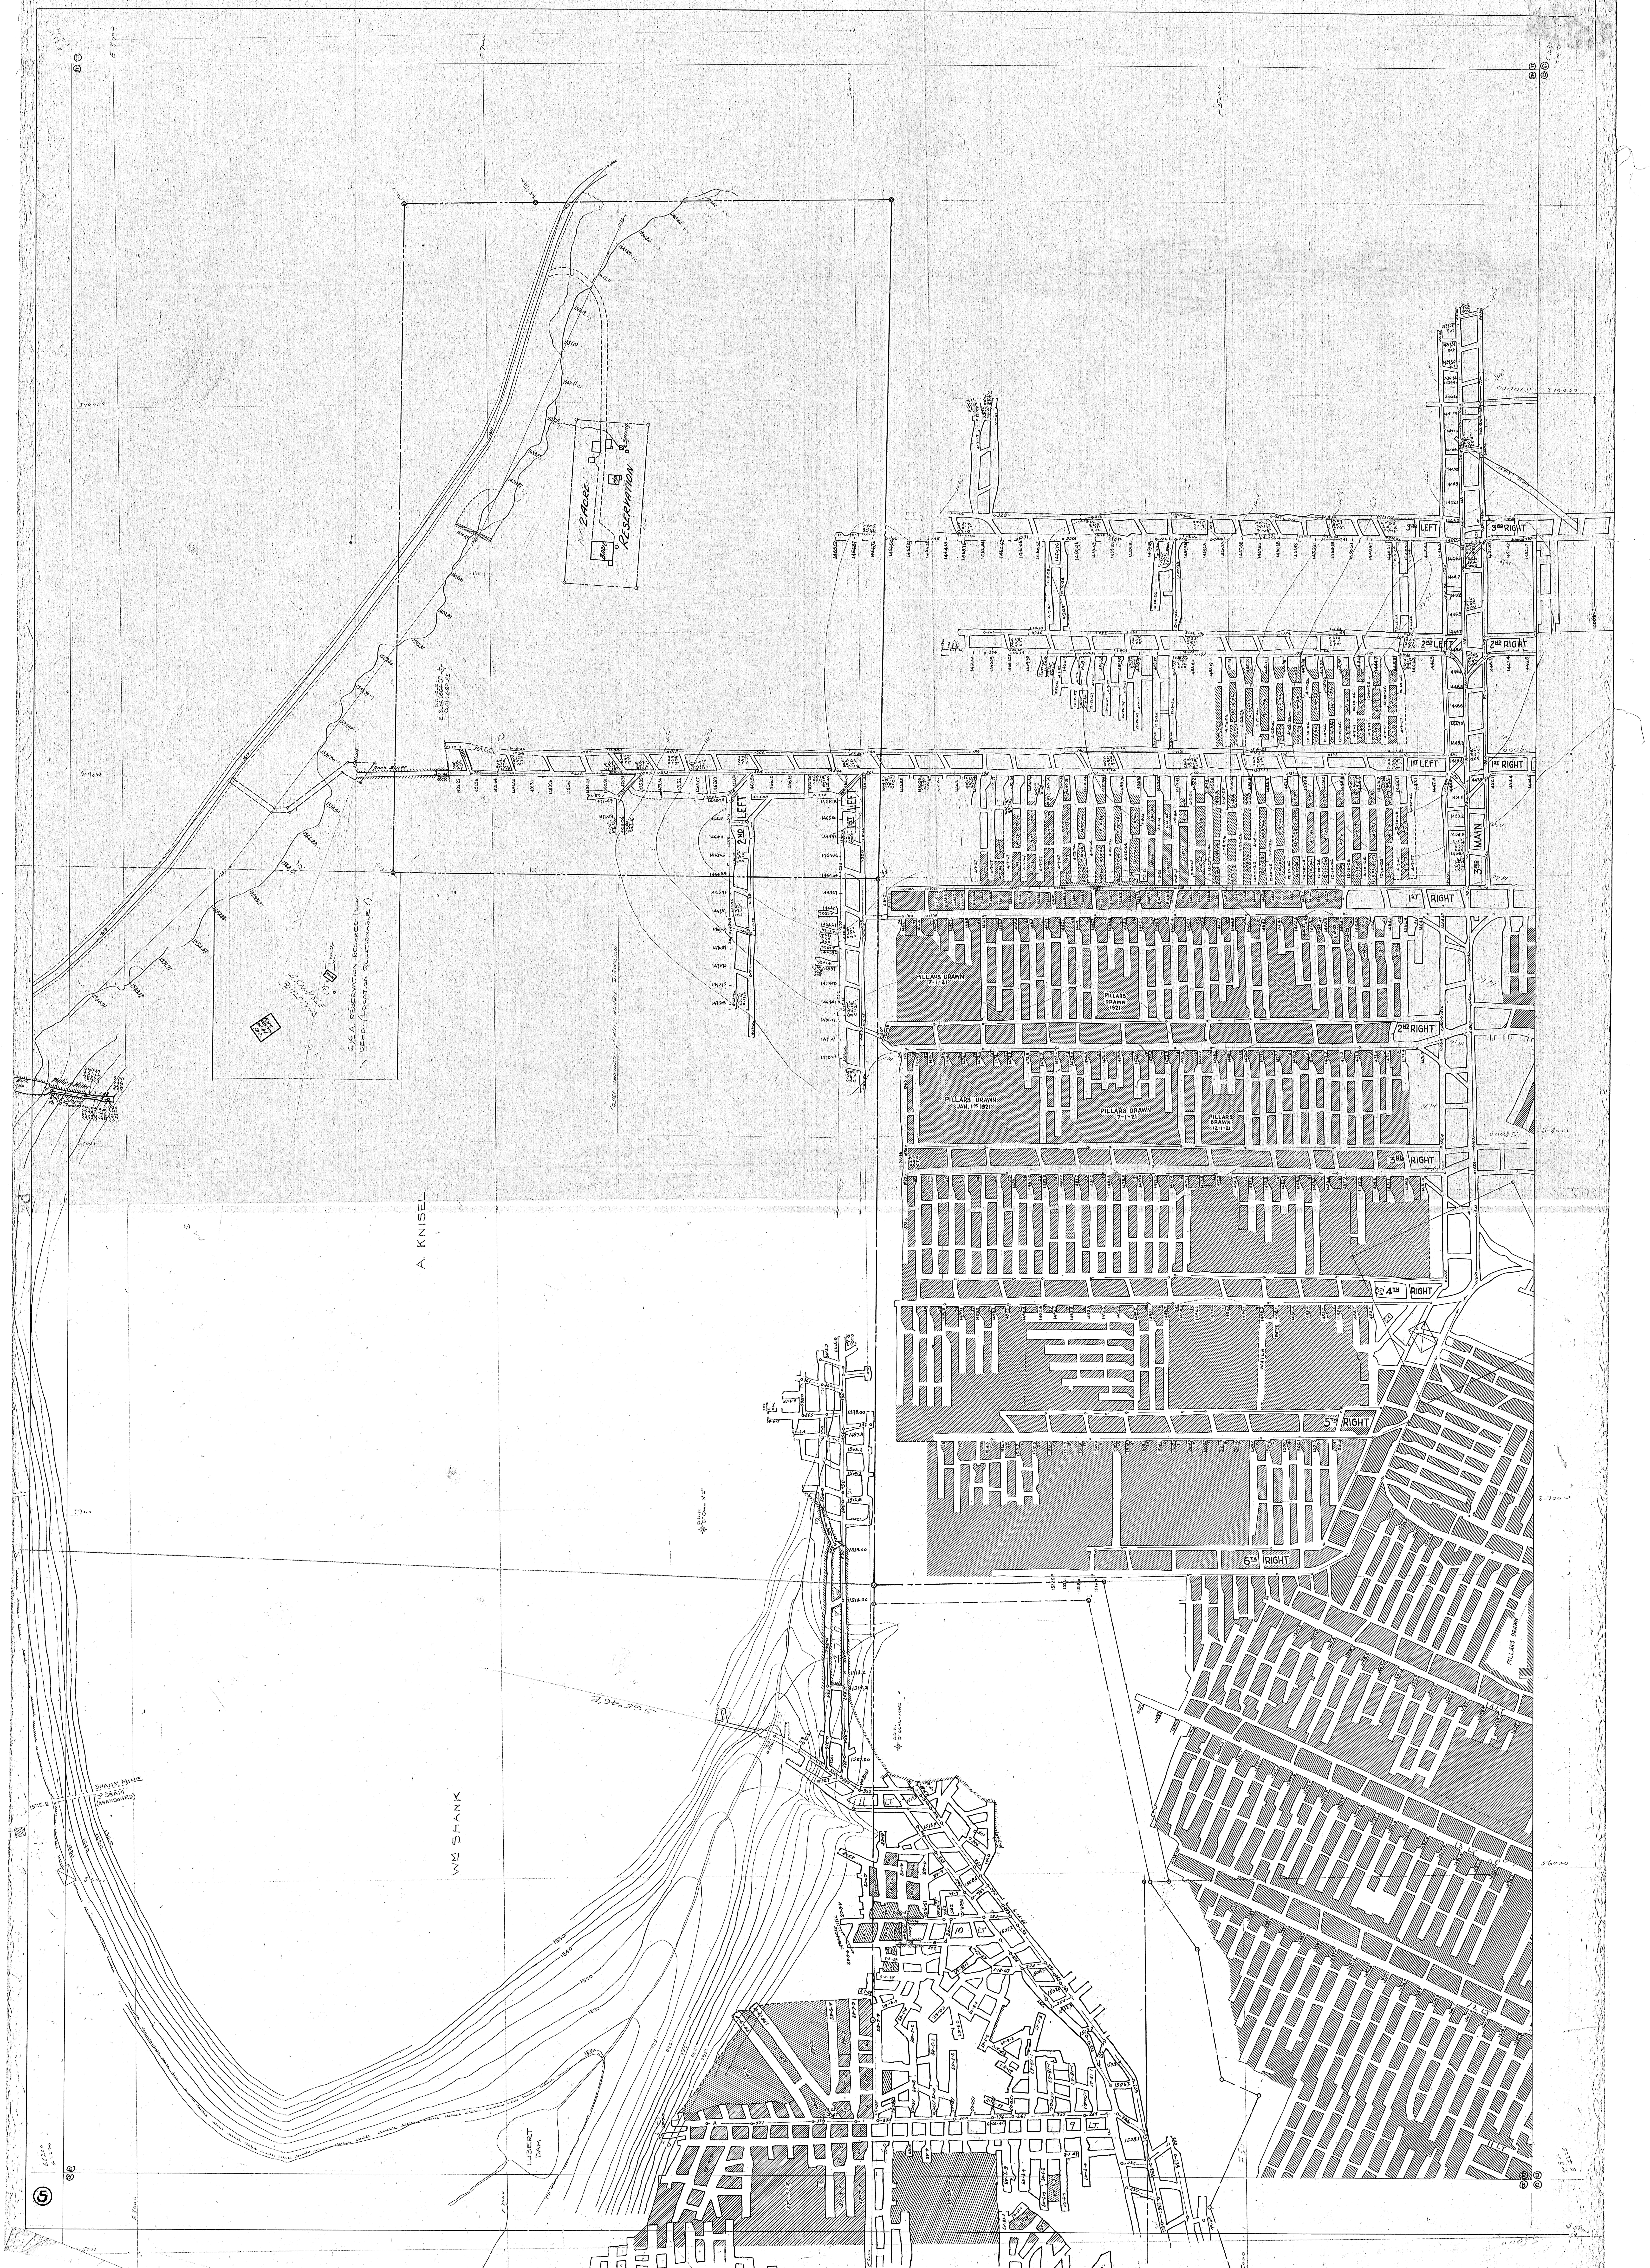2 ACRE RESERVATION
BARN
Spring
6½ A. RESERVATION RESERED FROM DEED. (LOCATION QUESTIONABLE ?)
House
Barn destroyed by Fire.
Rock SLOPE
A. KNISEL
WM SHANK
SHANK MINE "D" SEAM (ABANDONED)
1525.0
LUBERT DAM
E 7000
1510
1520
1530
1540
1550
1560
1st LEFT
2ND LEFT
3rd LEFT
2ND LEFT
1ST LEFT
MAIN
3RD
1st RIGHT
2ND RIGHT
3rd RIGHT
1ST RIGHT
2ND RIGHT
3RD RIGHT
4th RIGHT
5th RIGHT
6th RIGHT
PILLARS DRAWN 7-1-21
PILLARS DRAWN 1921
PILLARS DRAWN JAN. 1ST 1921
PILLARS DRAWN 7-1-21
PILLARS DRAWN 12-1-21
PILLARS DRAWN

⑤