


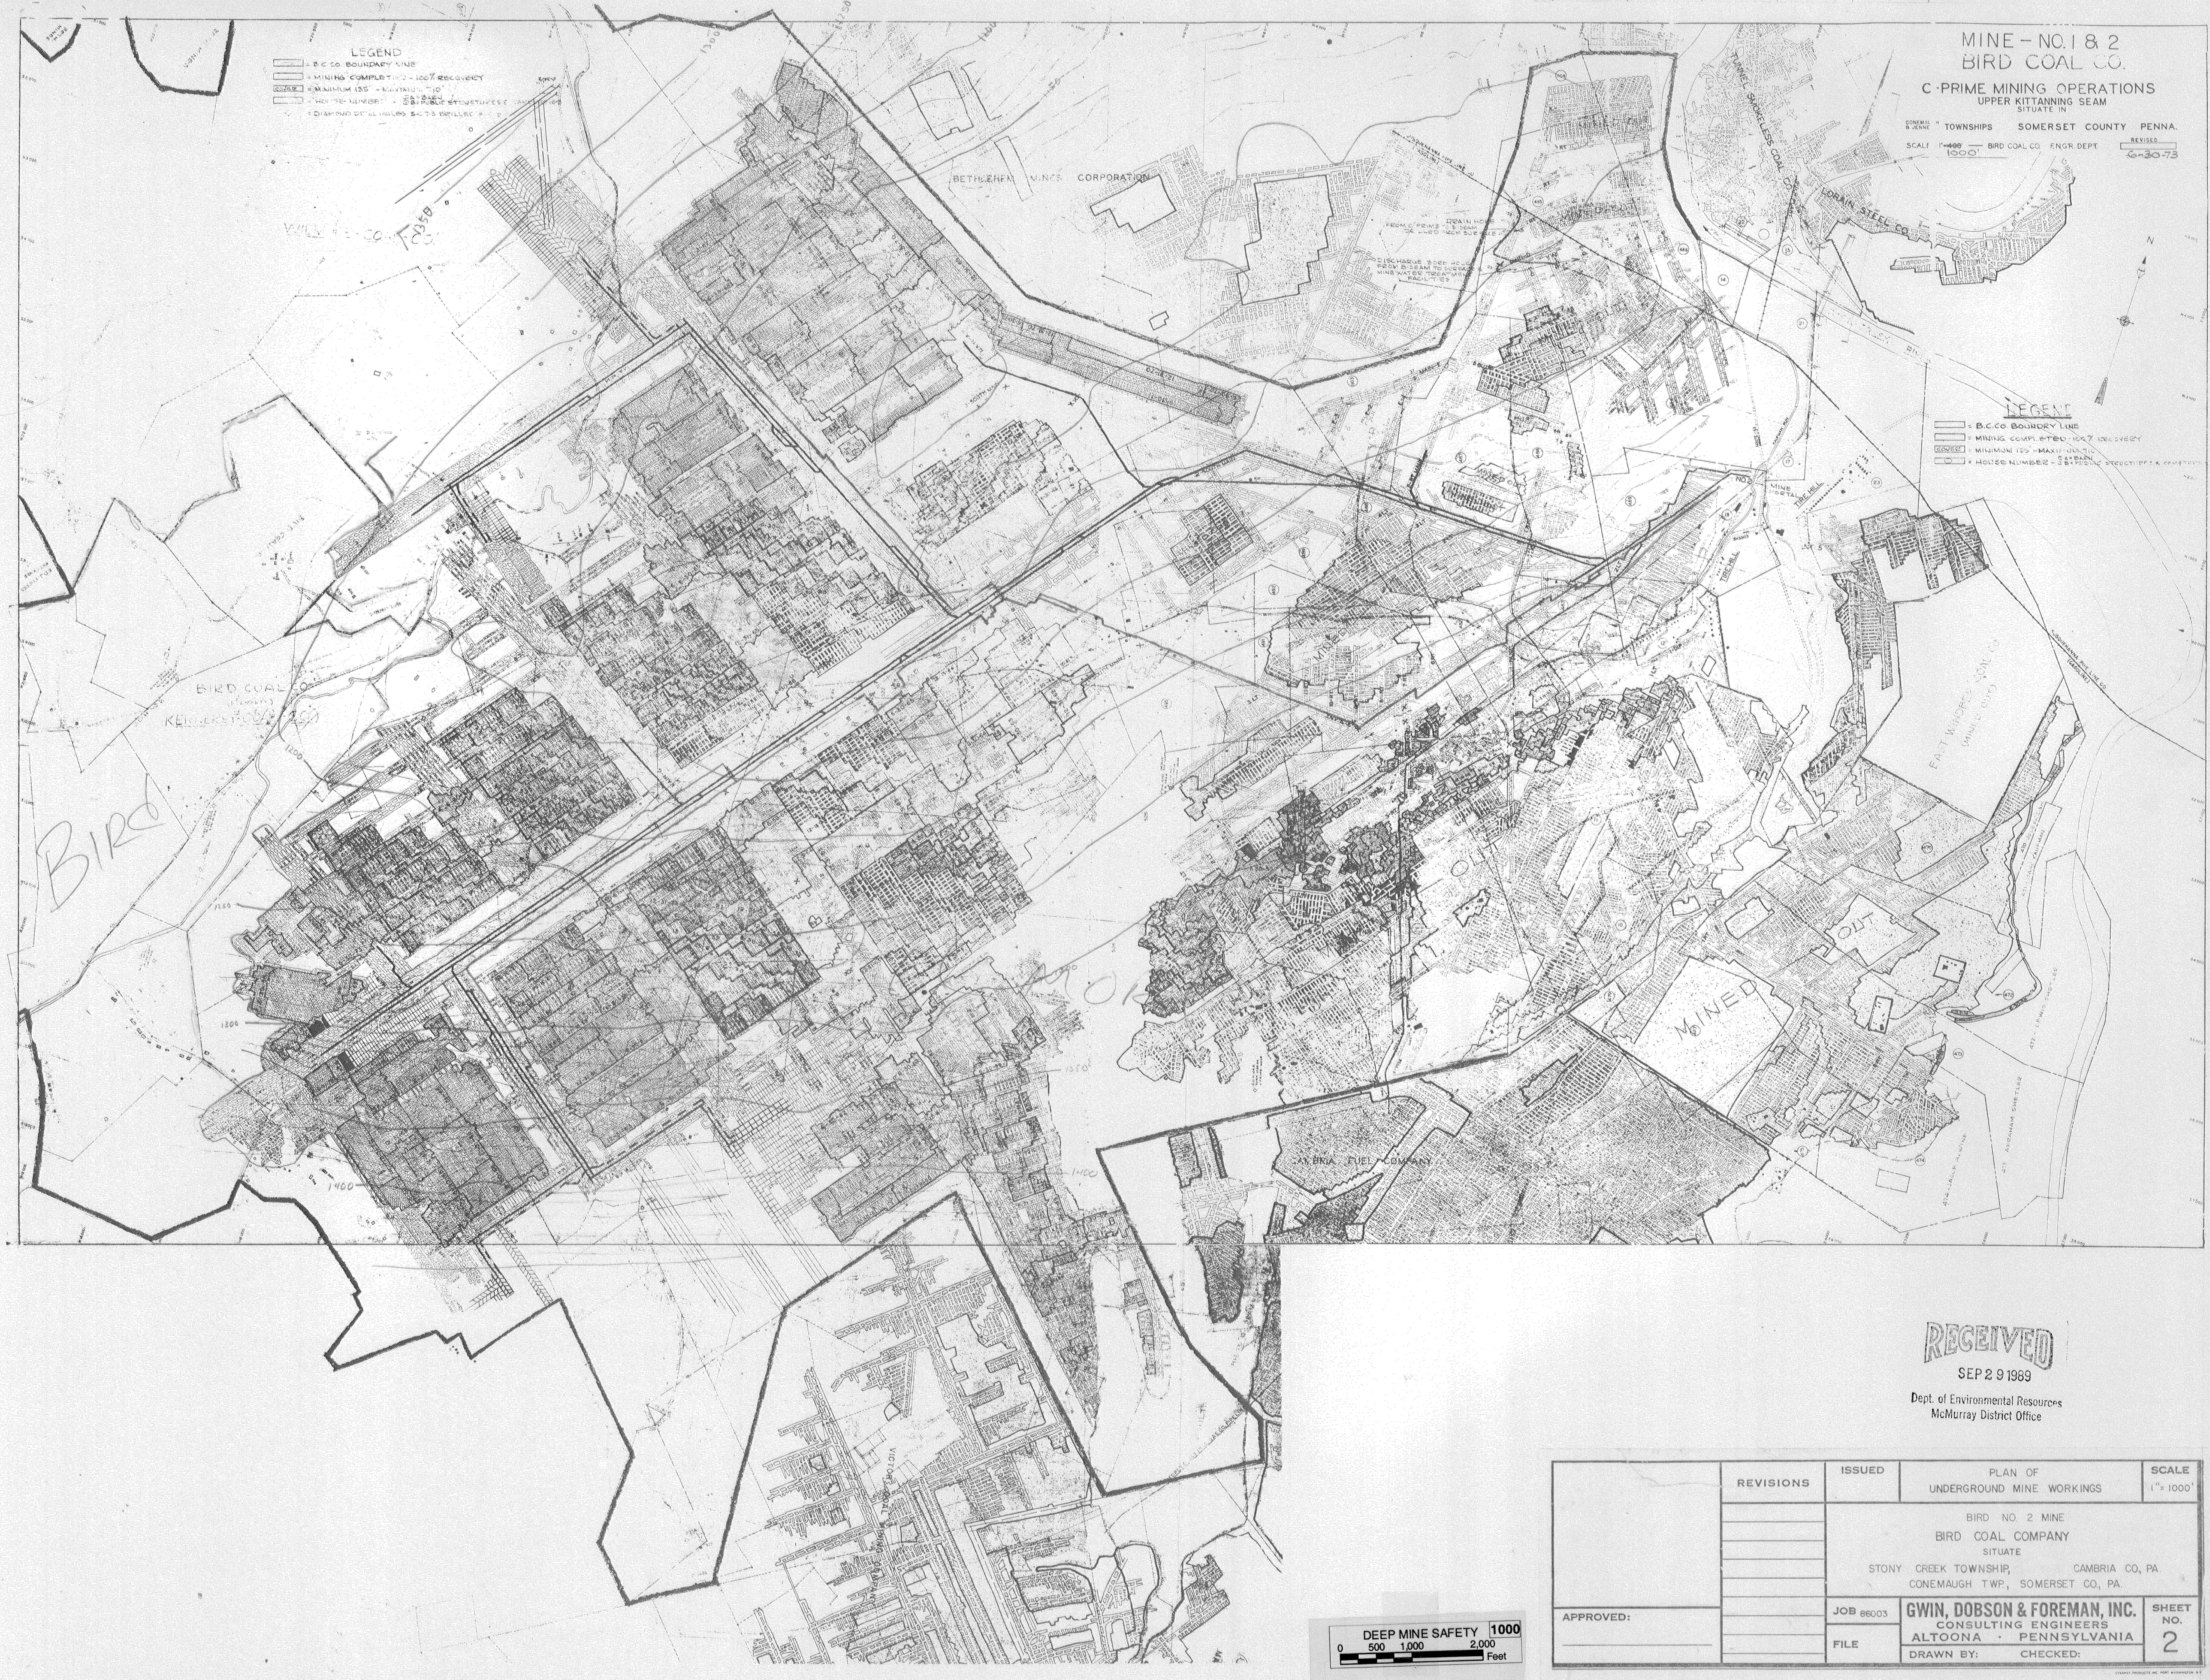

MINE - NO. 1 & 2
BIRD COAL CO.
C-PRIME MINING OPERATIONS
UPPER KITTINGING SEAM
SITUATE IN
TOWNSHIPS SOMERSET COUNTY PENNA.
SCALE 1"=400' BIRD COAL CO. ENGR. DEPT. REVISED 6-30-73

LEGEND
- B.C. CO. BOUNDARY LINE
- MINING COMPLETED - 100% RECOVERY
- MINING 100% MAX. 11% RECOVERY
- HOLE NUMBER - 10' DEEP

DEEP MINE SAFETY 1000
0 500 1000 2000 Feet

RECEIVED
SEP 29 1989

Dept. of Environmental Resources
McMurray District Office

APPROVED:	REVISIONS	ISSUED	PLAN OF UNDERGROUND MINE WORKINGS	SCALE 1"=1000'
			BIRD NO. 2 MINE	
			BIRD COAL COMPANY	
			SITUATE	
			STONY CREEK TOWNSHIP, CAMBRIA CO., PA. CONEMAUGH TWP., SOMERSET CO., PA.	
	JOB 86003	GWIN, DOBSON & FOREMAN, INC.	SHEET NO. 2	
	FILE	ALTOONA, PENNSYLVANIA		
		DRAWN BY:	CHECKED:	