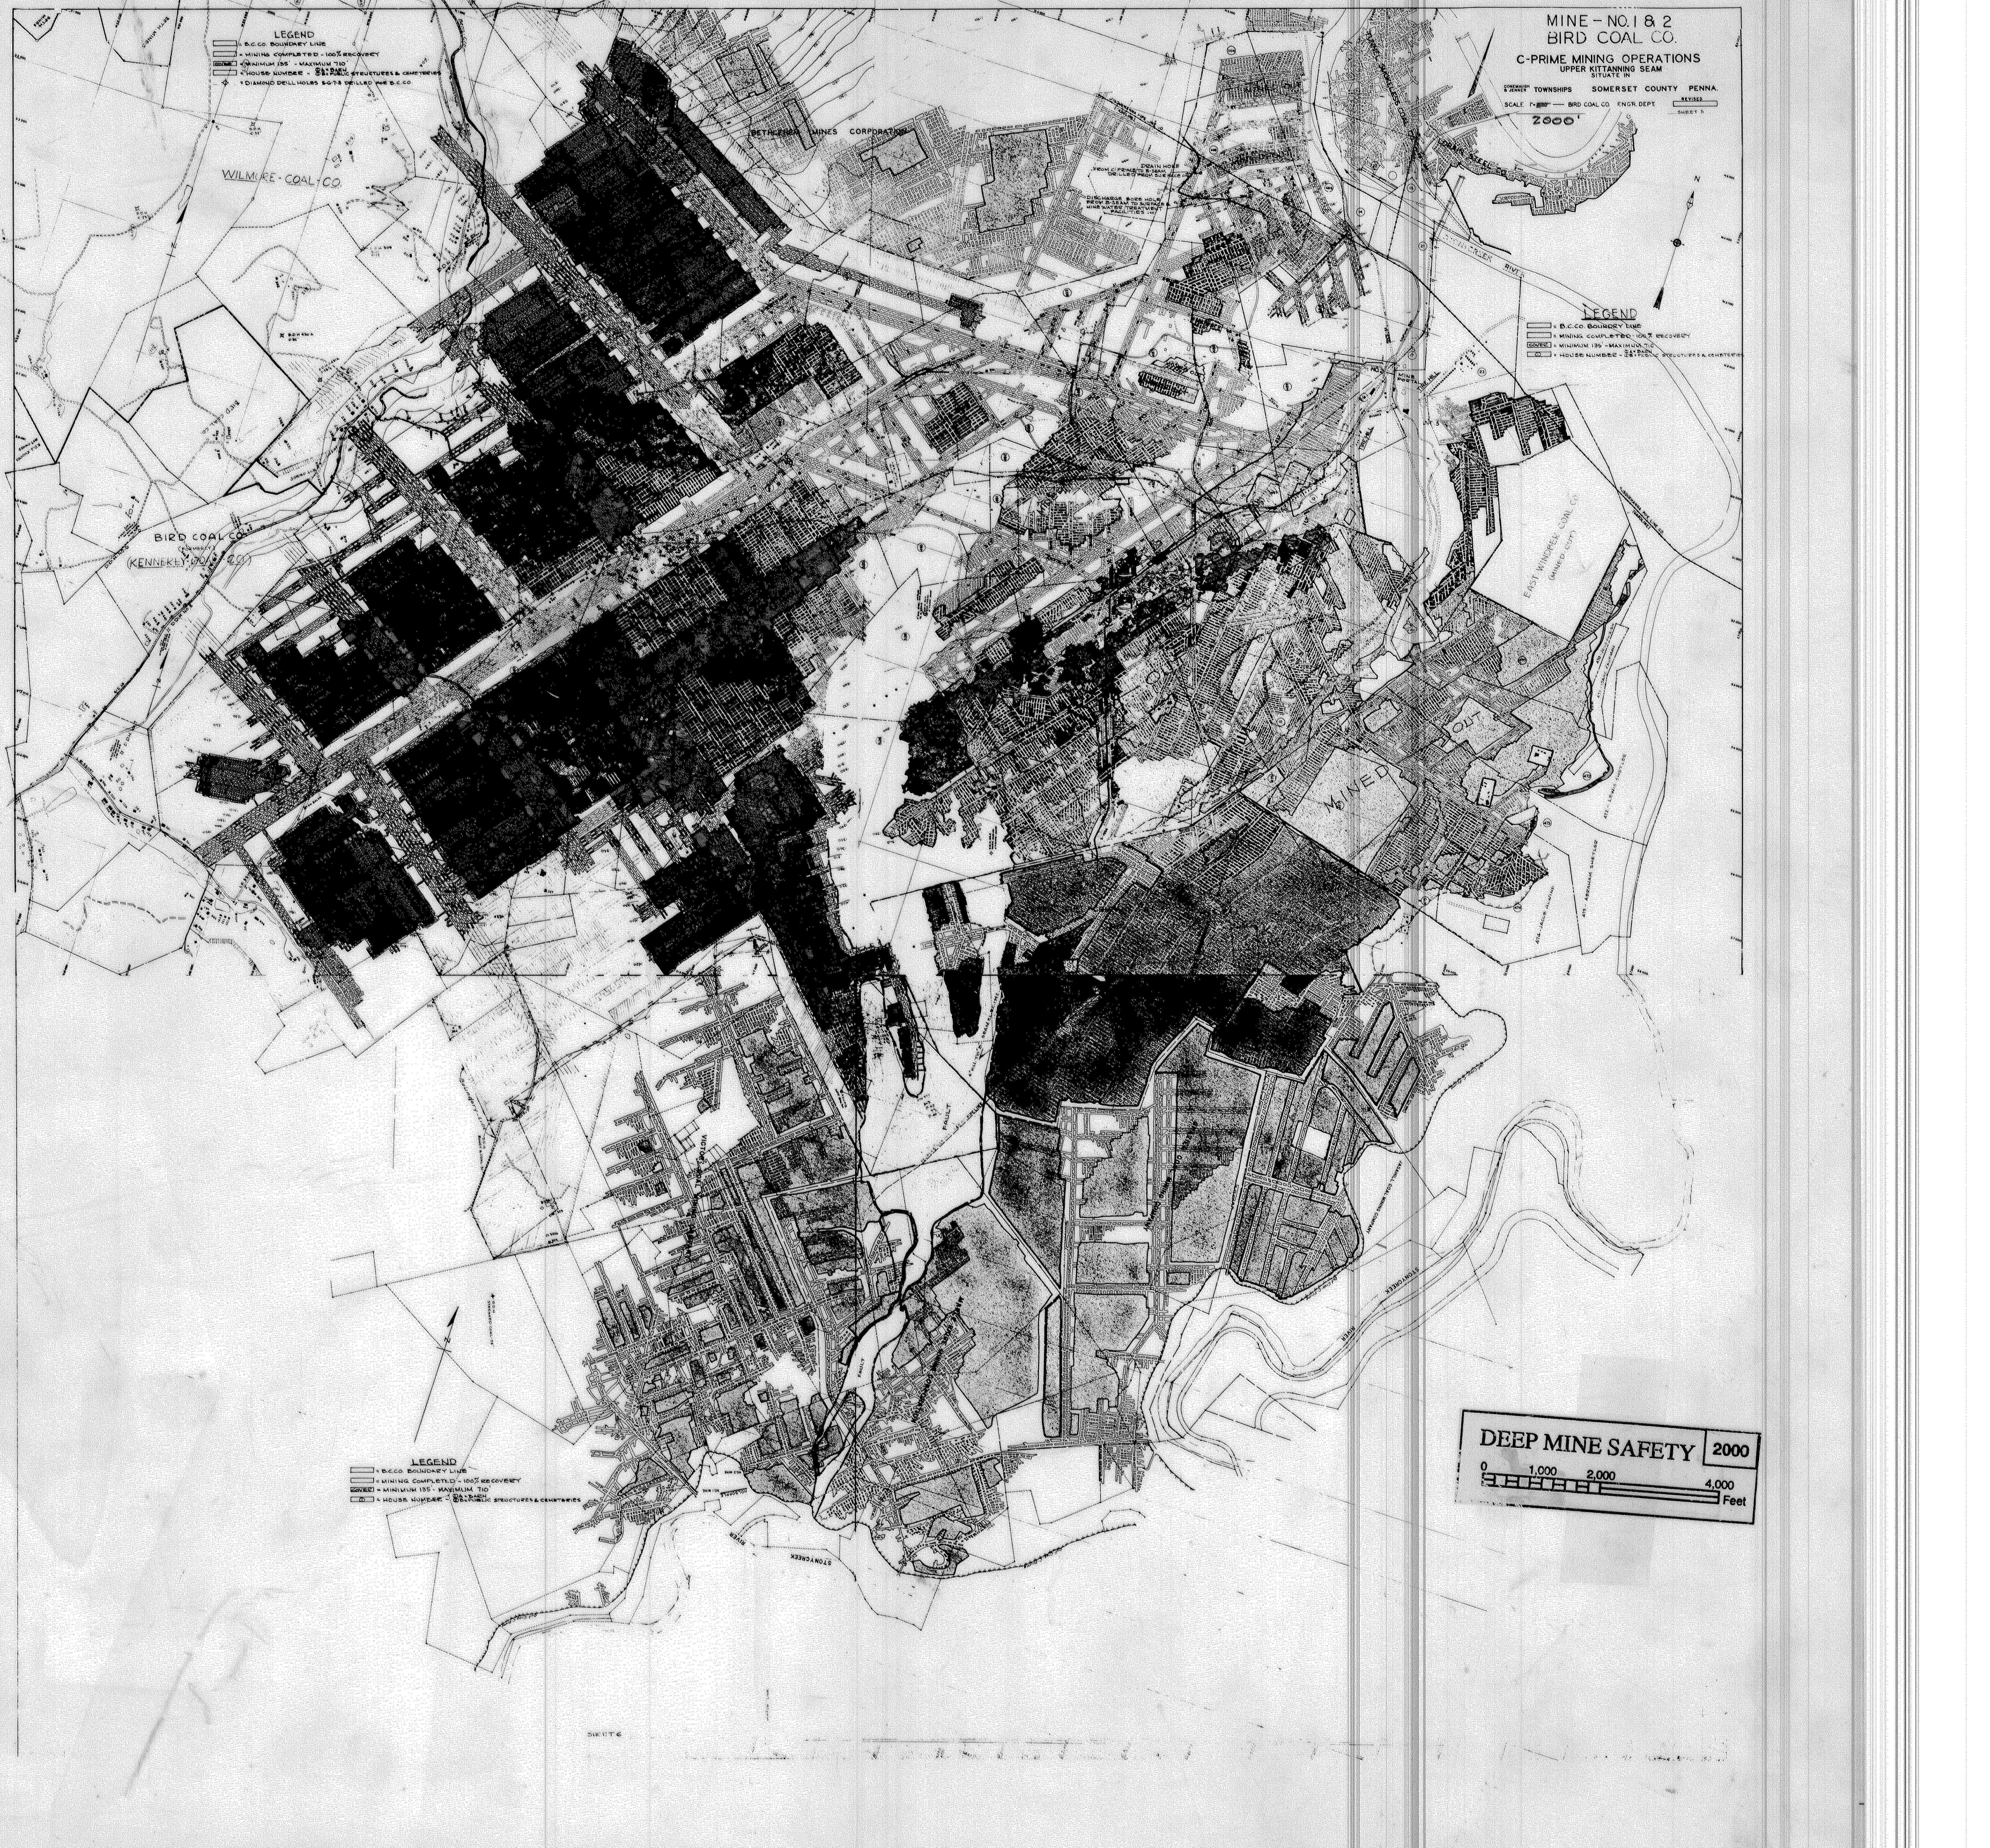
MINE - NO. 1 & 2
BIRD COAL CO.
C-PRIME MINING OPERATIONS
UPPER KITTANNING SEAM
SITUATE IN
CONEMAUGH & JENNER TOWNSHIPS SOMERSET COUNTY PENNA.
SCALE 1" = 2000' — BIRD COAL CO. ENGR. DEPT.
REVISED
SHEET 5
LEGEND
= B.C.CO. BOUNDARY LINE
= MINING COMPLETED - 100% RECOVERY
COVER = MINIMUM 135' - MAXIMUM 710'
= HOUSE NUMBER - ⓐ = BARN ⓑ = PUBLIC STRUCTURES & CEMETERIES
= DIAMOND DRILL HOLES 5-6-7-8 DRILLED FOR B.C.CO.
WILMORE - COAL - CO.
BIRD COAL CO. (FORMERLY) (KENNERLY COAL CO.)
BETHLEHEM MINES CORPORATION
DRAIN HOLE FROM C-PRIME TO B-SEAM DRILLED FROM SURFACE
DISCHARGE BORE HOLE FROM B-SEAM TO SURFACE & MINE WATER TREATMENT FACILITIES
NO. 2 MINE PORTAL
TIRE HILL
STONYCREEK RIVER
LORAIN STEEL CO.
N
EAST WINDBER COAL CO. (MINED OUT)
MINED OUT
SUSQUEHANNA PIPE LINE CO. (GASOLINE)
472 - LEWIS SHETLER
473 - ABRAHAM SHETLER
474 - JACOB RUMMEL
FAULT
VICTOR
STONYCREEK RIVER
SHEET 6
DEEP MINE SAFETY
2000
0
1,000
2,000
4,000
Feet