


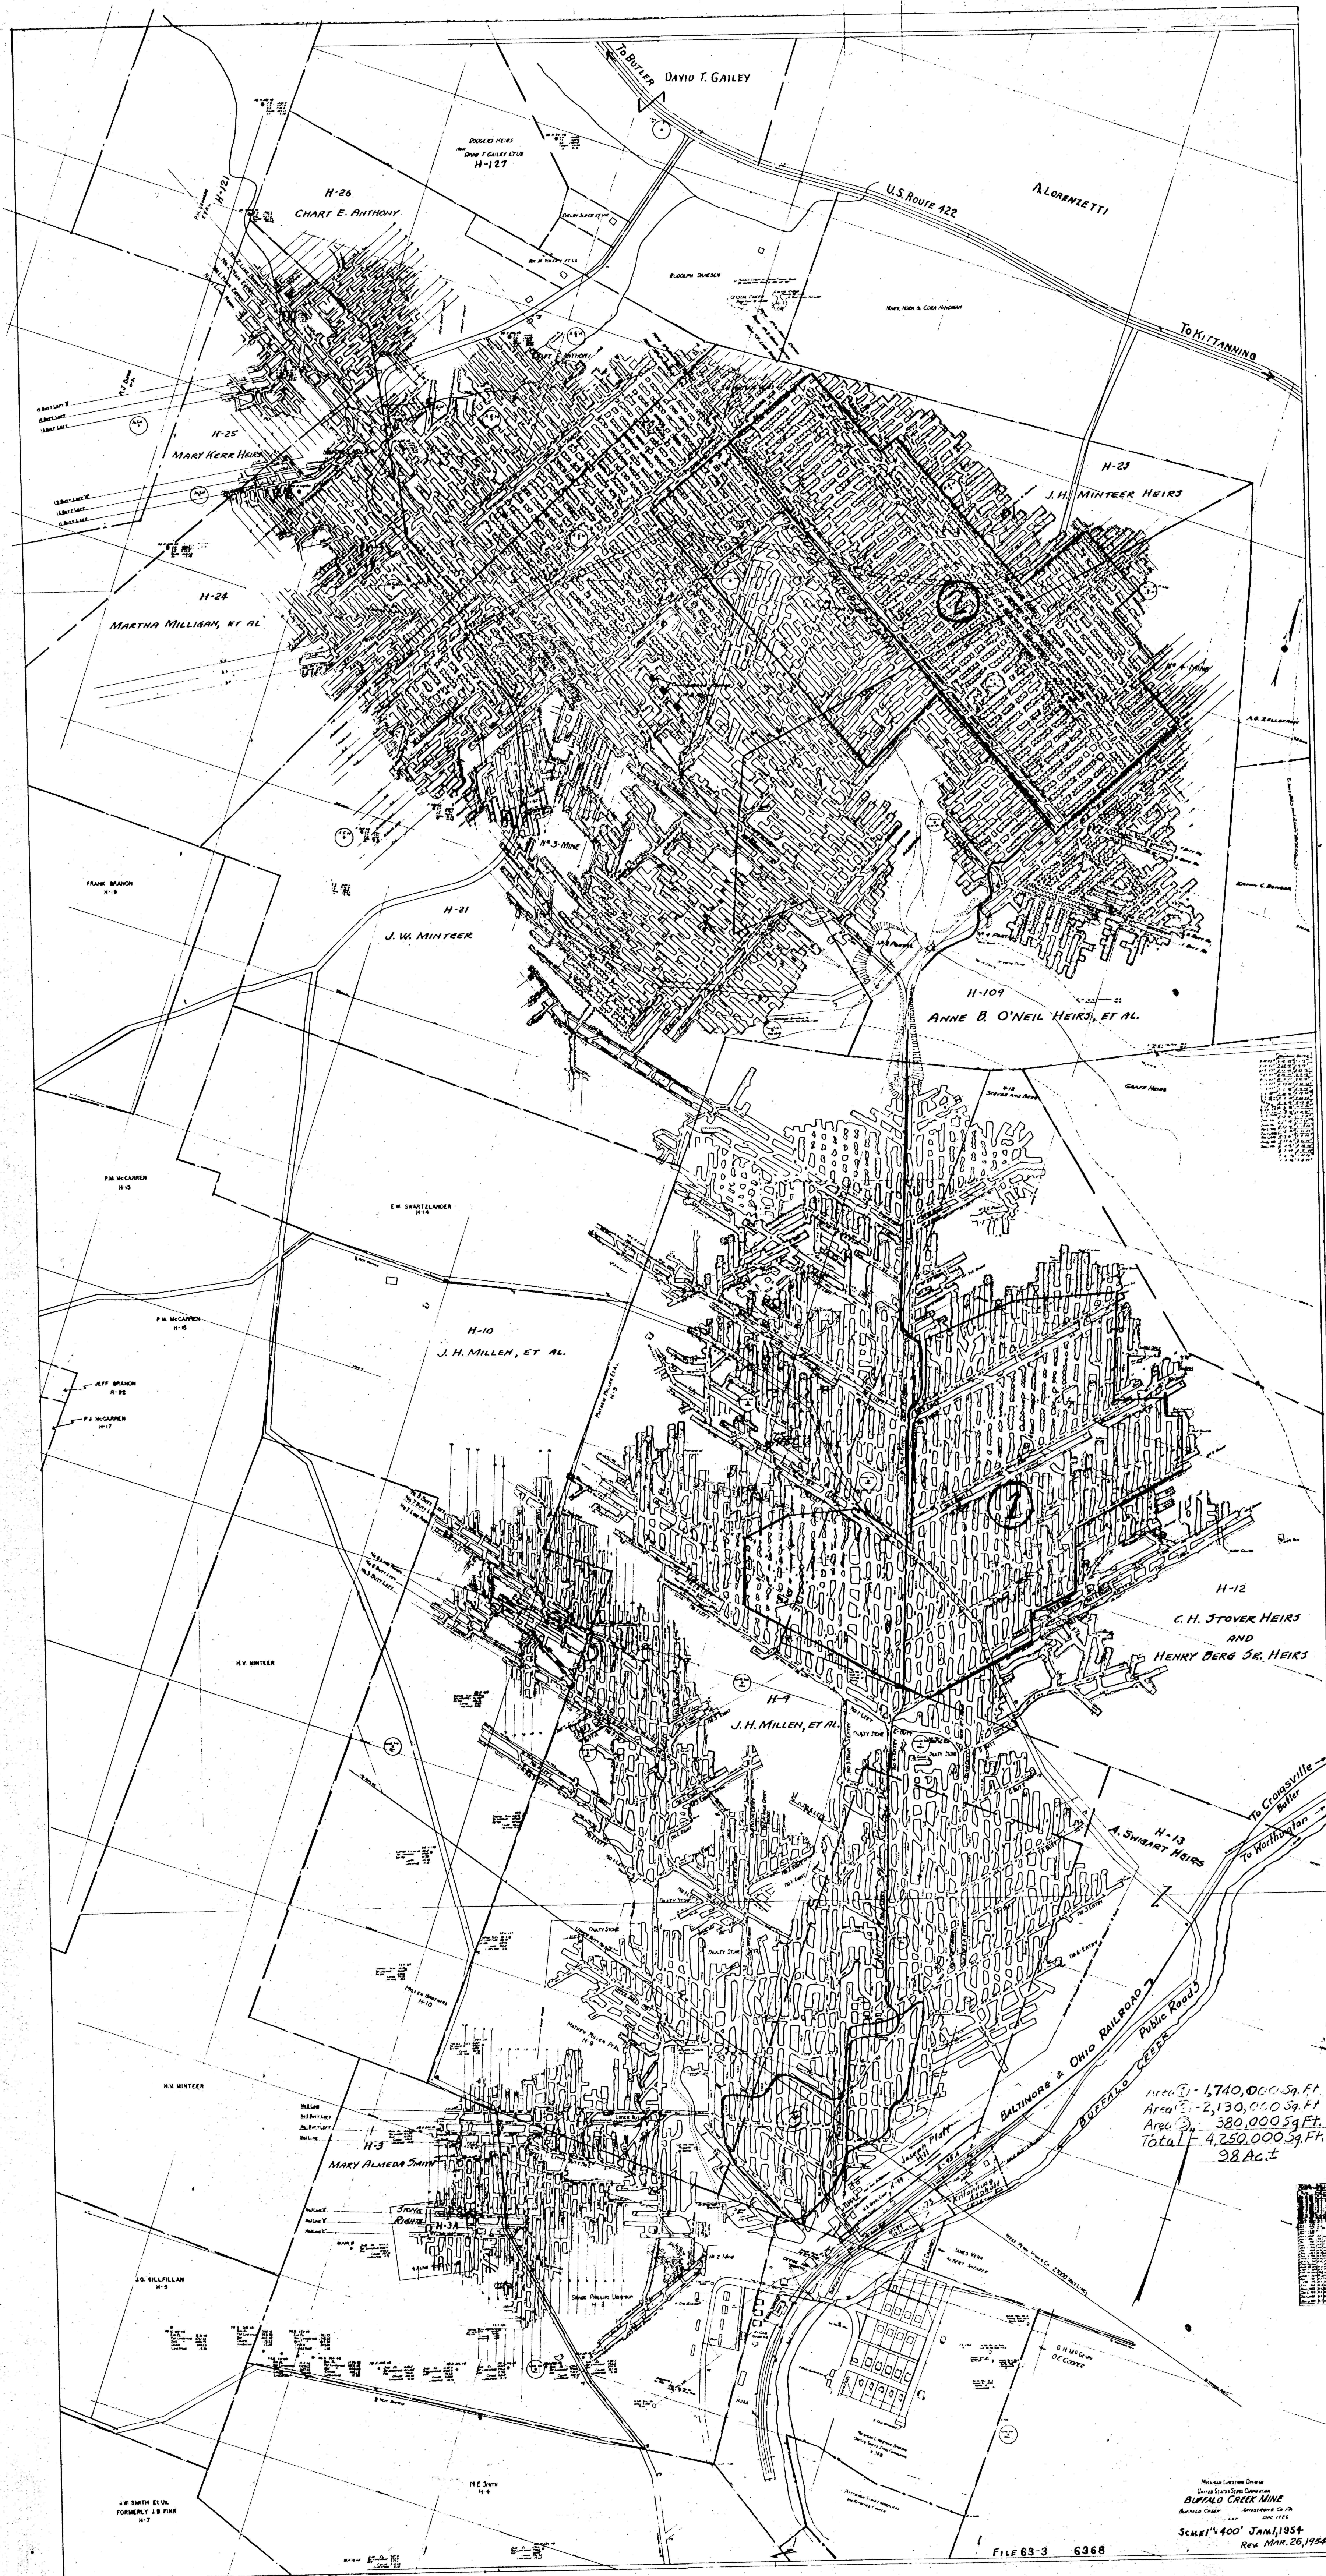

Area 1 - 1,740,000 Sq. Ft.
Area 2 - 2,130,000 Sq. Ft.
Area 3 - 380,000 Sq. Ft.
Total - 4,250,000 Sq. Ft.
98 Ac. ±

Buffalo Creek Mine
Scale 1" = 400' JAN 1, 1954
Rev. MAR. 26, 1954