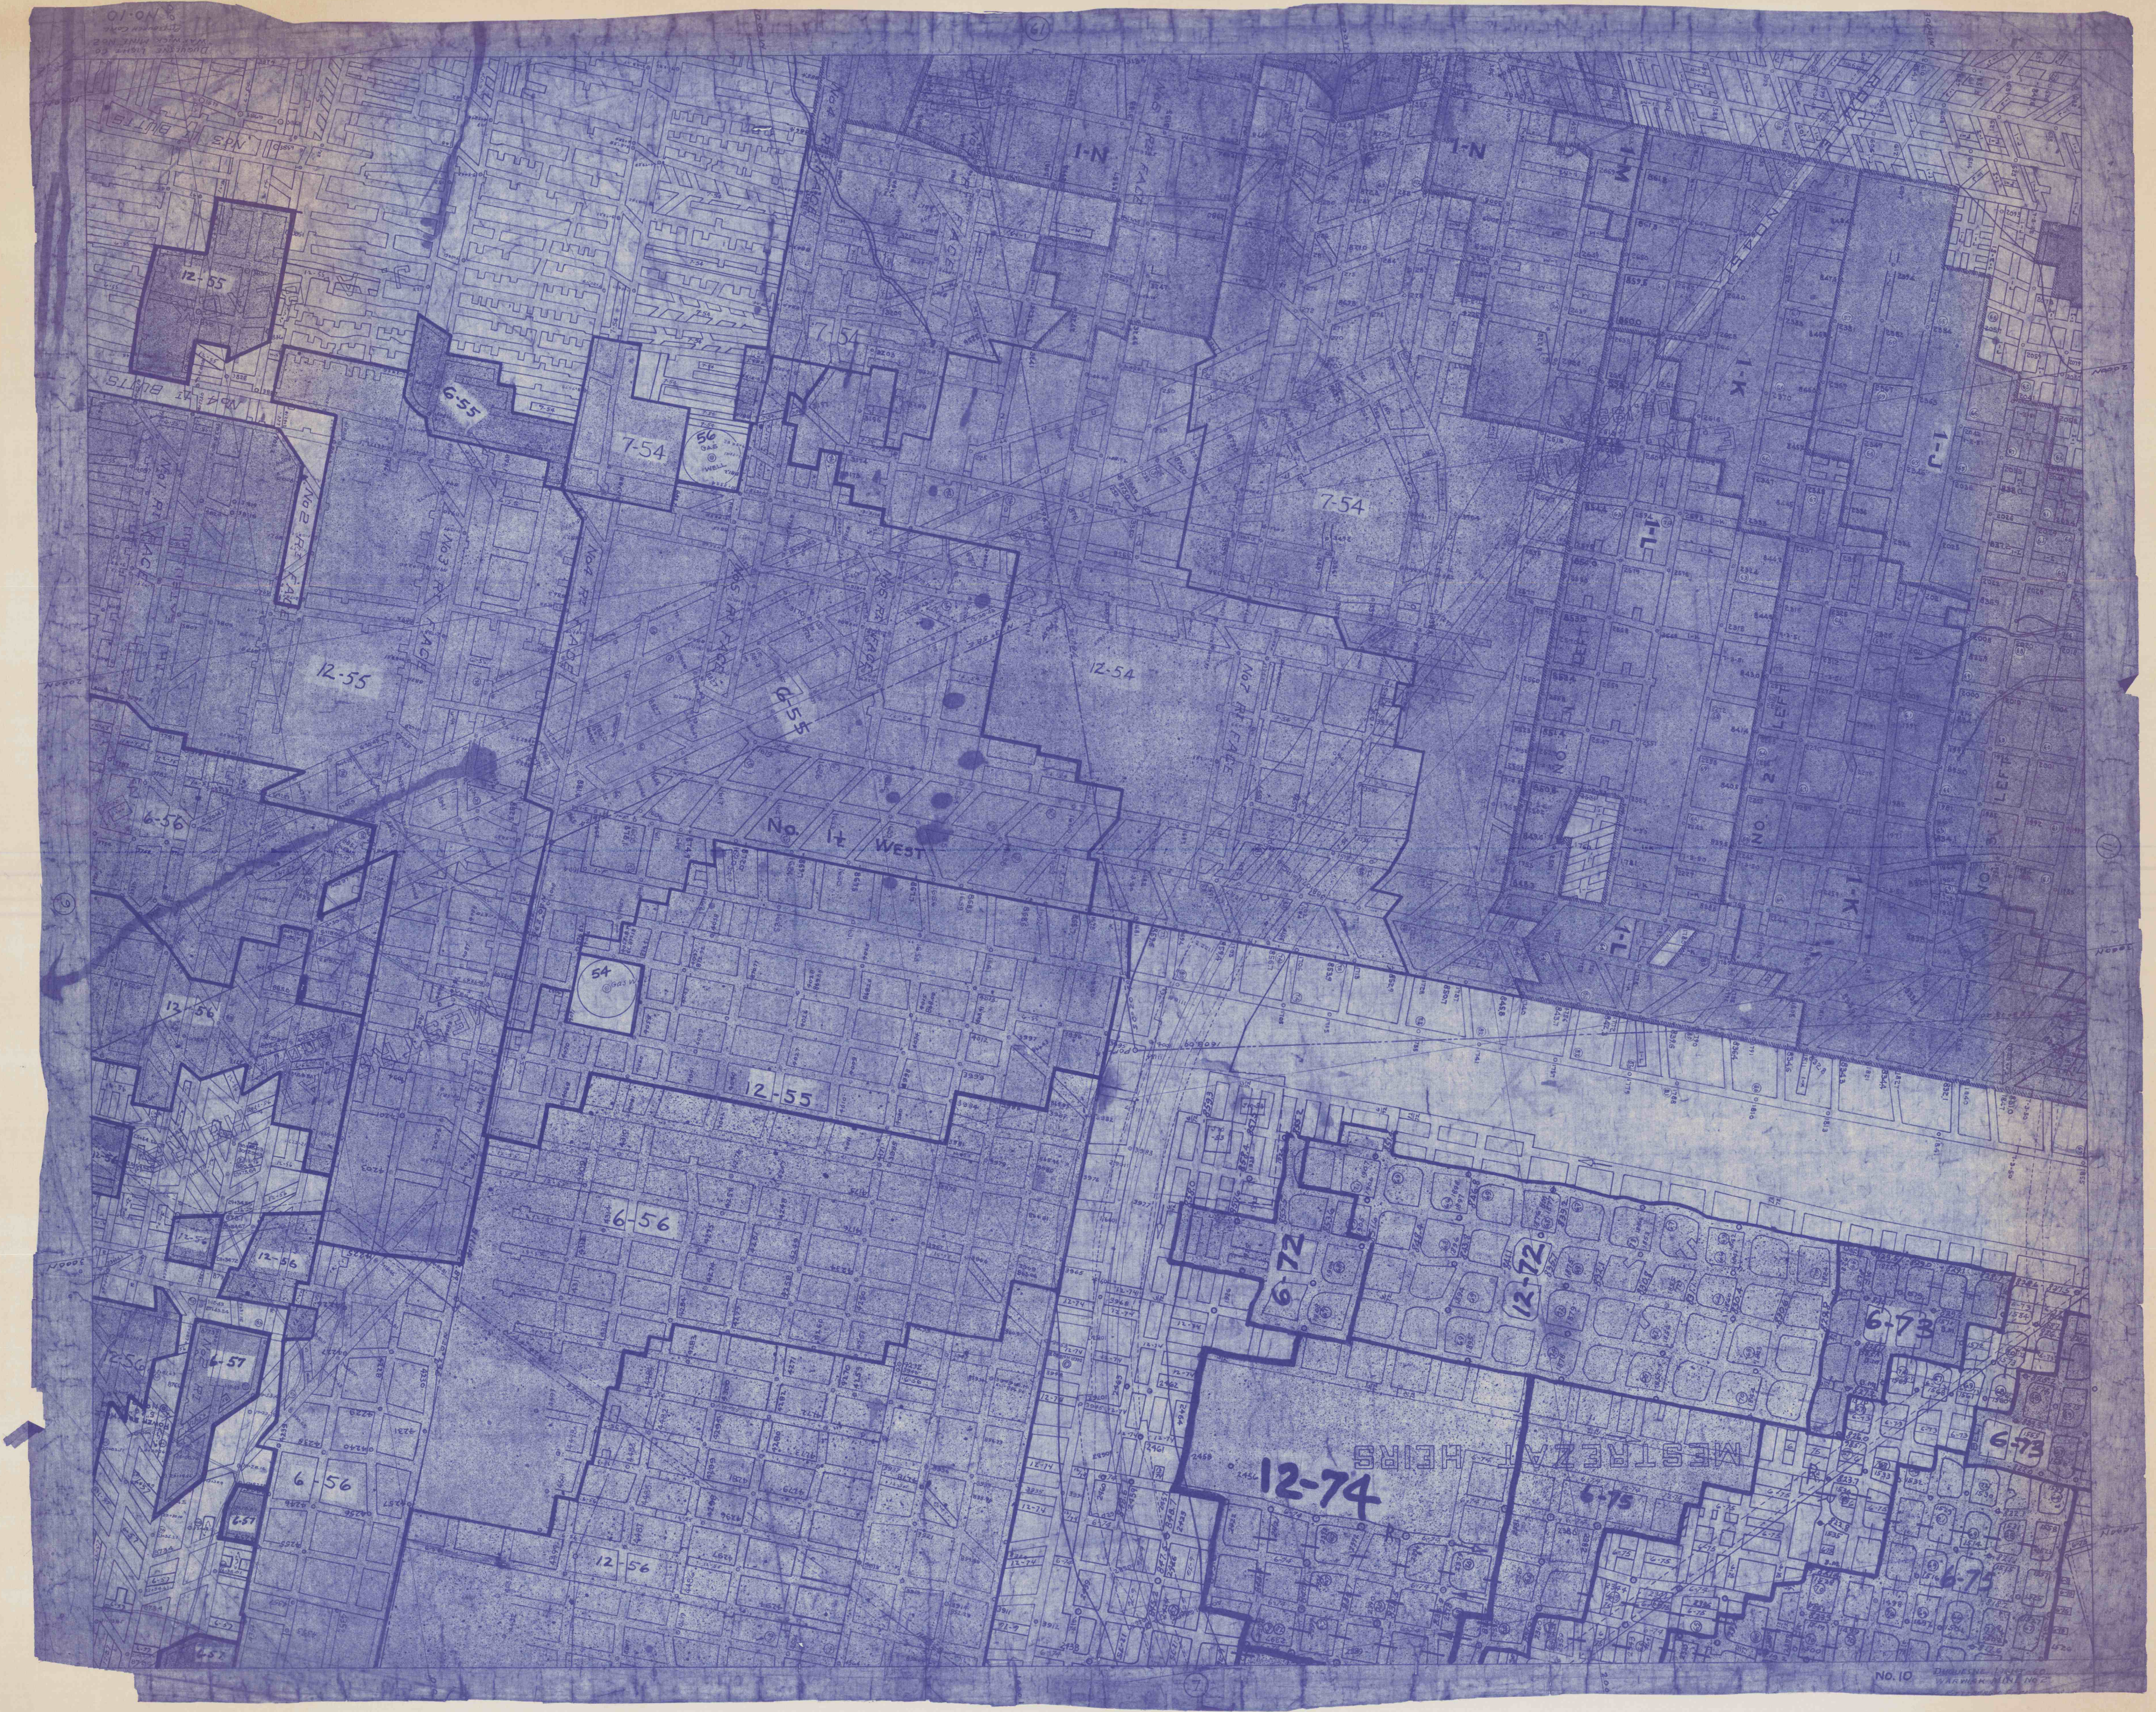
12-55
6-55
7-54
7-54
1-N
1-N
1-K
1-J
7-54
12-55
12-54
6-55
No. 1½ WEST
6-56
12-56
12-55
6-56
12-56
6-57
6-56
12-56
6-72
12-72
6-73
6-73
12-74
6-75
6-75
NO. 10