


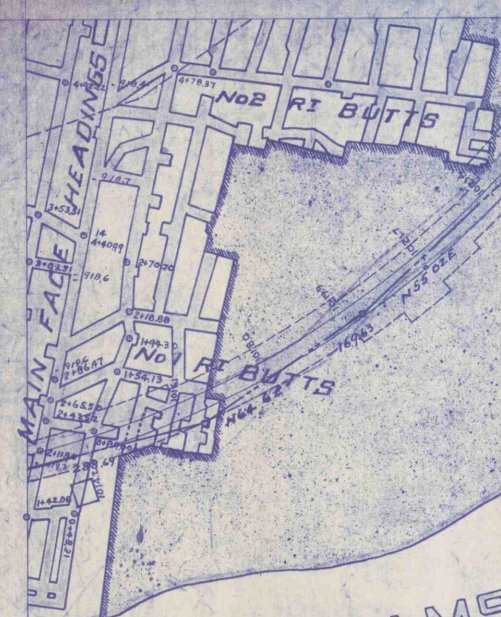

B. G. WILLIAMS

WATER LINE

BARREN

R I V E R

A H E L A