


A.R. KINTER

W.C. MEARS

D. KIRKLAND

C.E. MEARS

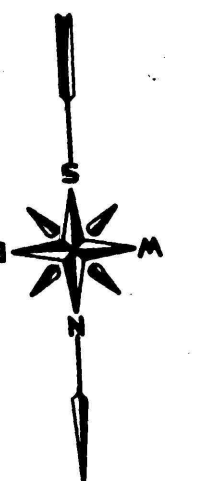

Rec. 2/27/73 14200

Kerry No. 1 D

Final map D-226