


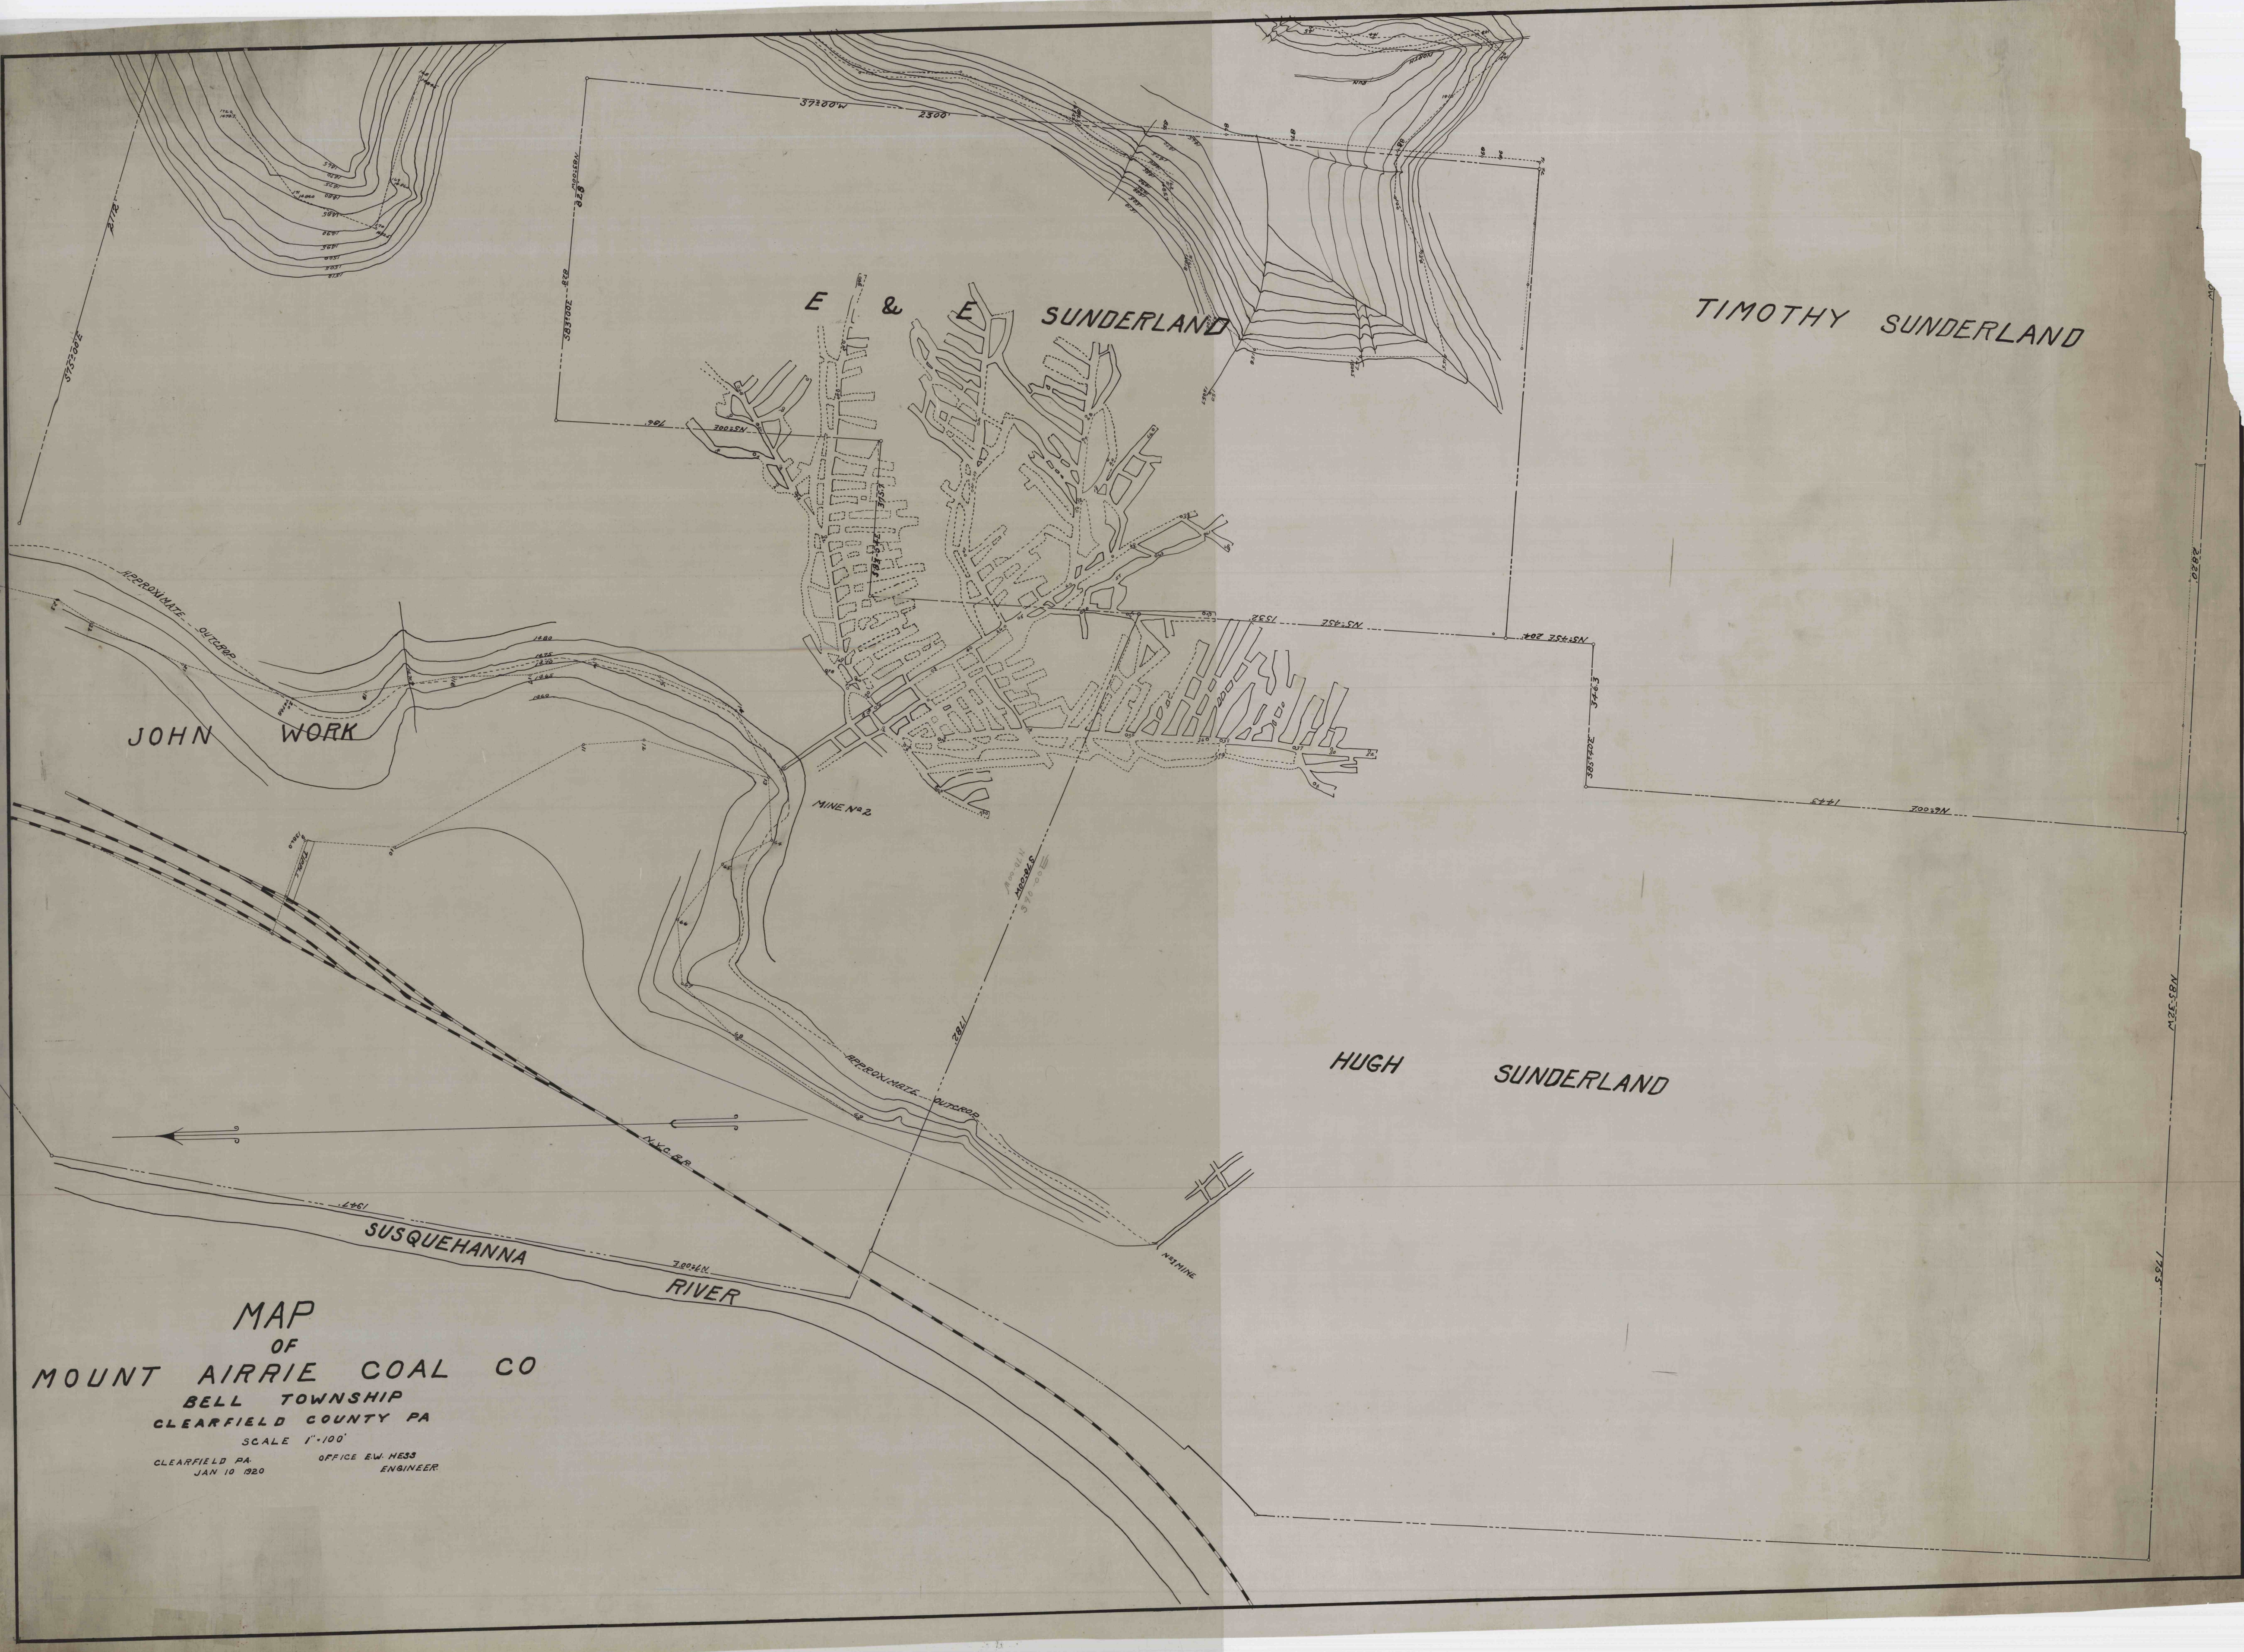

MAP
OF
MOUNT AIRRIE COAL CO
BELL TOWNSHIP
CLEARFIELD COUNTY PA
SCALE 1"=100'

CLEARFIELD PA. OFFICE E. W. HESS
JAN 10 1920 ENGINEER