


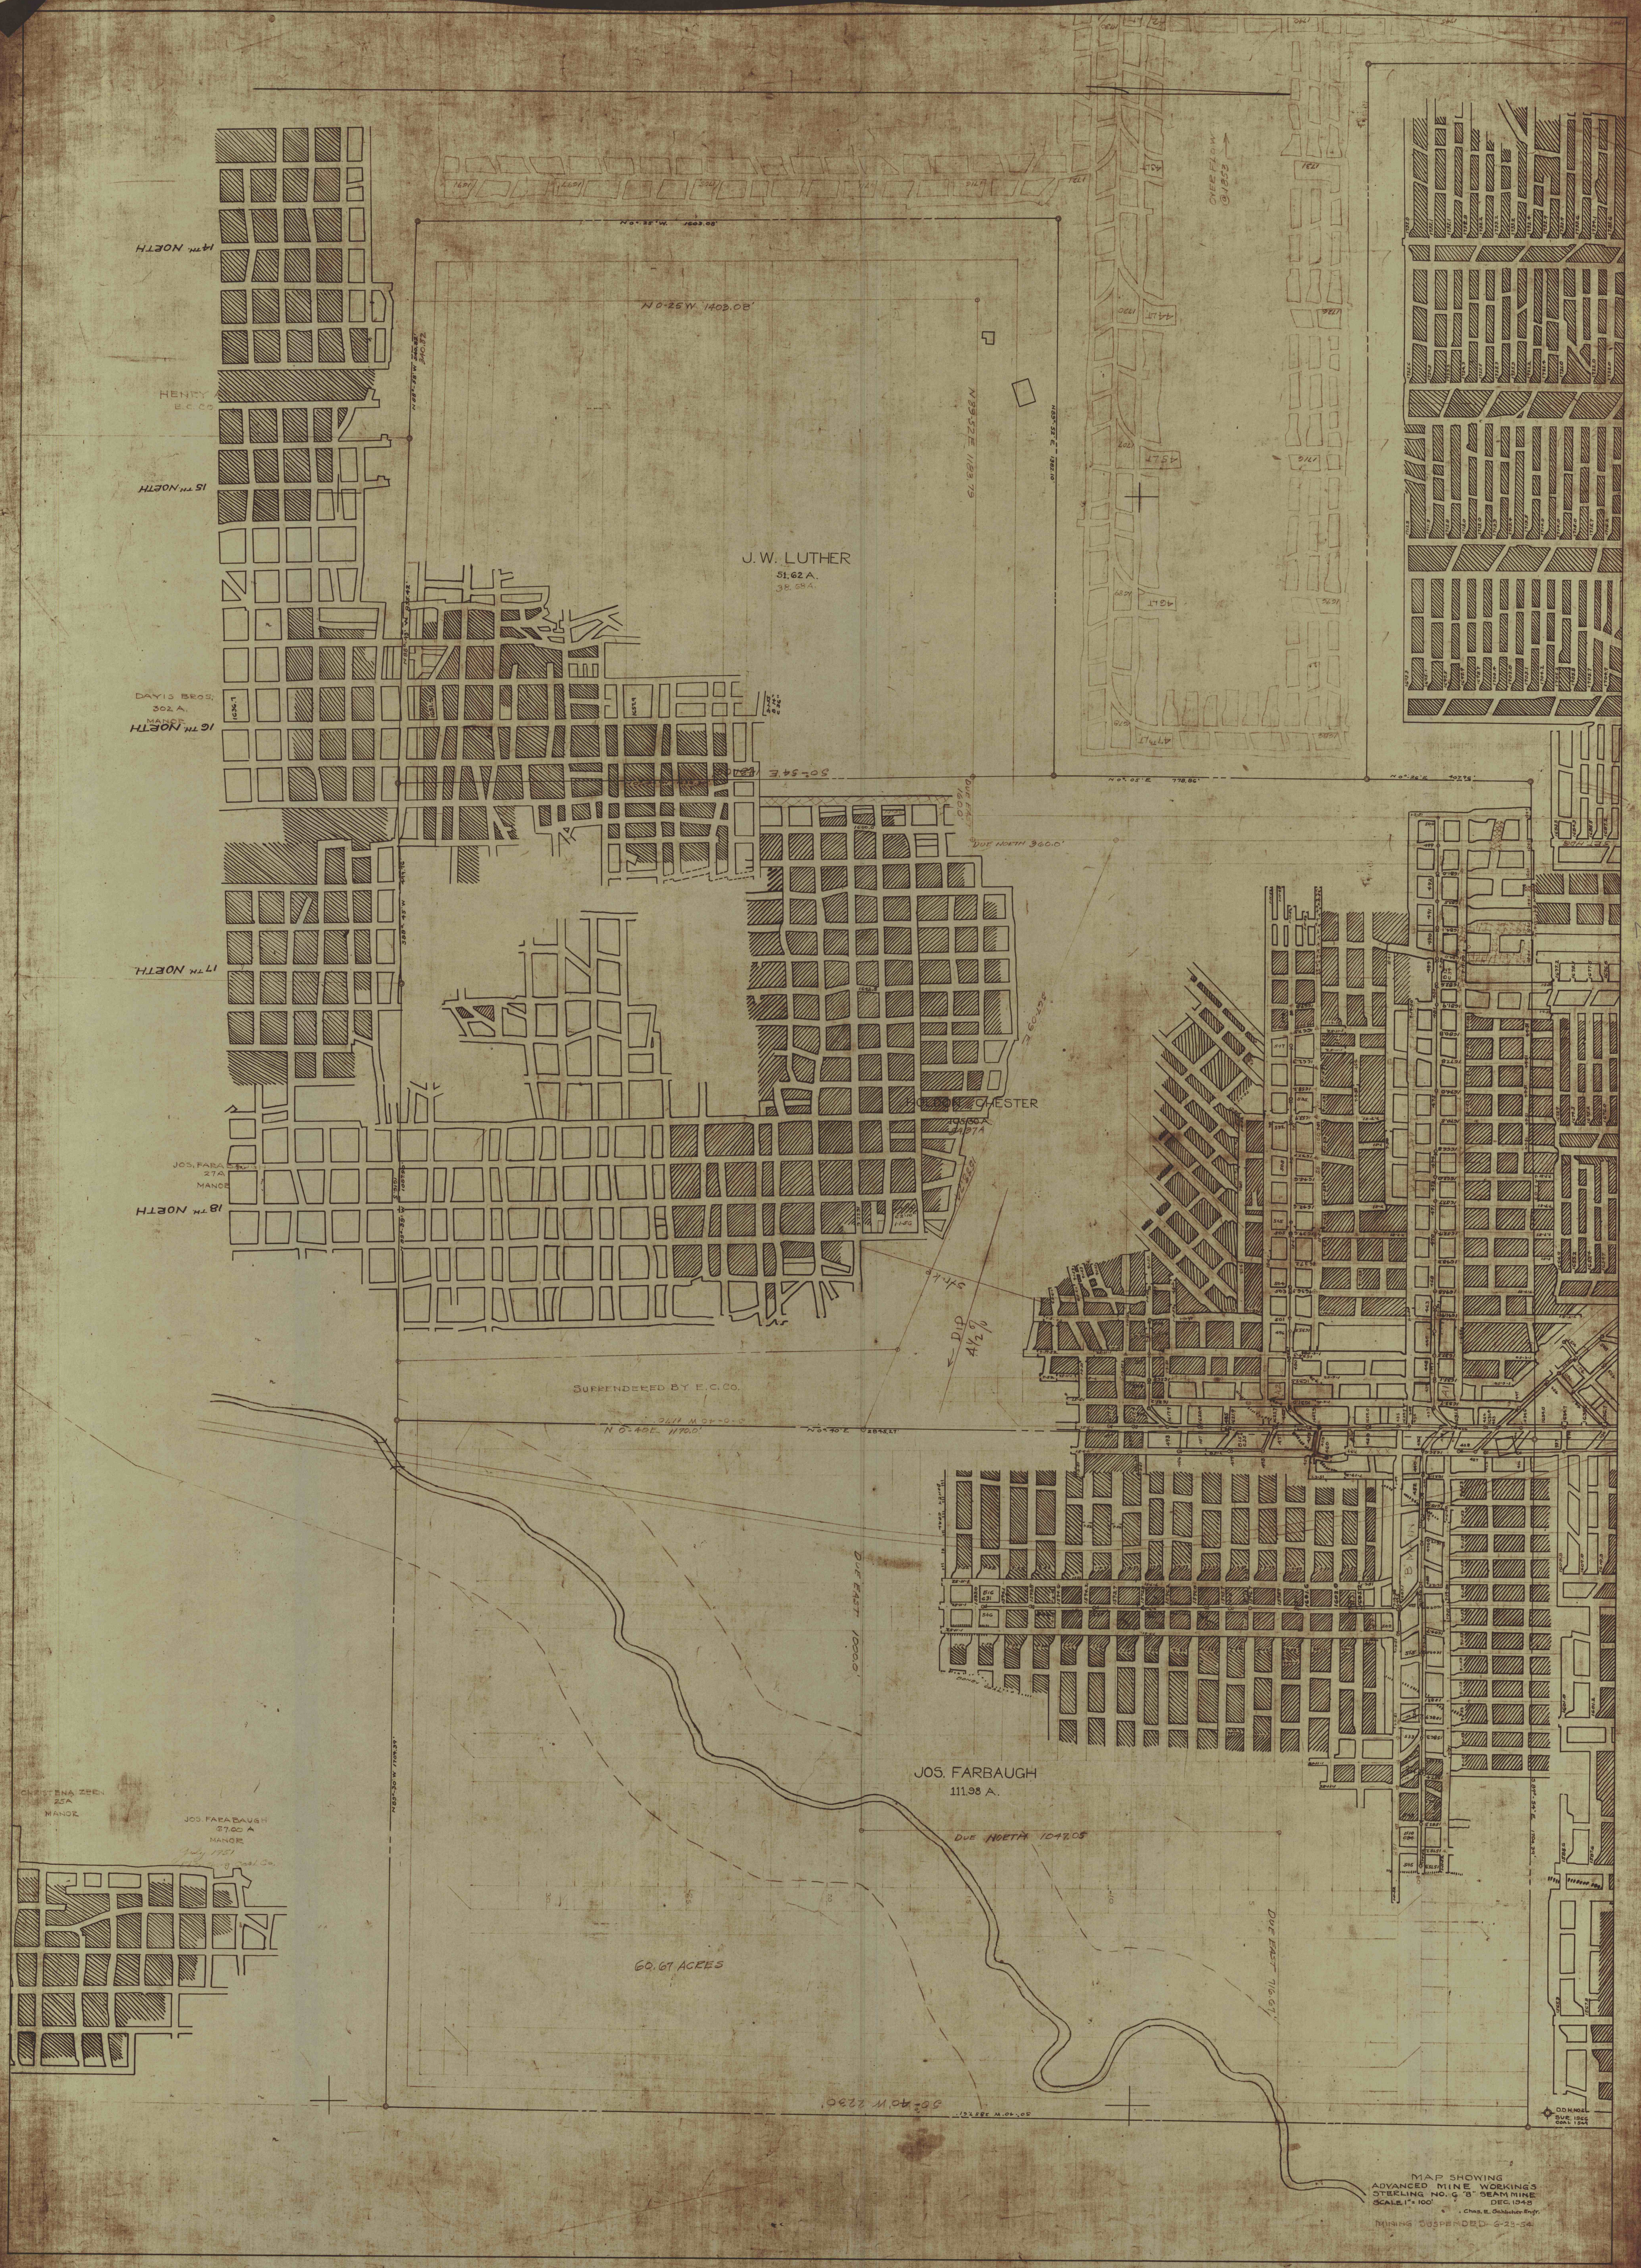

MAP SHOWING
ADVANCED MINE WORKINGS
STEERING NO. 6 "B" SEAM MINE
SCALE 1" = 100'
DEC. 1945
CHAS. E. SCHUBERT, Eng.
MINING SUSPENDED 6-23-34