


WATKINS COAL CO.

COAL CO.

BLUBAKER

BLUBAKER COAL CO.

CHERRY TREE COAL CO.

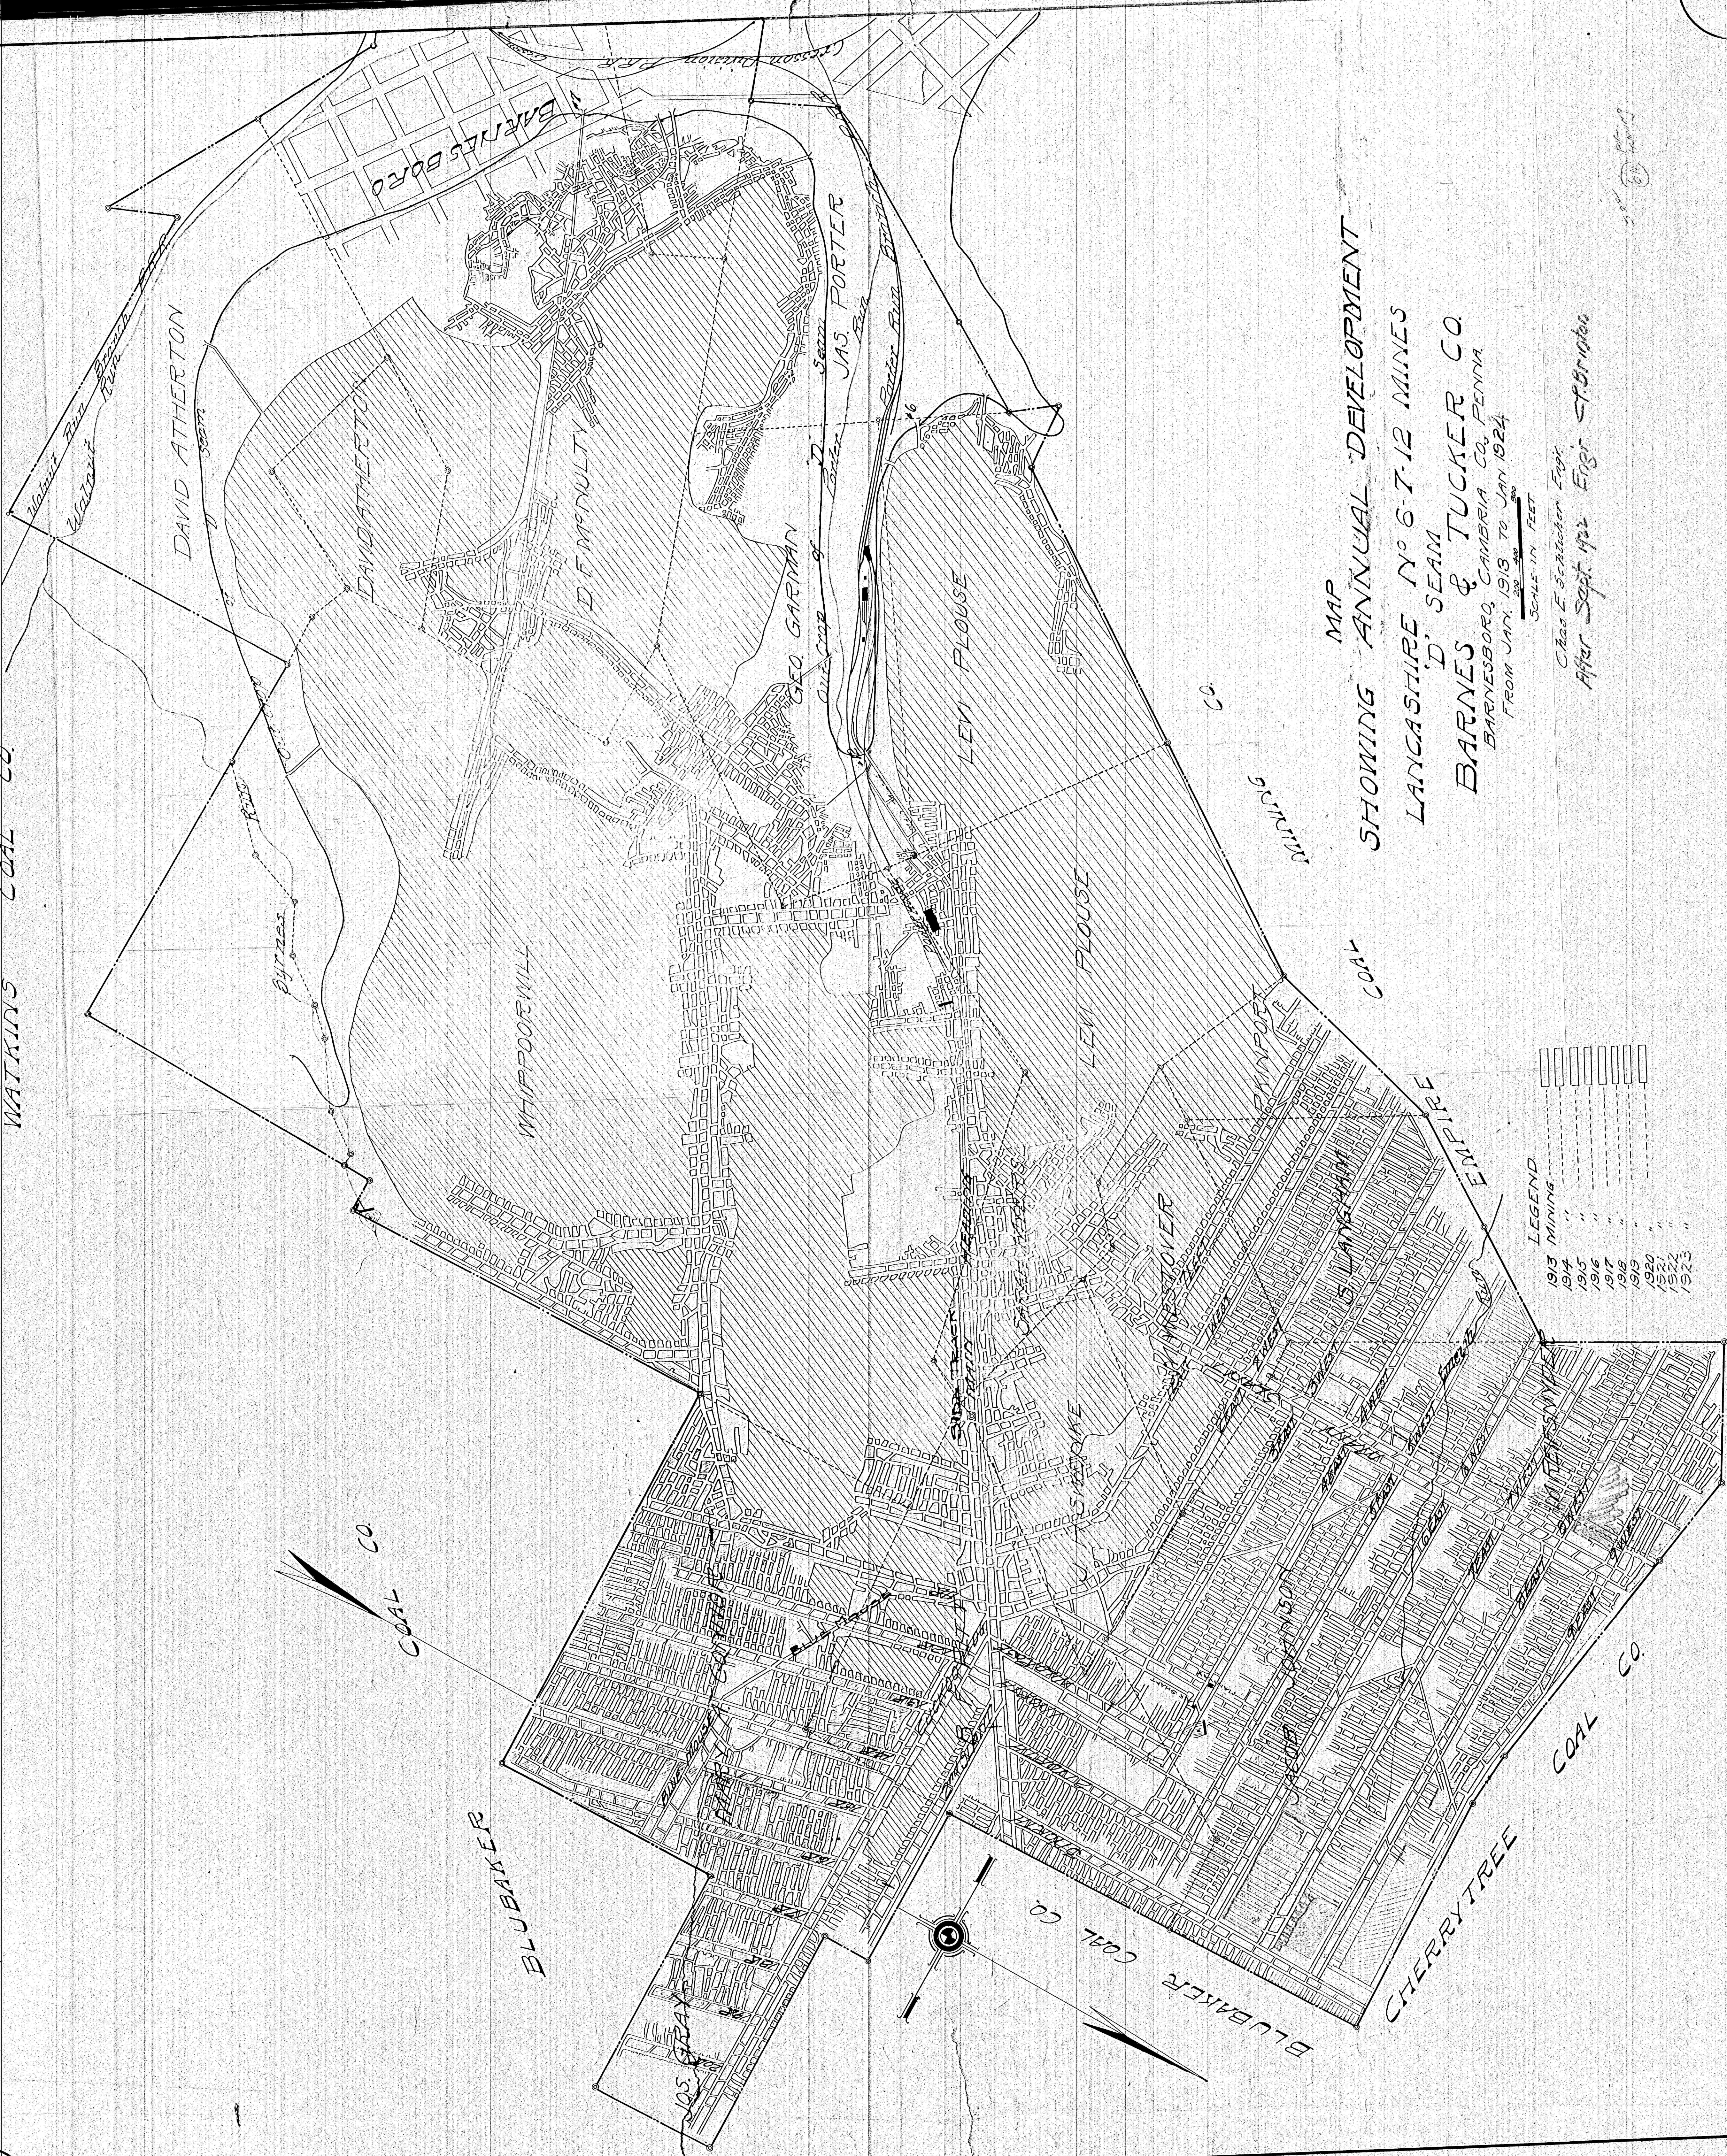

MAP SHOWING ANNUAL DEVELOPMENT

LANCASHIRE NO 6-7-12 MINES

D. SEAM

BARNES & TUCKER CO.

BARNESBORO, CAMBERIA CO. PENNA

FROM JAN. 1913 TO JAN 1924

SCALE 1 IN 12 FT

Class E Section Map

After Sept 1922 Eng. S. B. B. B.