

152 QUARRY

Nº 17 QUARRY

840
820
800
780
760
740
720

11


10

9

8

7

6

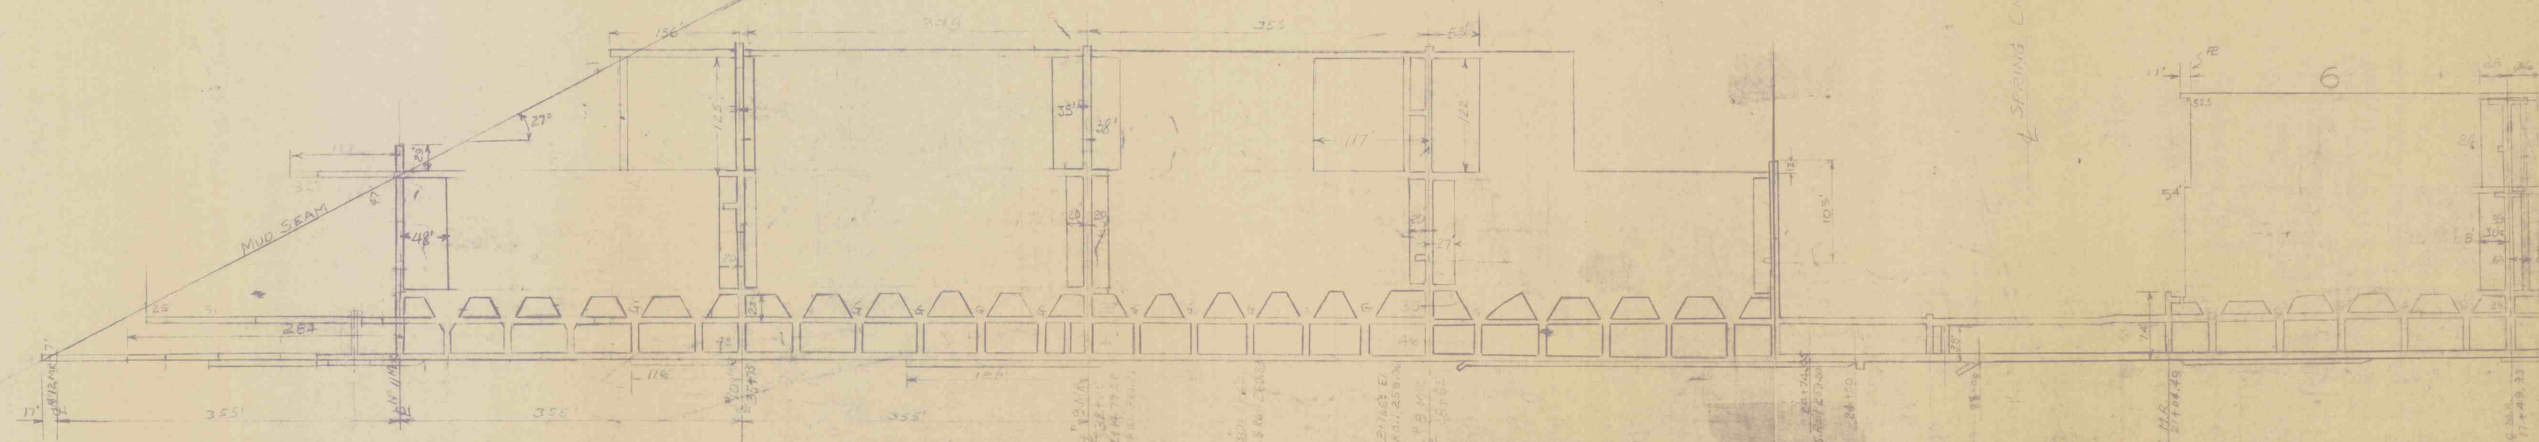

UP TO DATE Jan 1, 1961
JAN 1, 1968

Speed #10

BELL MINE				
EAST PROGRESS & DEVELOPMENT				
DATE JAN. 6, 1953				
WARNER CO.				
BELLEFONTE PA.				
DESIGN	DRAWN	TRACED	APPROVED	JOB NO.
		R.H.D.		