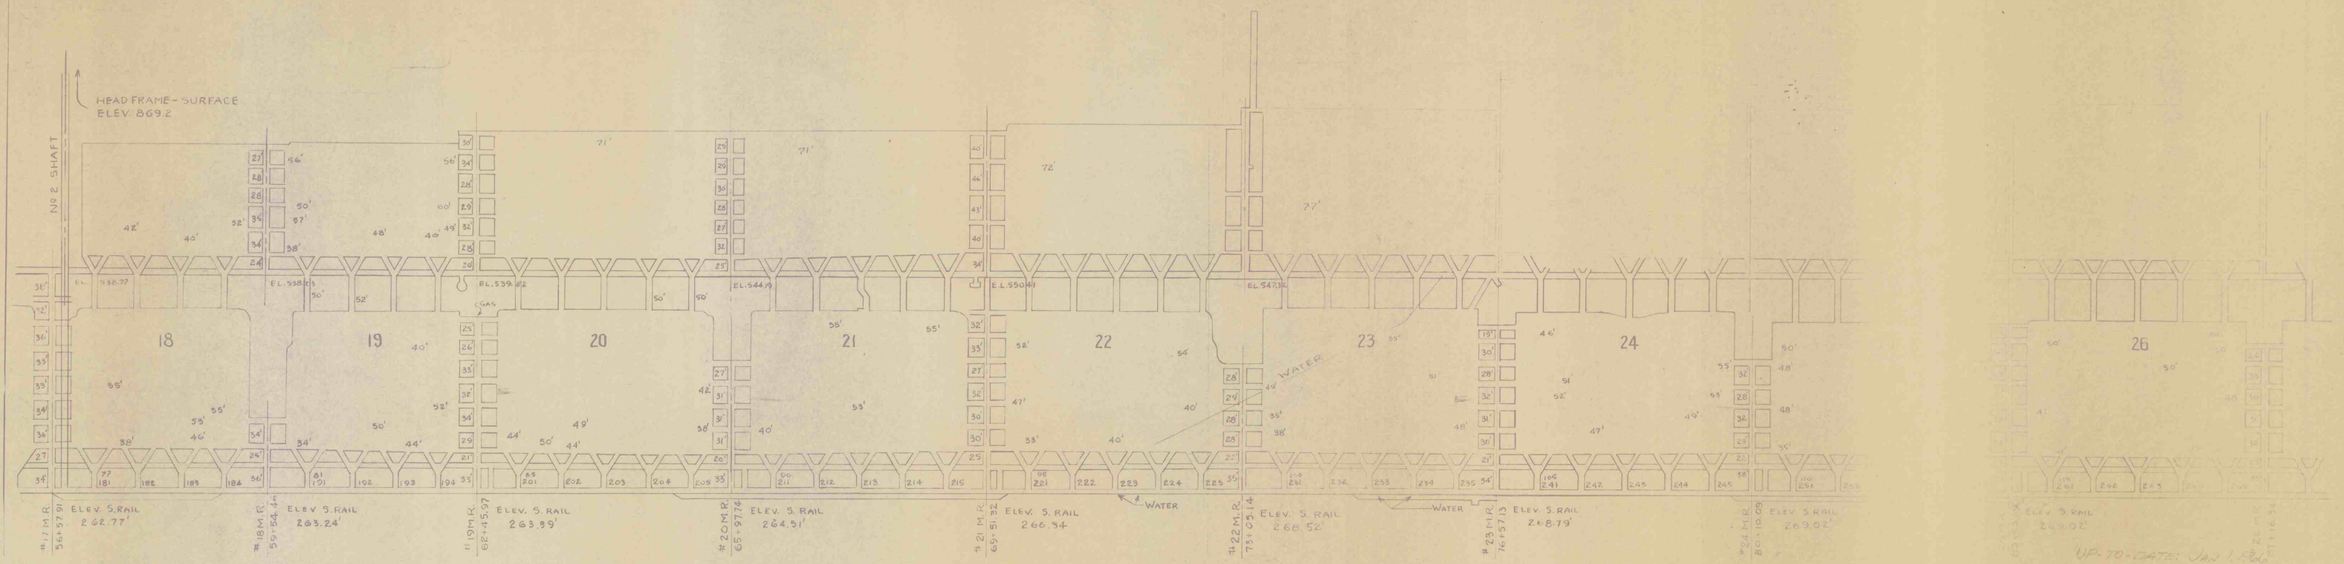
HEAD FRAME - SURFACE
ELEV. 869.2
No 2. SHAFT
18
19
20
21
22
23
24
26
WATER
WATER
#17 M.R.
56+57.91
ELEV. S. RAIL
262.77'
#18 M.R.
59+54.40
ELEV. S. RAIL
263.24'
#19 M.R.
62+45.97
ELEV. S. RAIL
263.39'
#20 M.R.
65+97.74
ELEV. S. RAIL
264.51'
#21 M.R.
69+51.32
ELEV. S. RAIL
266.34'
#22 M.R.
73+05.14
ELEV. S. RAIL
266.52'
#23 M.R.
76+57.13
ELEV. S. RAIL
268.79'
#24 M.R.
80+10.09
ELEV. S. RAIL
269.02'
ELEV. S. RAIL
269.02'
UP-TO-DATE: Jan 1 1961