


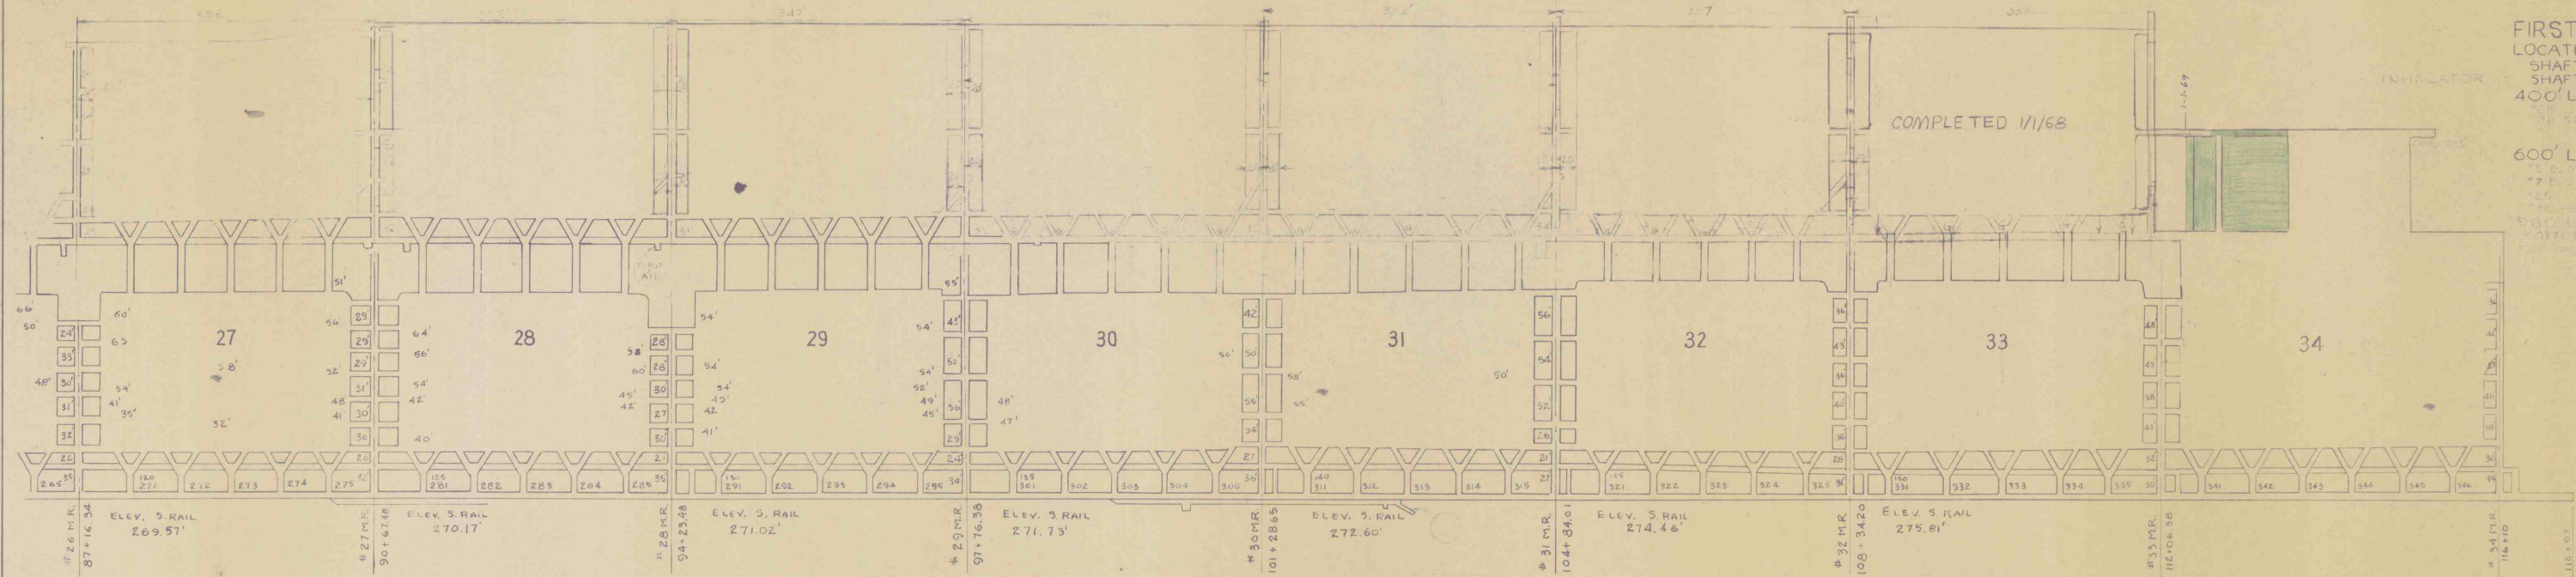

FIRST AID STA  
LOCATED AT  
SHAFT 1 DRY HOUSE  
SHAFT 2 DRY HOUSE  
400' LEVEL  
50 ST. PE  
600' LEVEL  
50 ST. PE  
70 ST. PE  
80 ST. PE  
900' LEVEL  
BOTTOM OF LOWER SLOPE

ELEV. NAT. GYP. DIRT. 1.00' 201.80'

speed #11