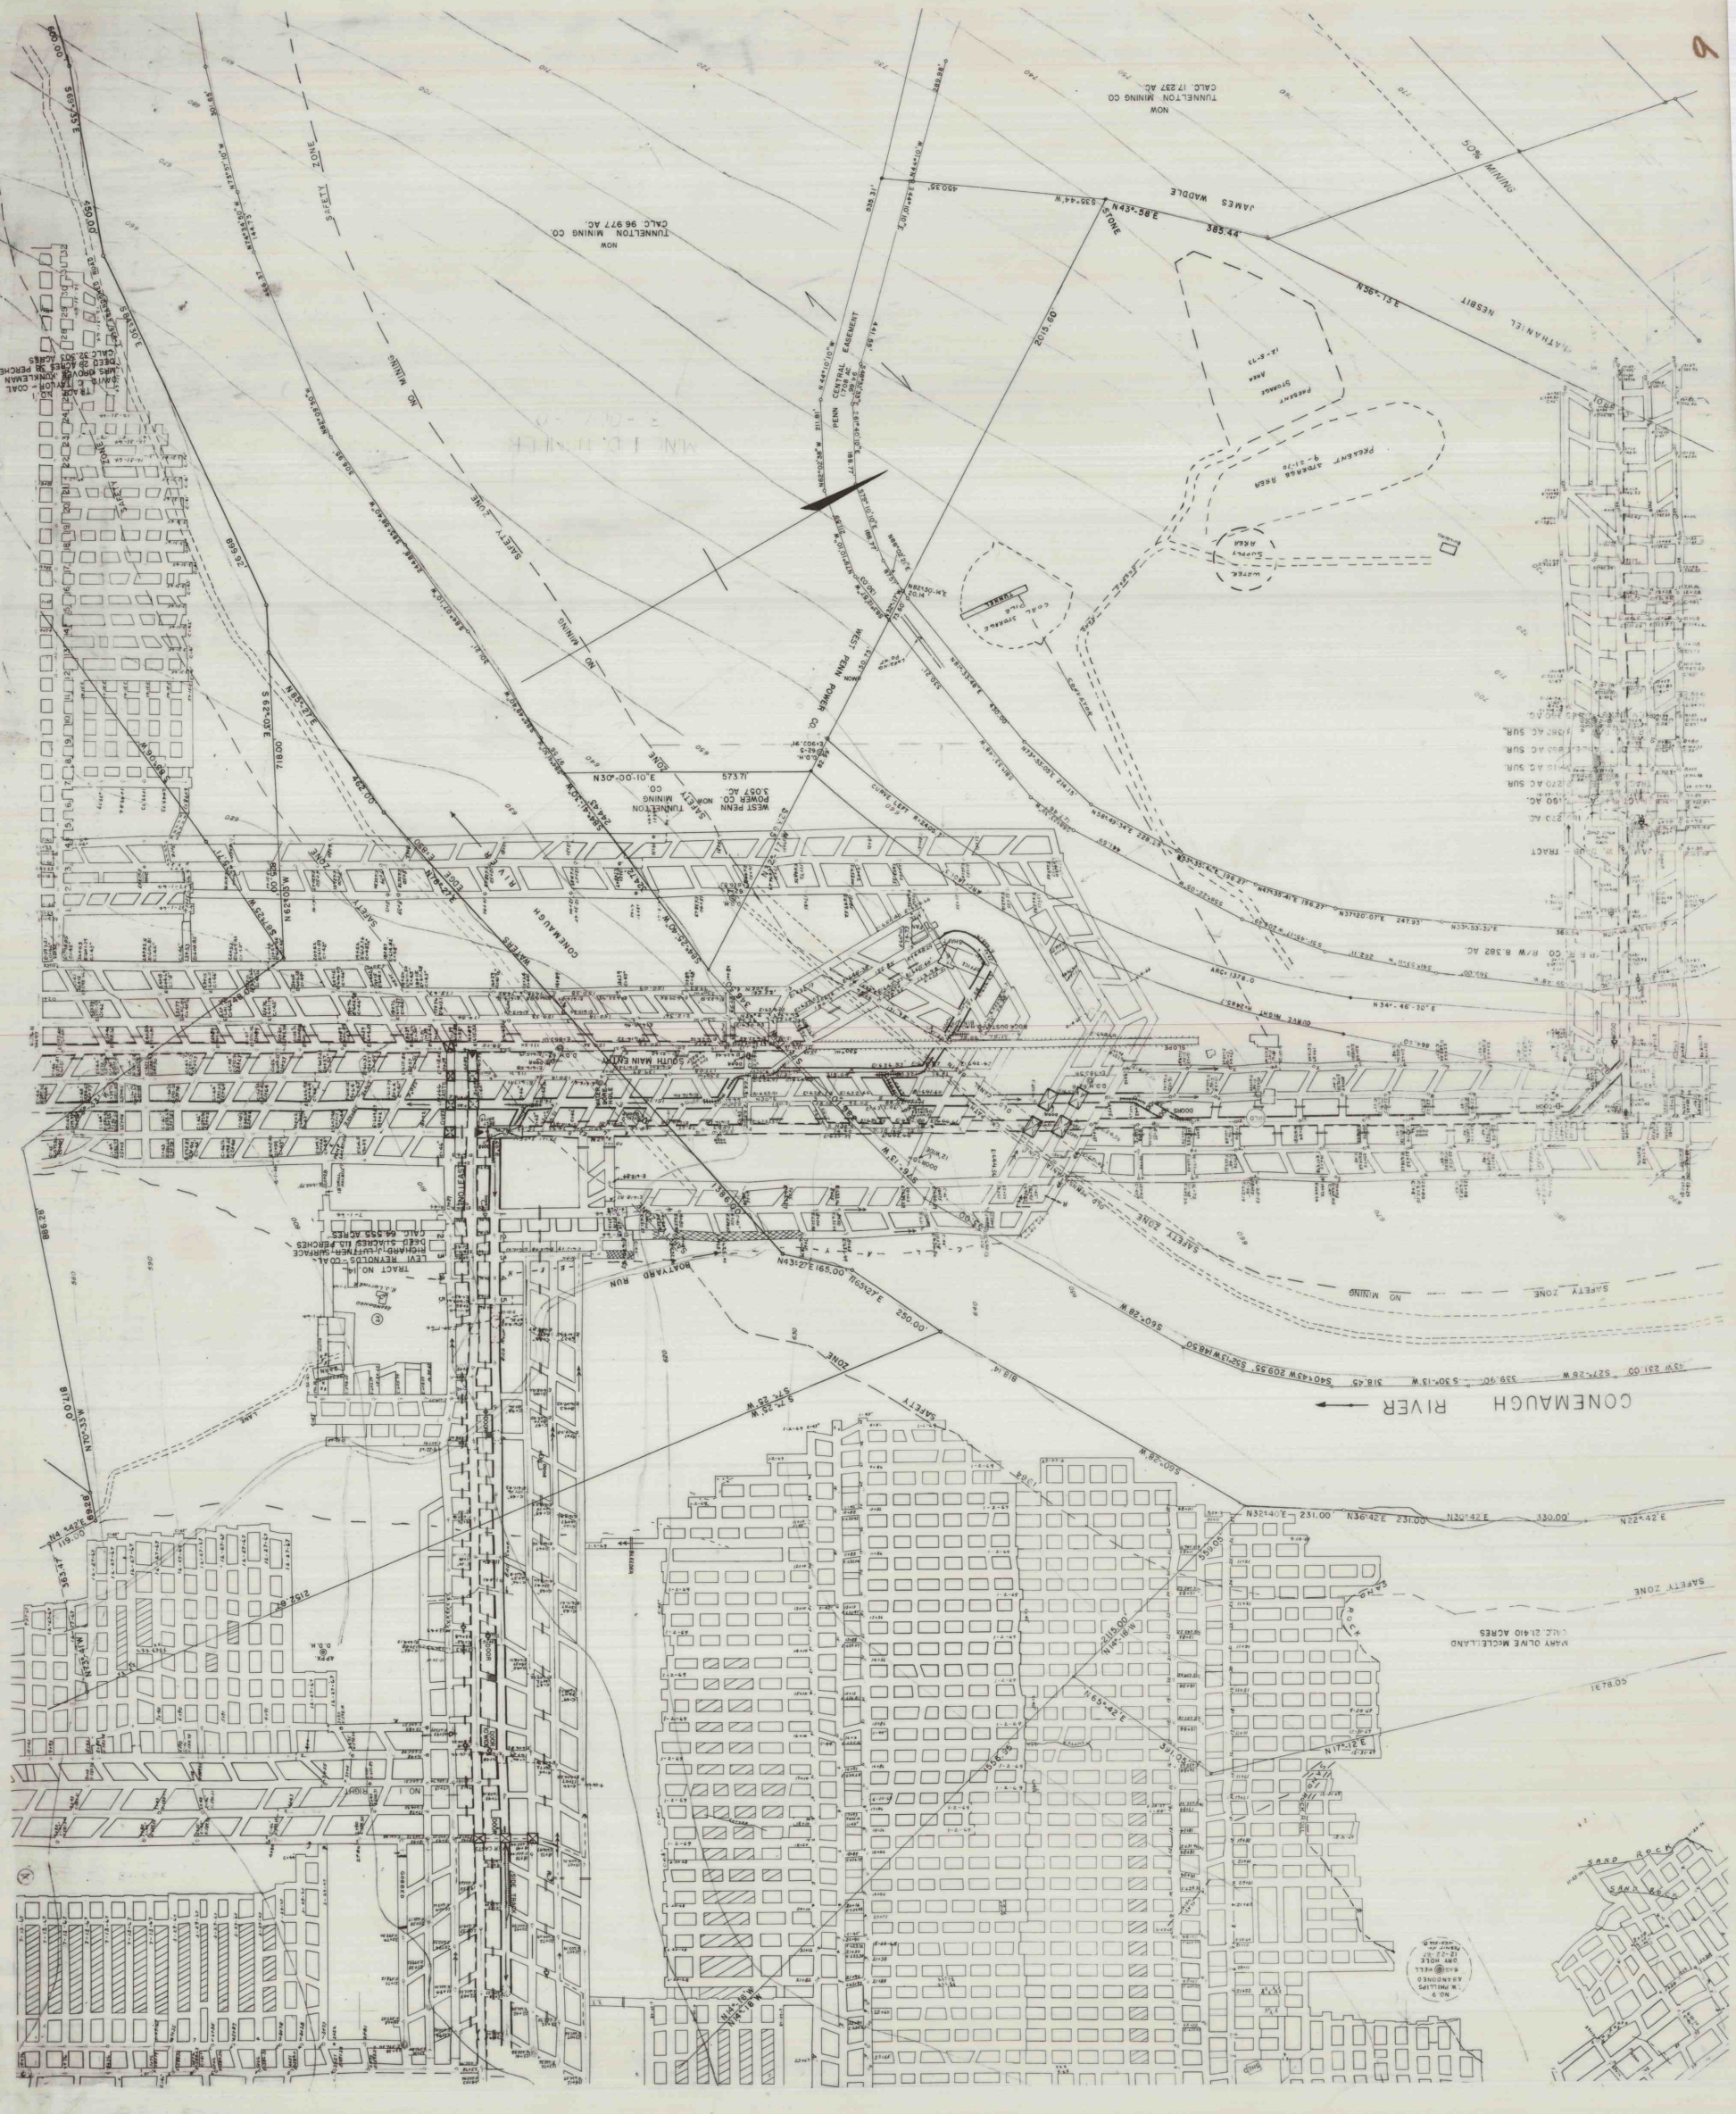
CONEMAUGH RIVER
SOUTH MAIN ENTRY
NO MINING
SAFETY ZONE
PENN CENTRAL EASEMENT
WEST PENN POWER CO.
TUNNELTON MINING CO.
NATHANIEL NESBIT
JAMES WADDLE
50% MINING
MARY OLIVE MCCLELLAND
CALC. 21.410 ACRES
LEVI REYNOLDS-COAL
CALC. 64.555 ACRES
CONEMAUGH RIVER