


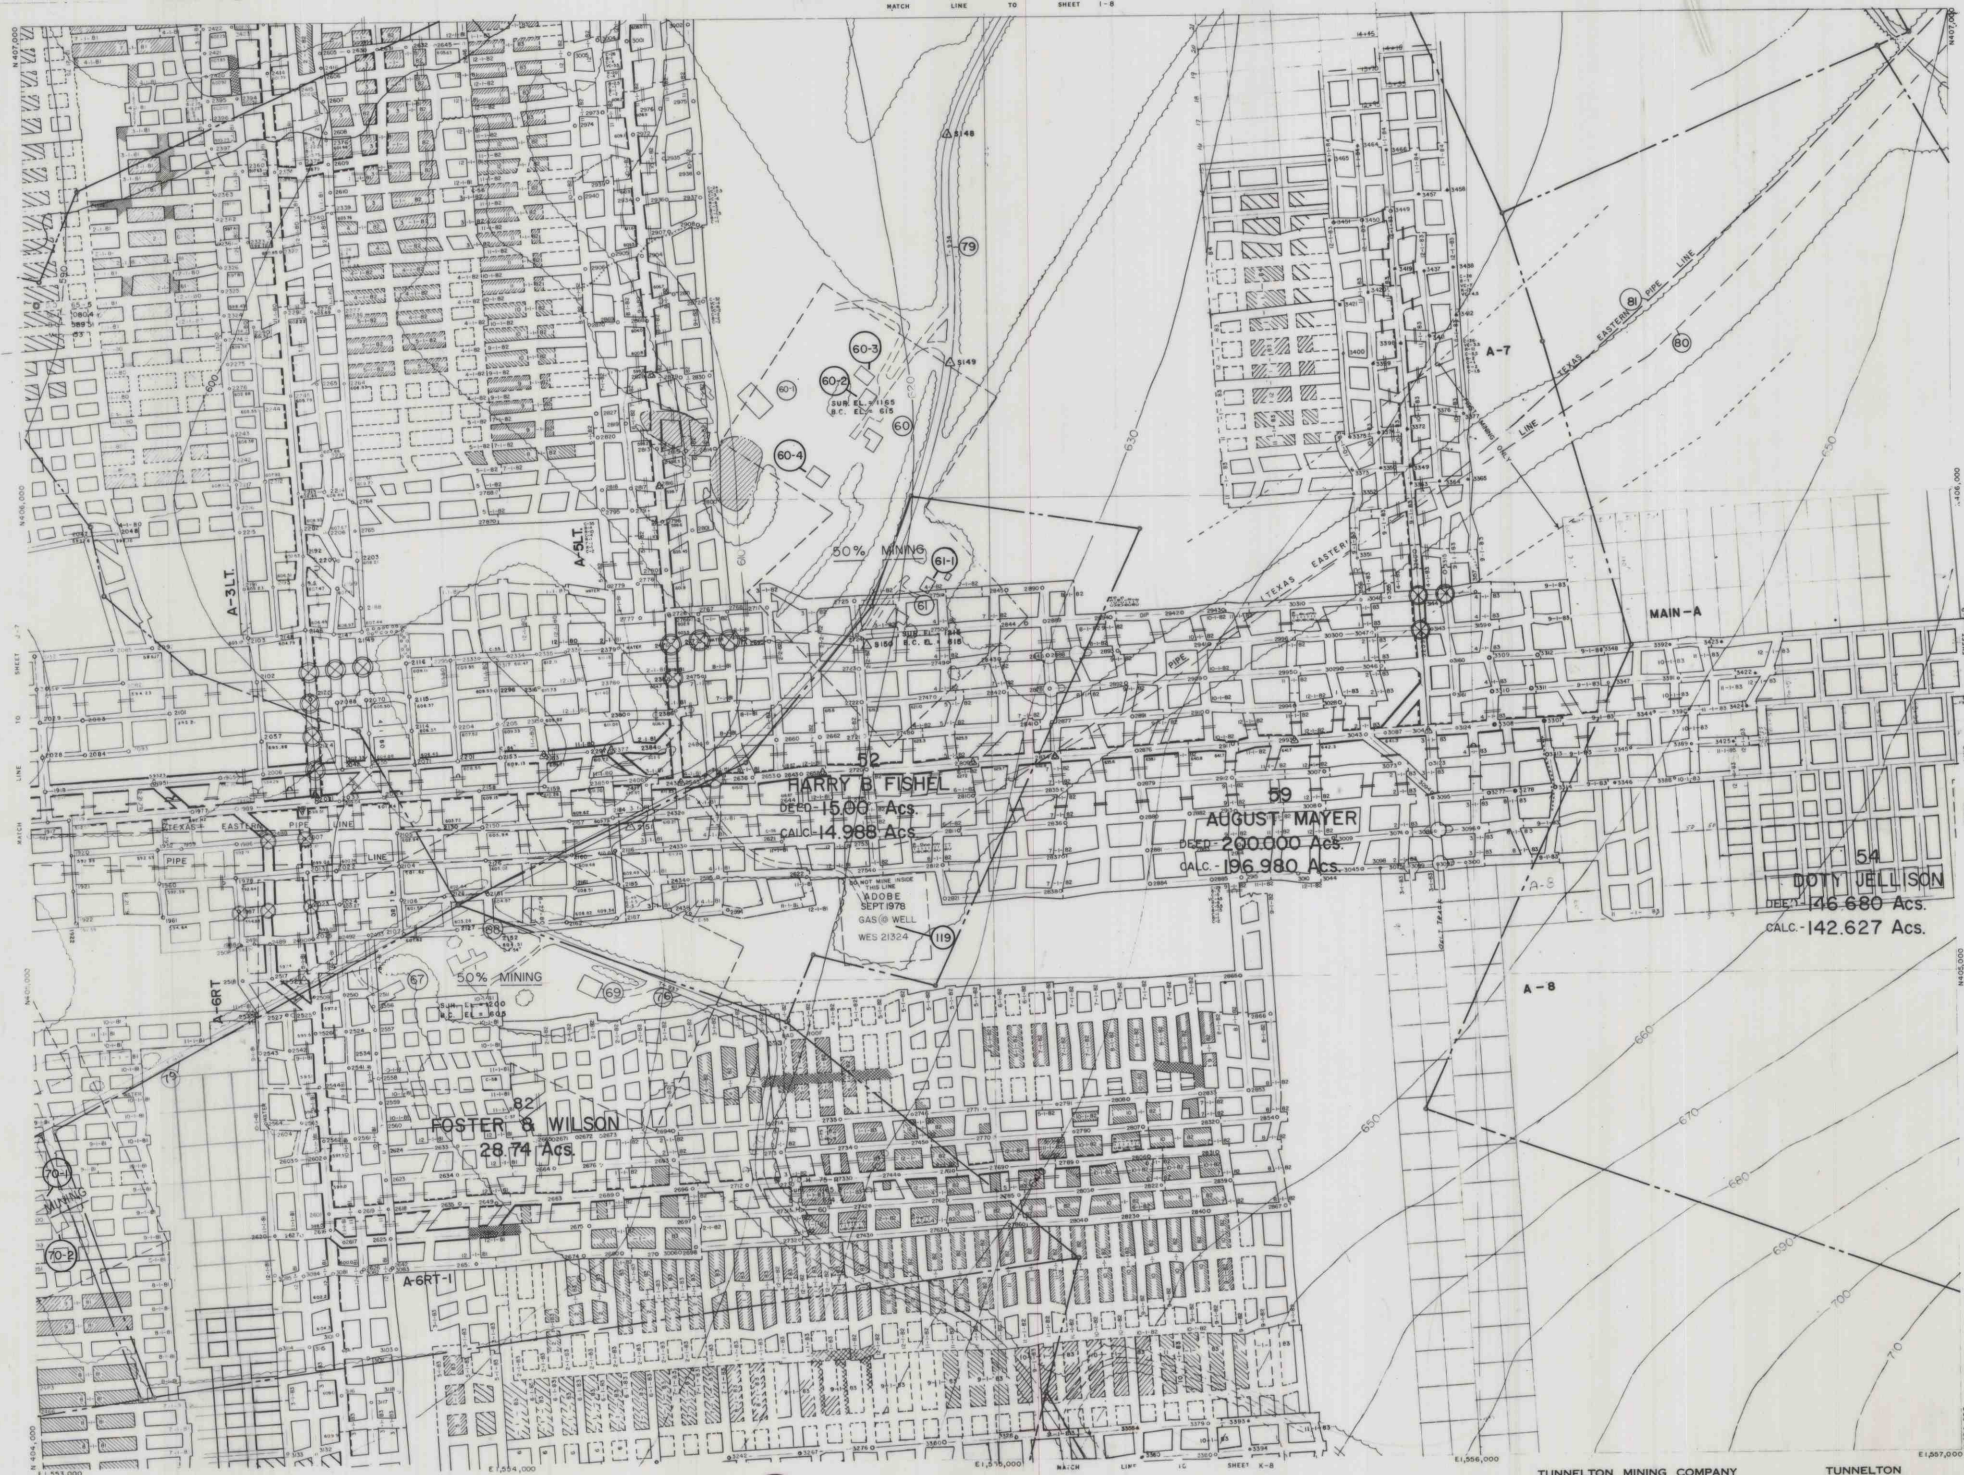

TUNNELTON MINING COMPANY
MARION MINE U.S.B.M. NO. 36 00929
LOCATION: CORNBRAUGH TWP. INDIANA CO. PA.
ADDRESS: BOX 327 EXETER, PA. 15931

TUNNELTON
MARION MINE
SCALE 1"=200'
INDIANA & WESTMORELAND COUNTIES
SHEET 1-8