


NO	NAME OF TRACT	ACRES
1	MICHAEL FRANK	13.63
2	JOSEPH SPRINGER	33.85
3	KUNZELMAN ESTATE	48.97
4	JOHN DUMAN	44.94
5	THOMAS LLOYD	105.61
6	MATTHIAS HUFFMAN	130.00
7	ANDREW PREISSER	91.75
8	JOHN WOLF	27.20
9	HENRY SHILLING	0.08
10	HENRY SMITH	50.33
11	JOSEPH PREISSER	63.33
12	JOHN B. KIRSCH	111.34
13	WILLIAM PLUMMER	121.12
14	THOMAS LEEDWARDS	262.70
15	THOS. GRIFFITH EST.	344.04
16	MARGARET AGE	10.10
17	JOHN EAGLEY	271.30
18	D.B. EDWARDS	114.68
19	MARY GITTINGS	51.84
	TOTAL	1905.83

DATE OF LAST SURVEY	
JANUARY 1931	JANUARY 1931
JULY 1931	JANUARY 1931
JANUARY 1932	JULY 1931
JULY 1932	JANUARY 1932
JANUARY 1933	JULY 1932
JULY 1933	JANUARY 1933
JANUARY 1934	JULY 1933
JULY 1934	JANUARY 1934
JANUARY 1935	JULY 1934
JULY 1935	JANUARY 1935
JANUARY 1936	JULY 1935
JULY 1936	JANUARY 1936
JANUARY 1937	JULY 1936
JULY 1937	JANUARY 1937
JANUARY 1938	JULY 1937

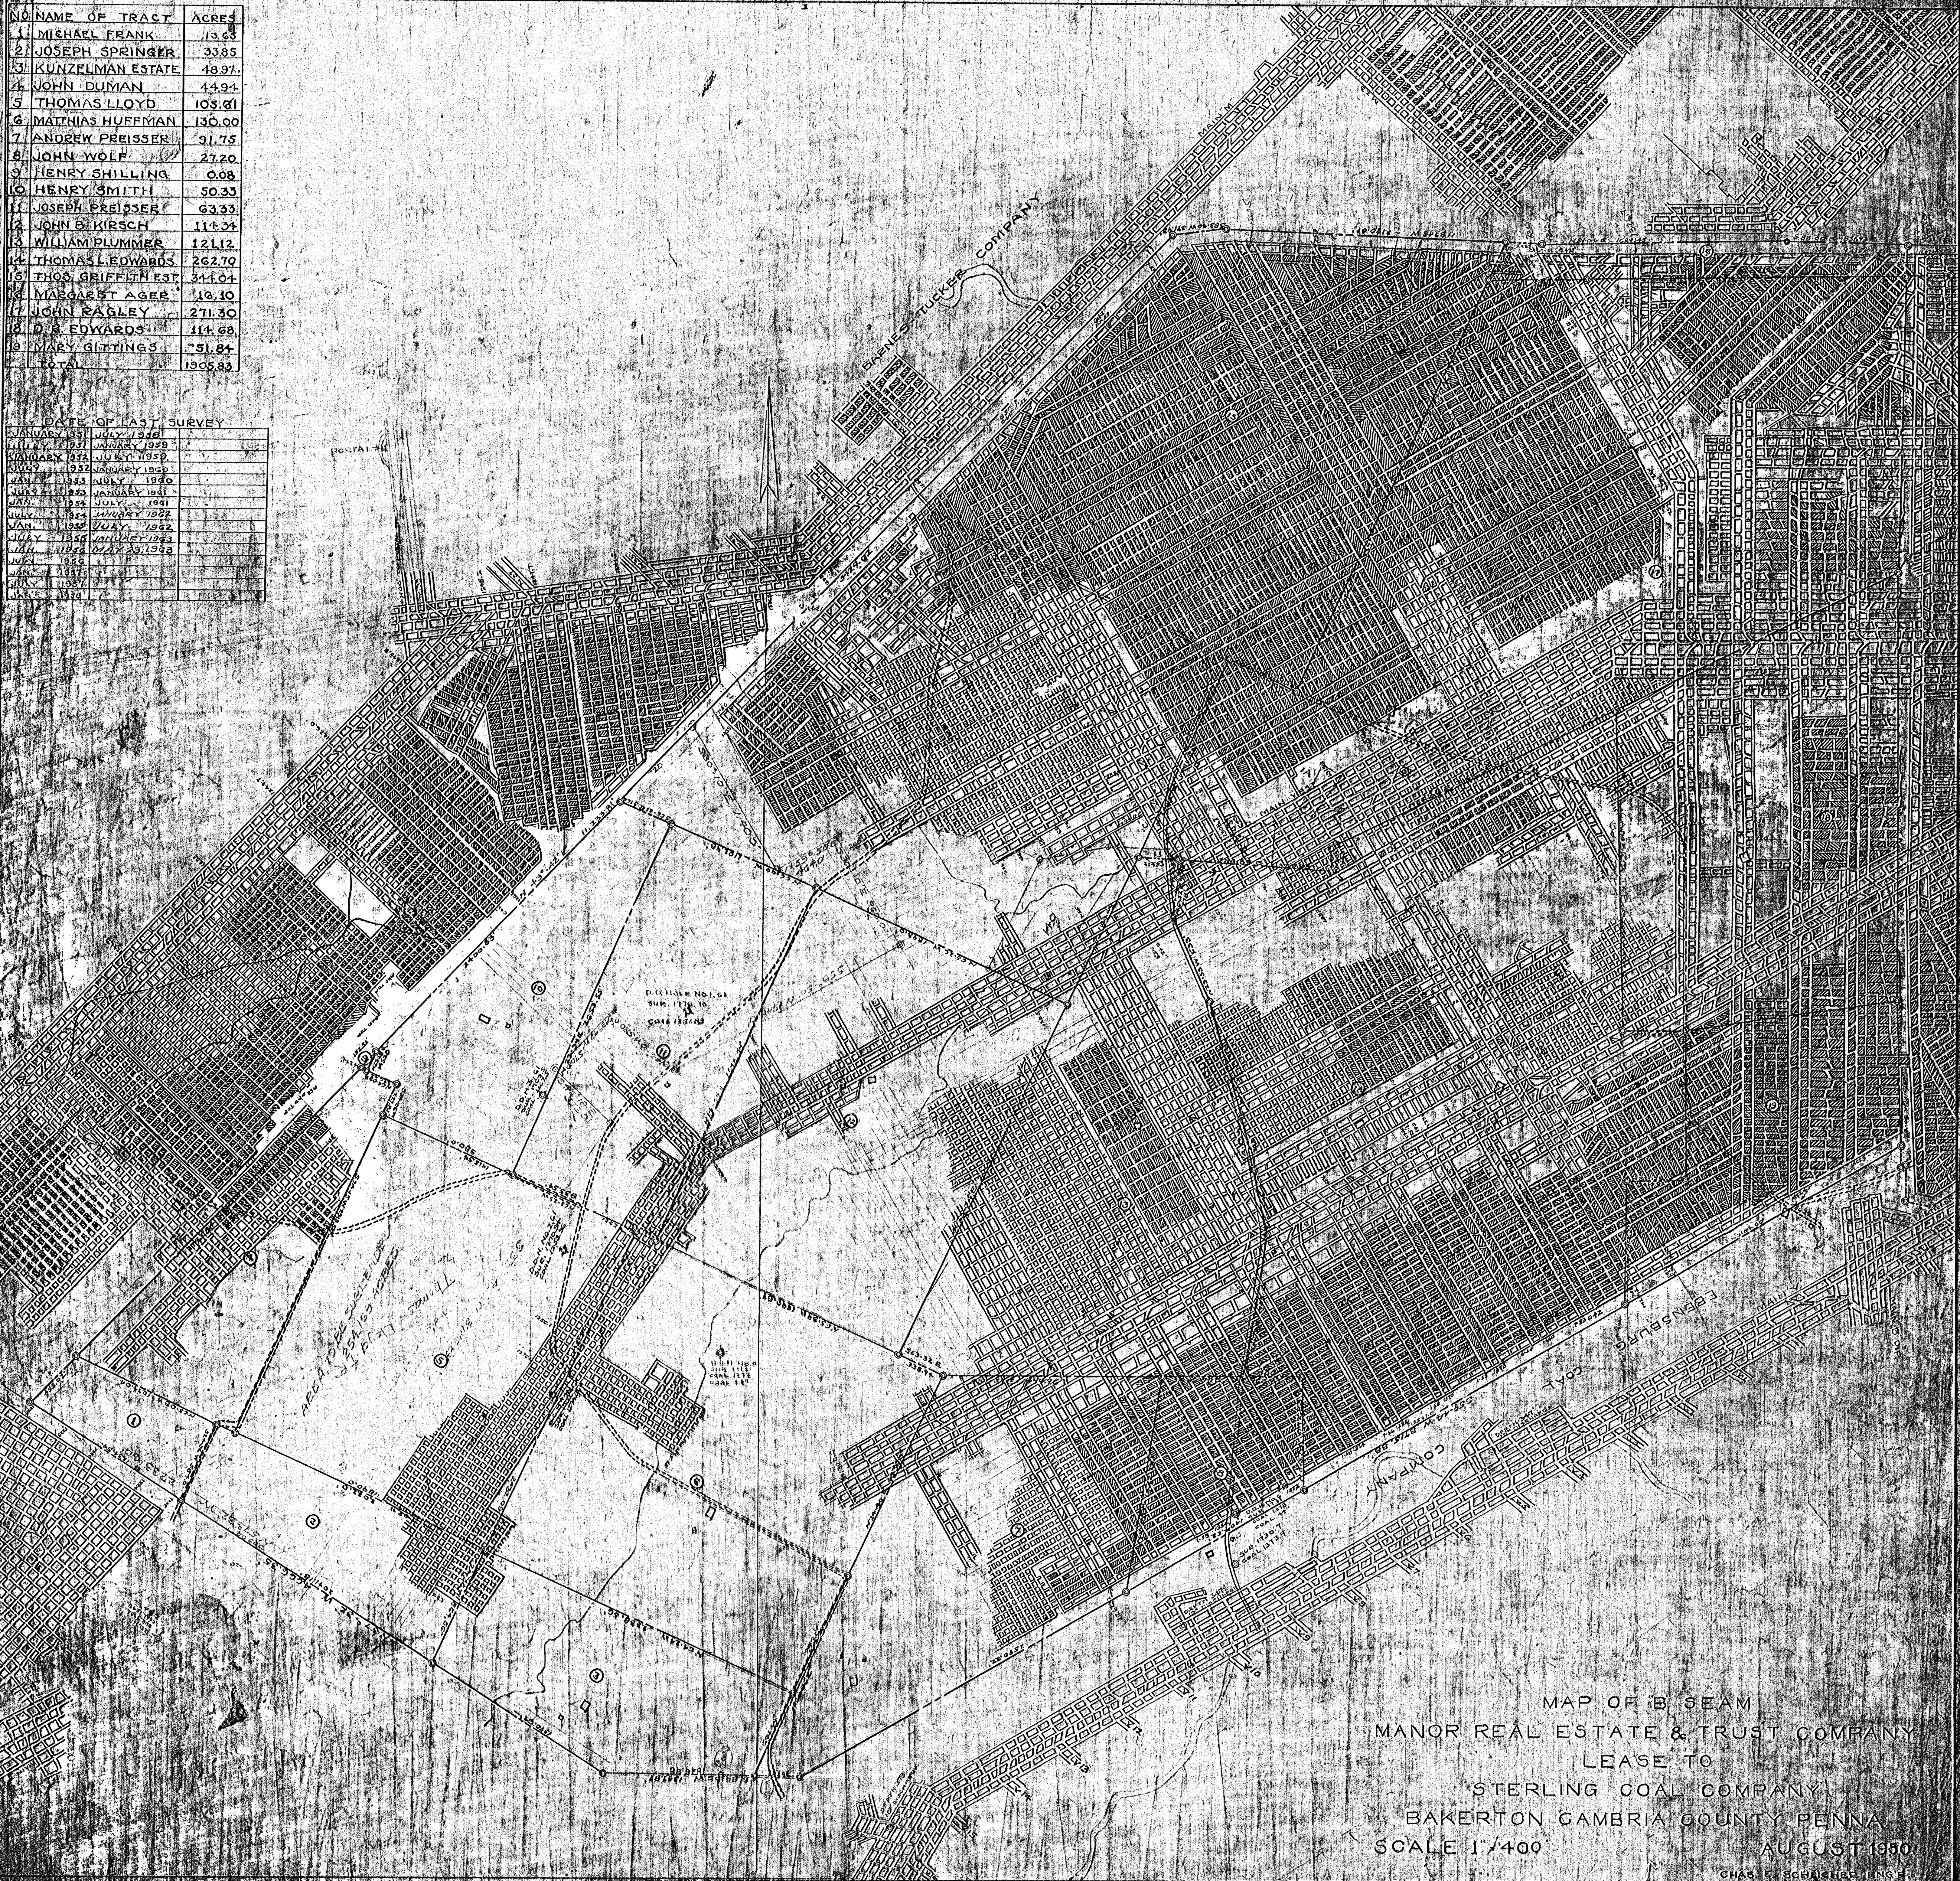

MAP OF B. SEAM
MANOR REAL ESTATE & TRUST COMPANY
LEASE TO
STERLING COAL COMPANY
BAKERTON CAMBRIA COUNTY PENNA.
SCALE 1"=400
AUGUST 1930