


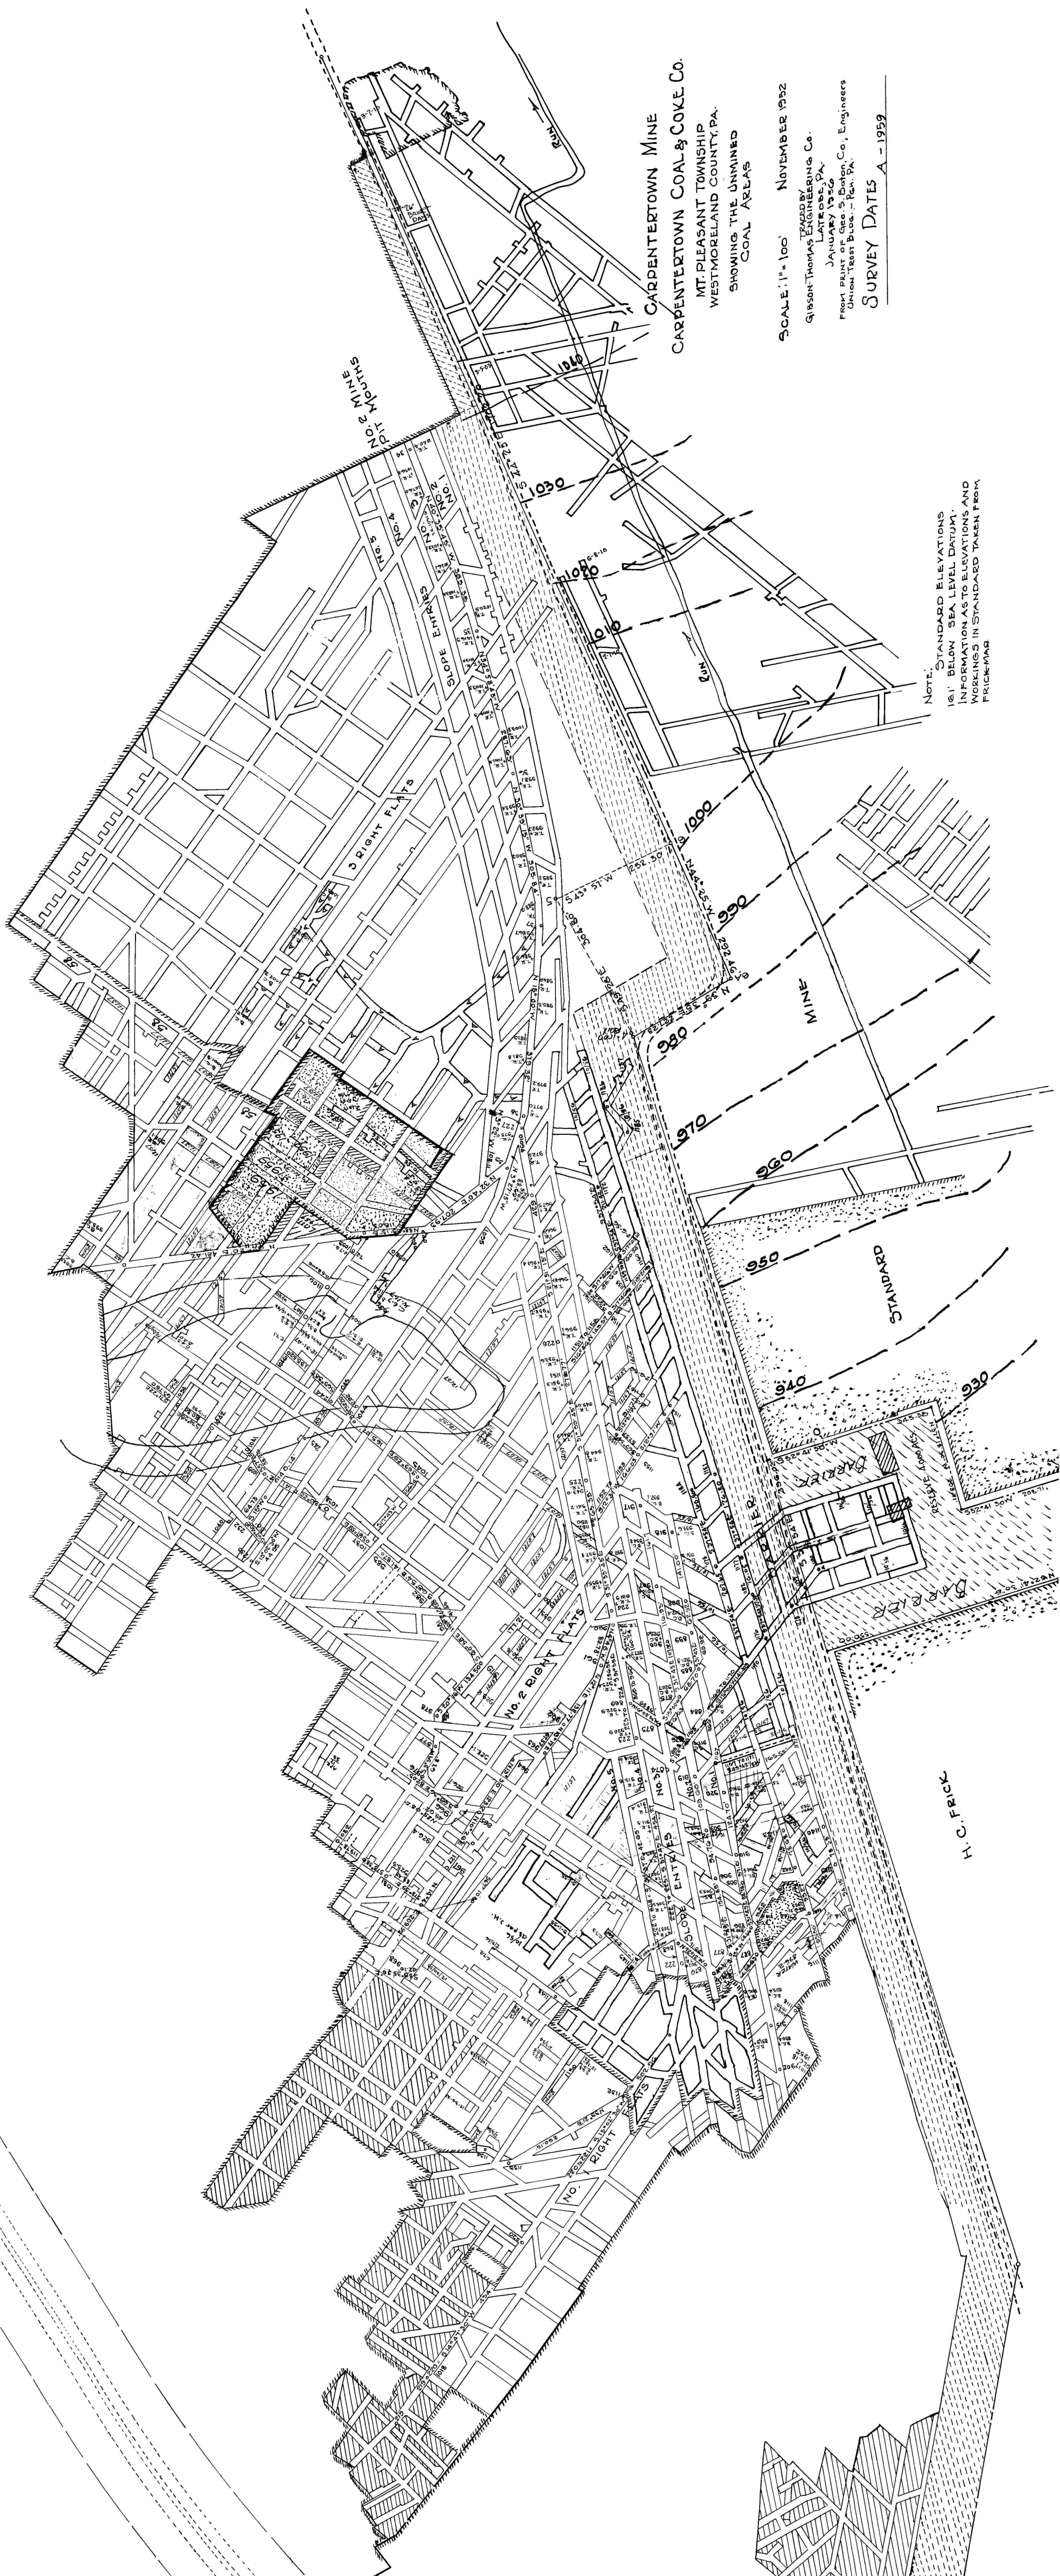

CARPENTERTOWN MINE
CARPENTERTOWN COAL & COKE CO.
MT. PLEASANT TOWNSHIP
WESTMORELAND COUNTY, PA.
SHOWING THE UNMINED
COAL AREAS

SCALE: 1" = 100'
NOVEMBER 1952
TRACED BY
GIBSON-THOMAS ENGINEERING CO.
LATE 1952
JANUARY 1953
FROM ENGINEERING CO., ENGINEERS
UNION TRUST BLDG. - PITTSBURGH, PA.
SURVEY DATES A - 1959

NOTE: STANDARD ELEVATIONS
161' BELOW SEA LEVEL DATUM.
INFORMATION AS TO ELEVATIONS AND
WORKINGS IN STANDARD TAKEN FROM
FRICK-MAR

H. C. FRICK