


54520-3
SHEET 0-17

DEEP MINE SAFETY 100

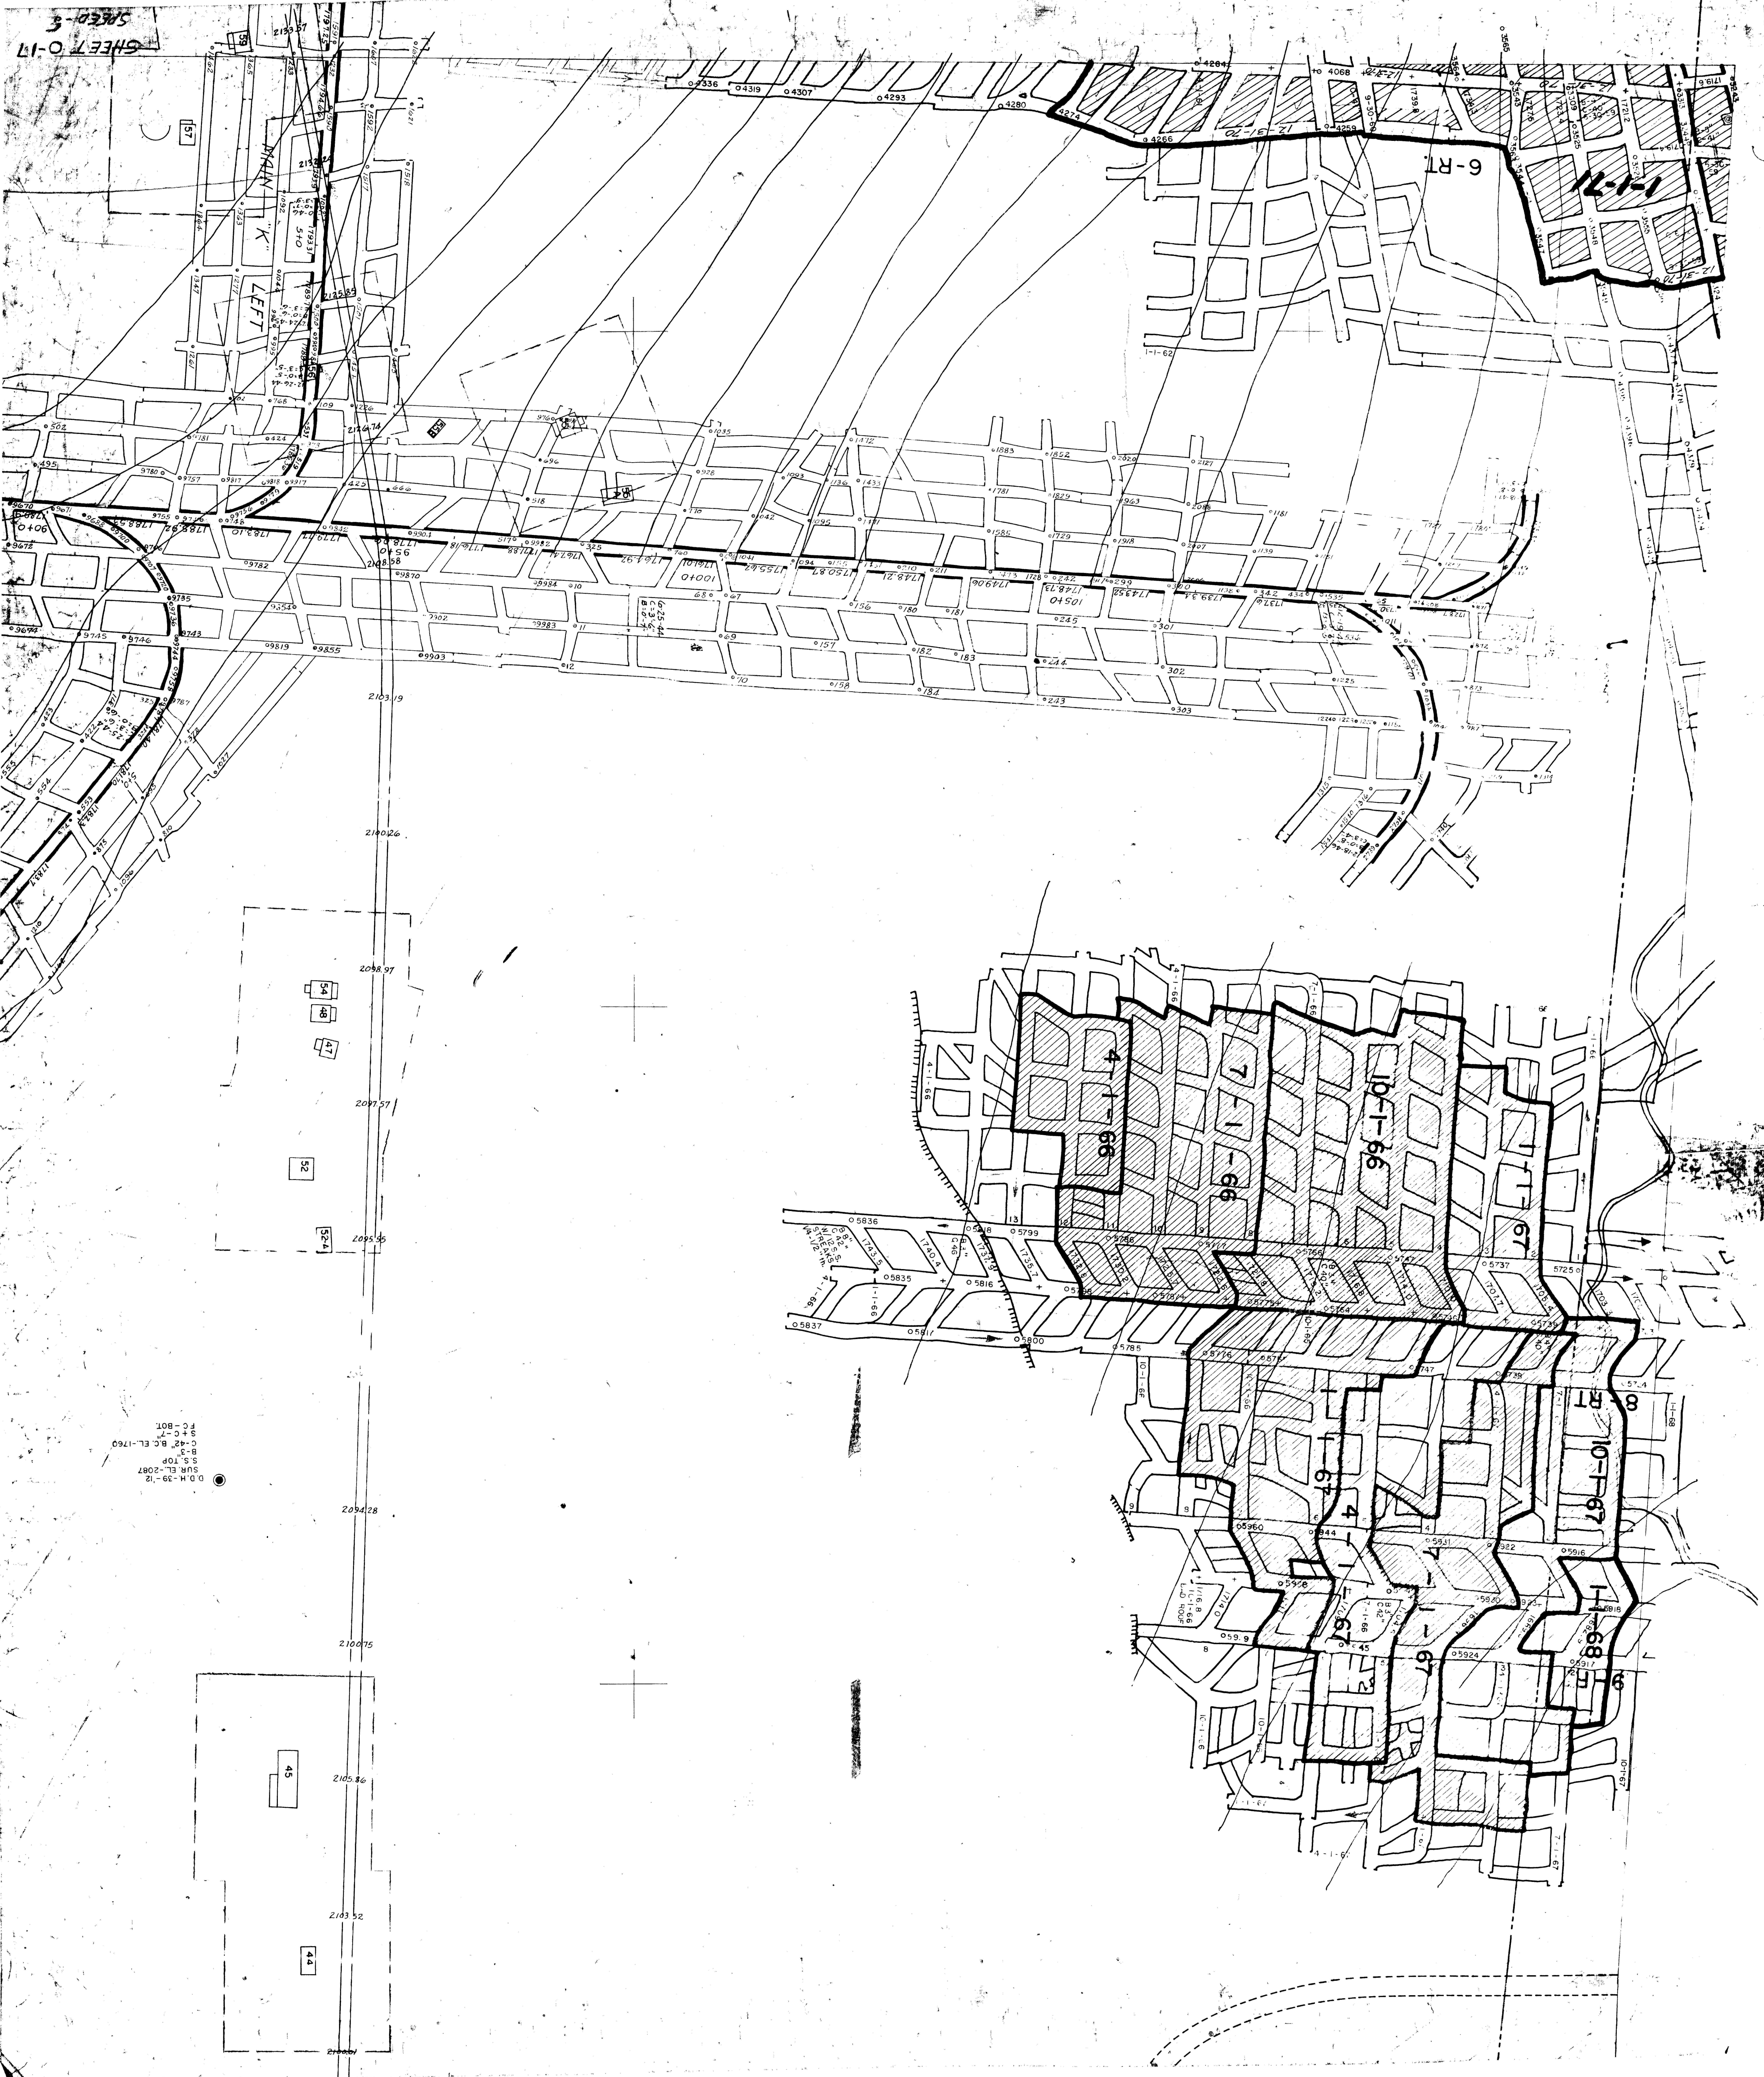

D.M.-39-10
SUR. EL. -2087
S.S. TOP
B.C. 42' B.C. EL. -1760
F.C. -801