


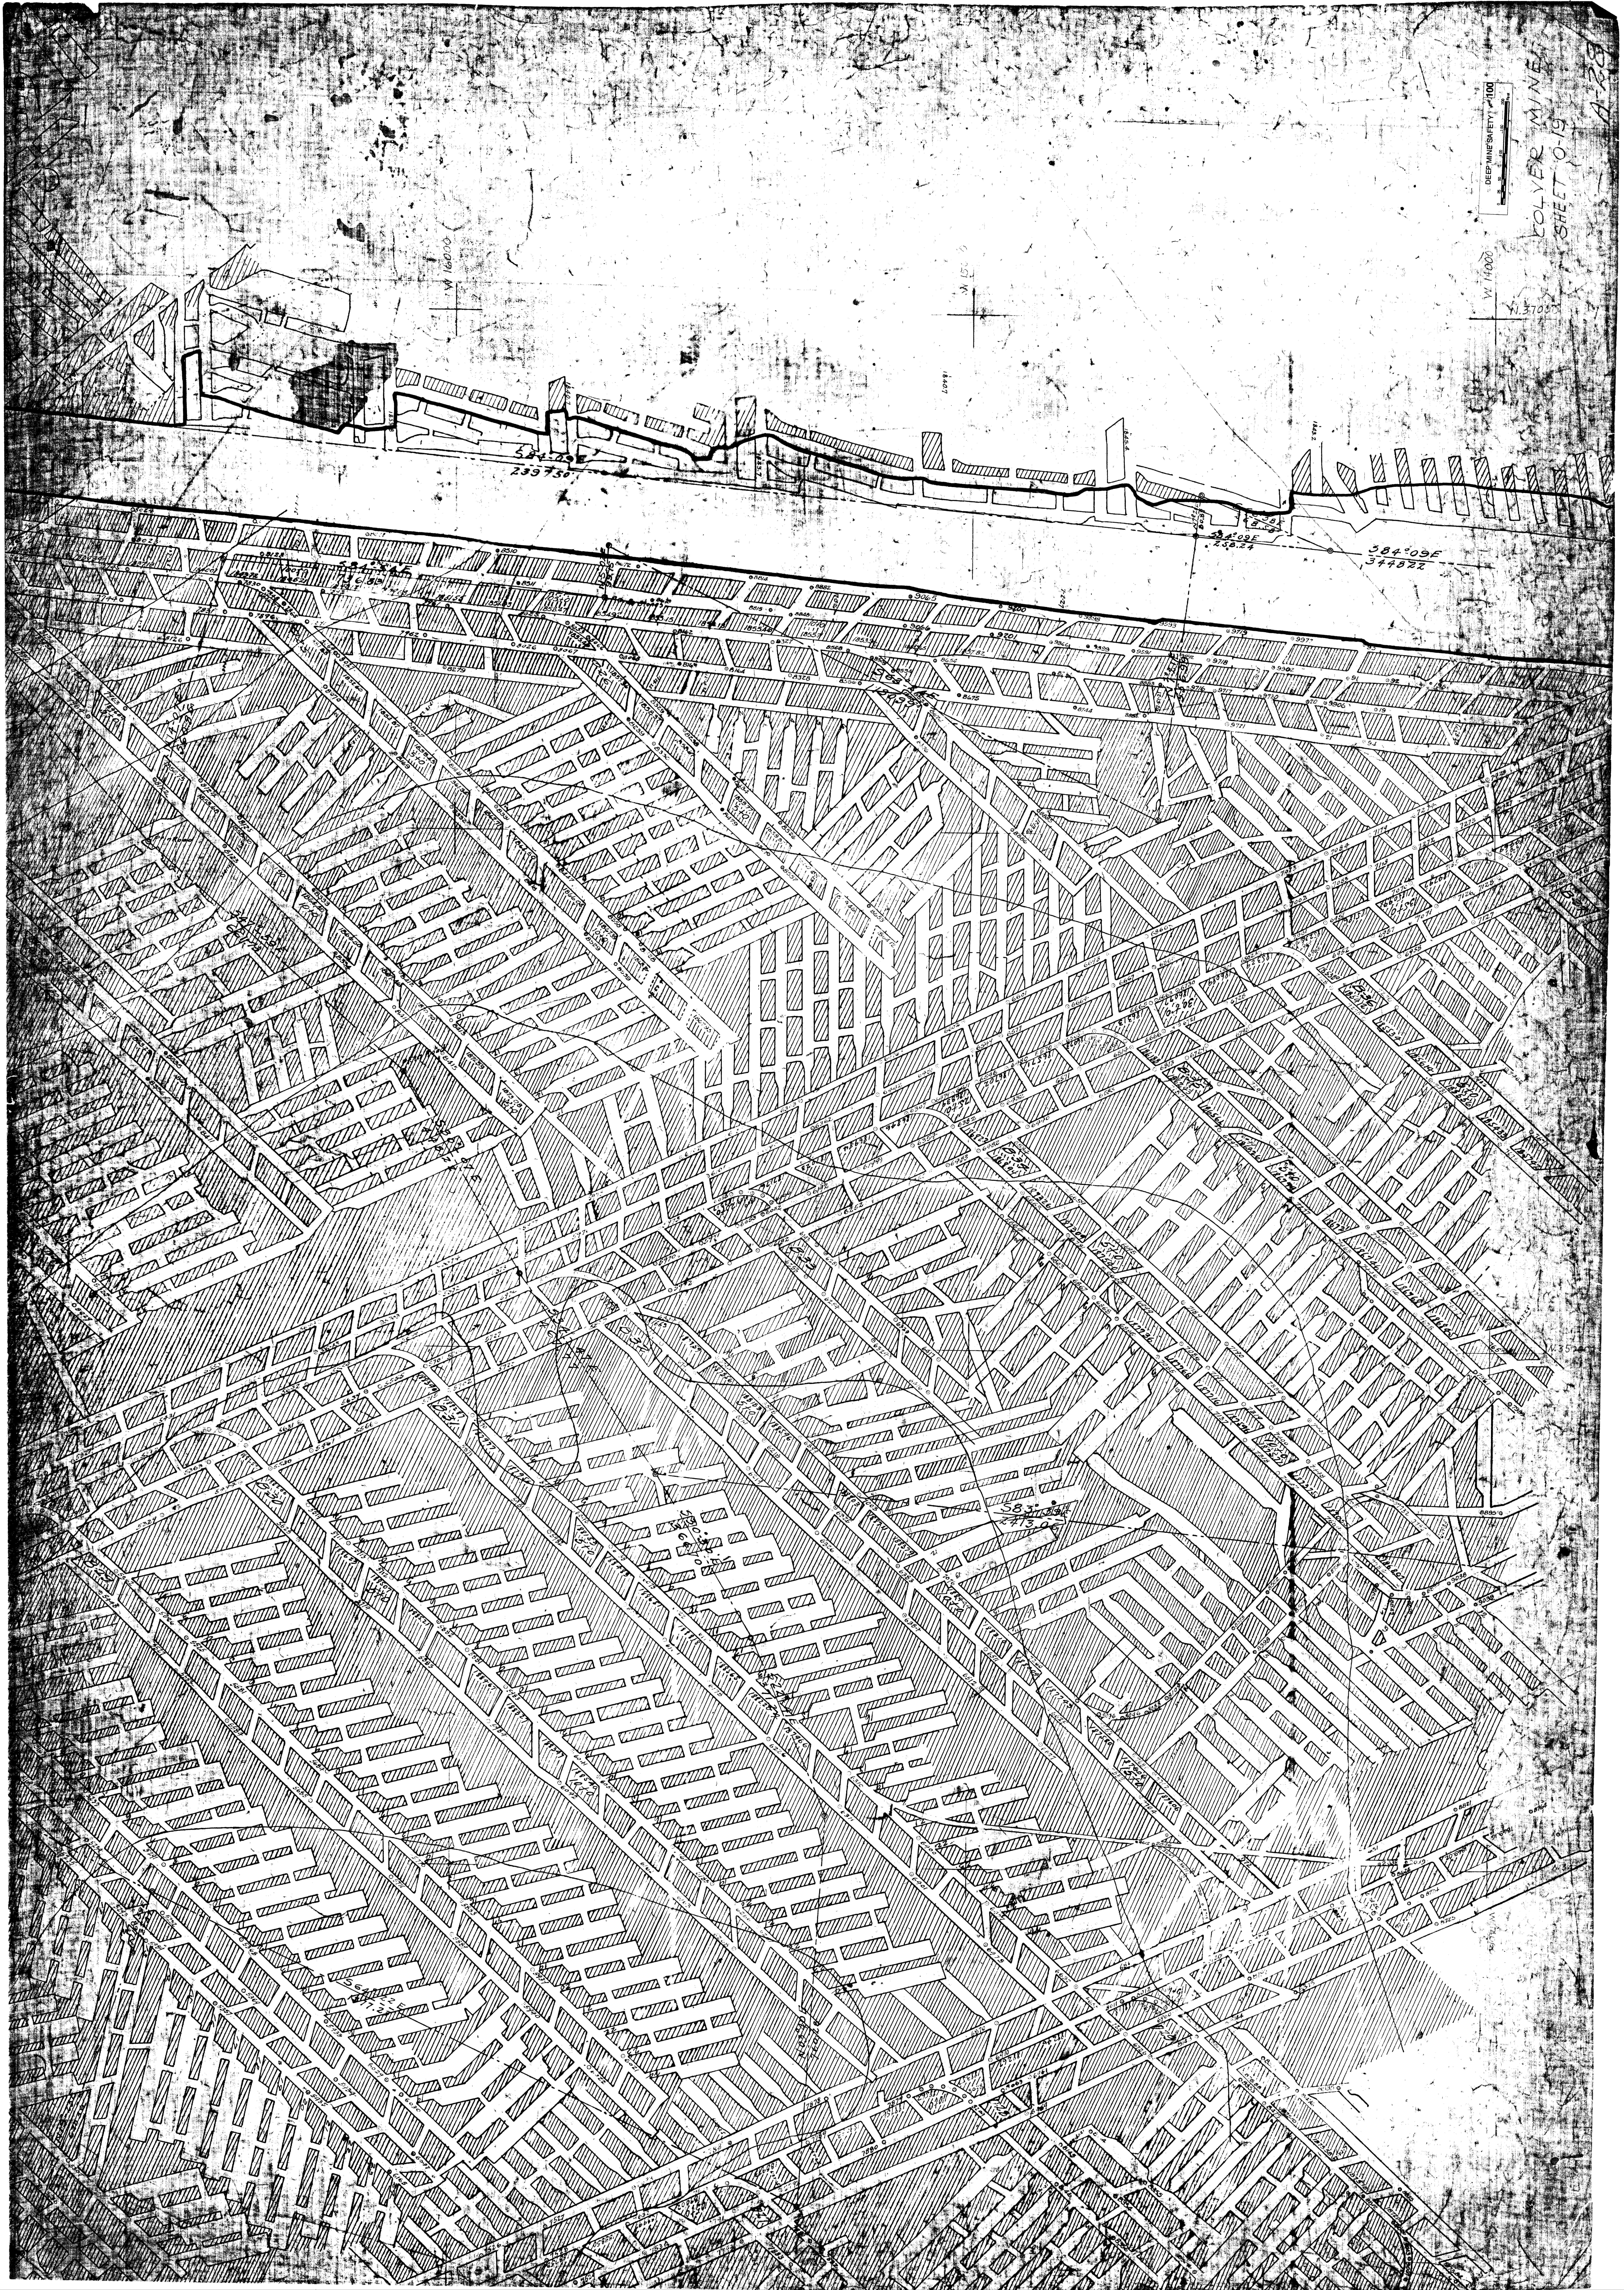

DEEP MINES SHEET 100

POLVER MINE
SHEET 0-19

1-23

W 16000

W 15000

W 11000

584-20
239730

584-09F
25024

584-09F
344822


