


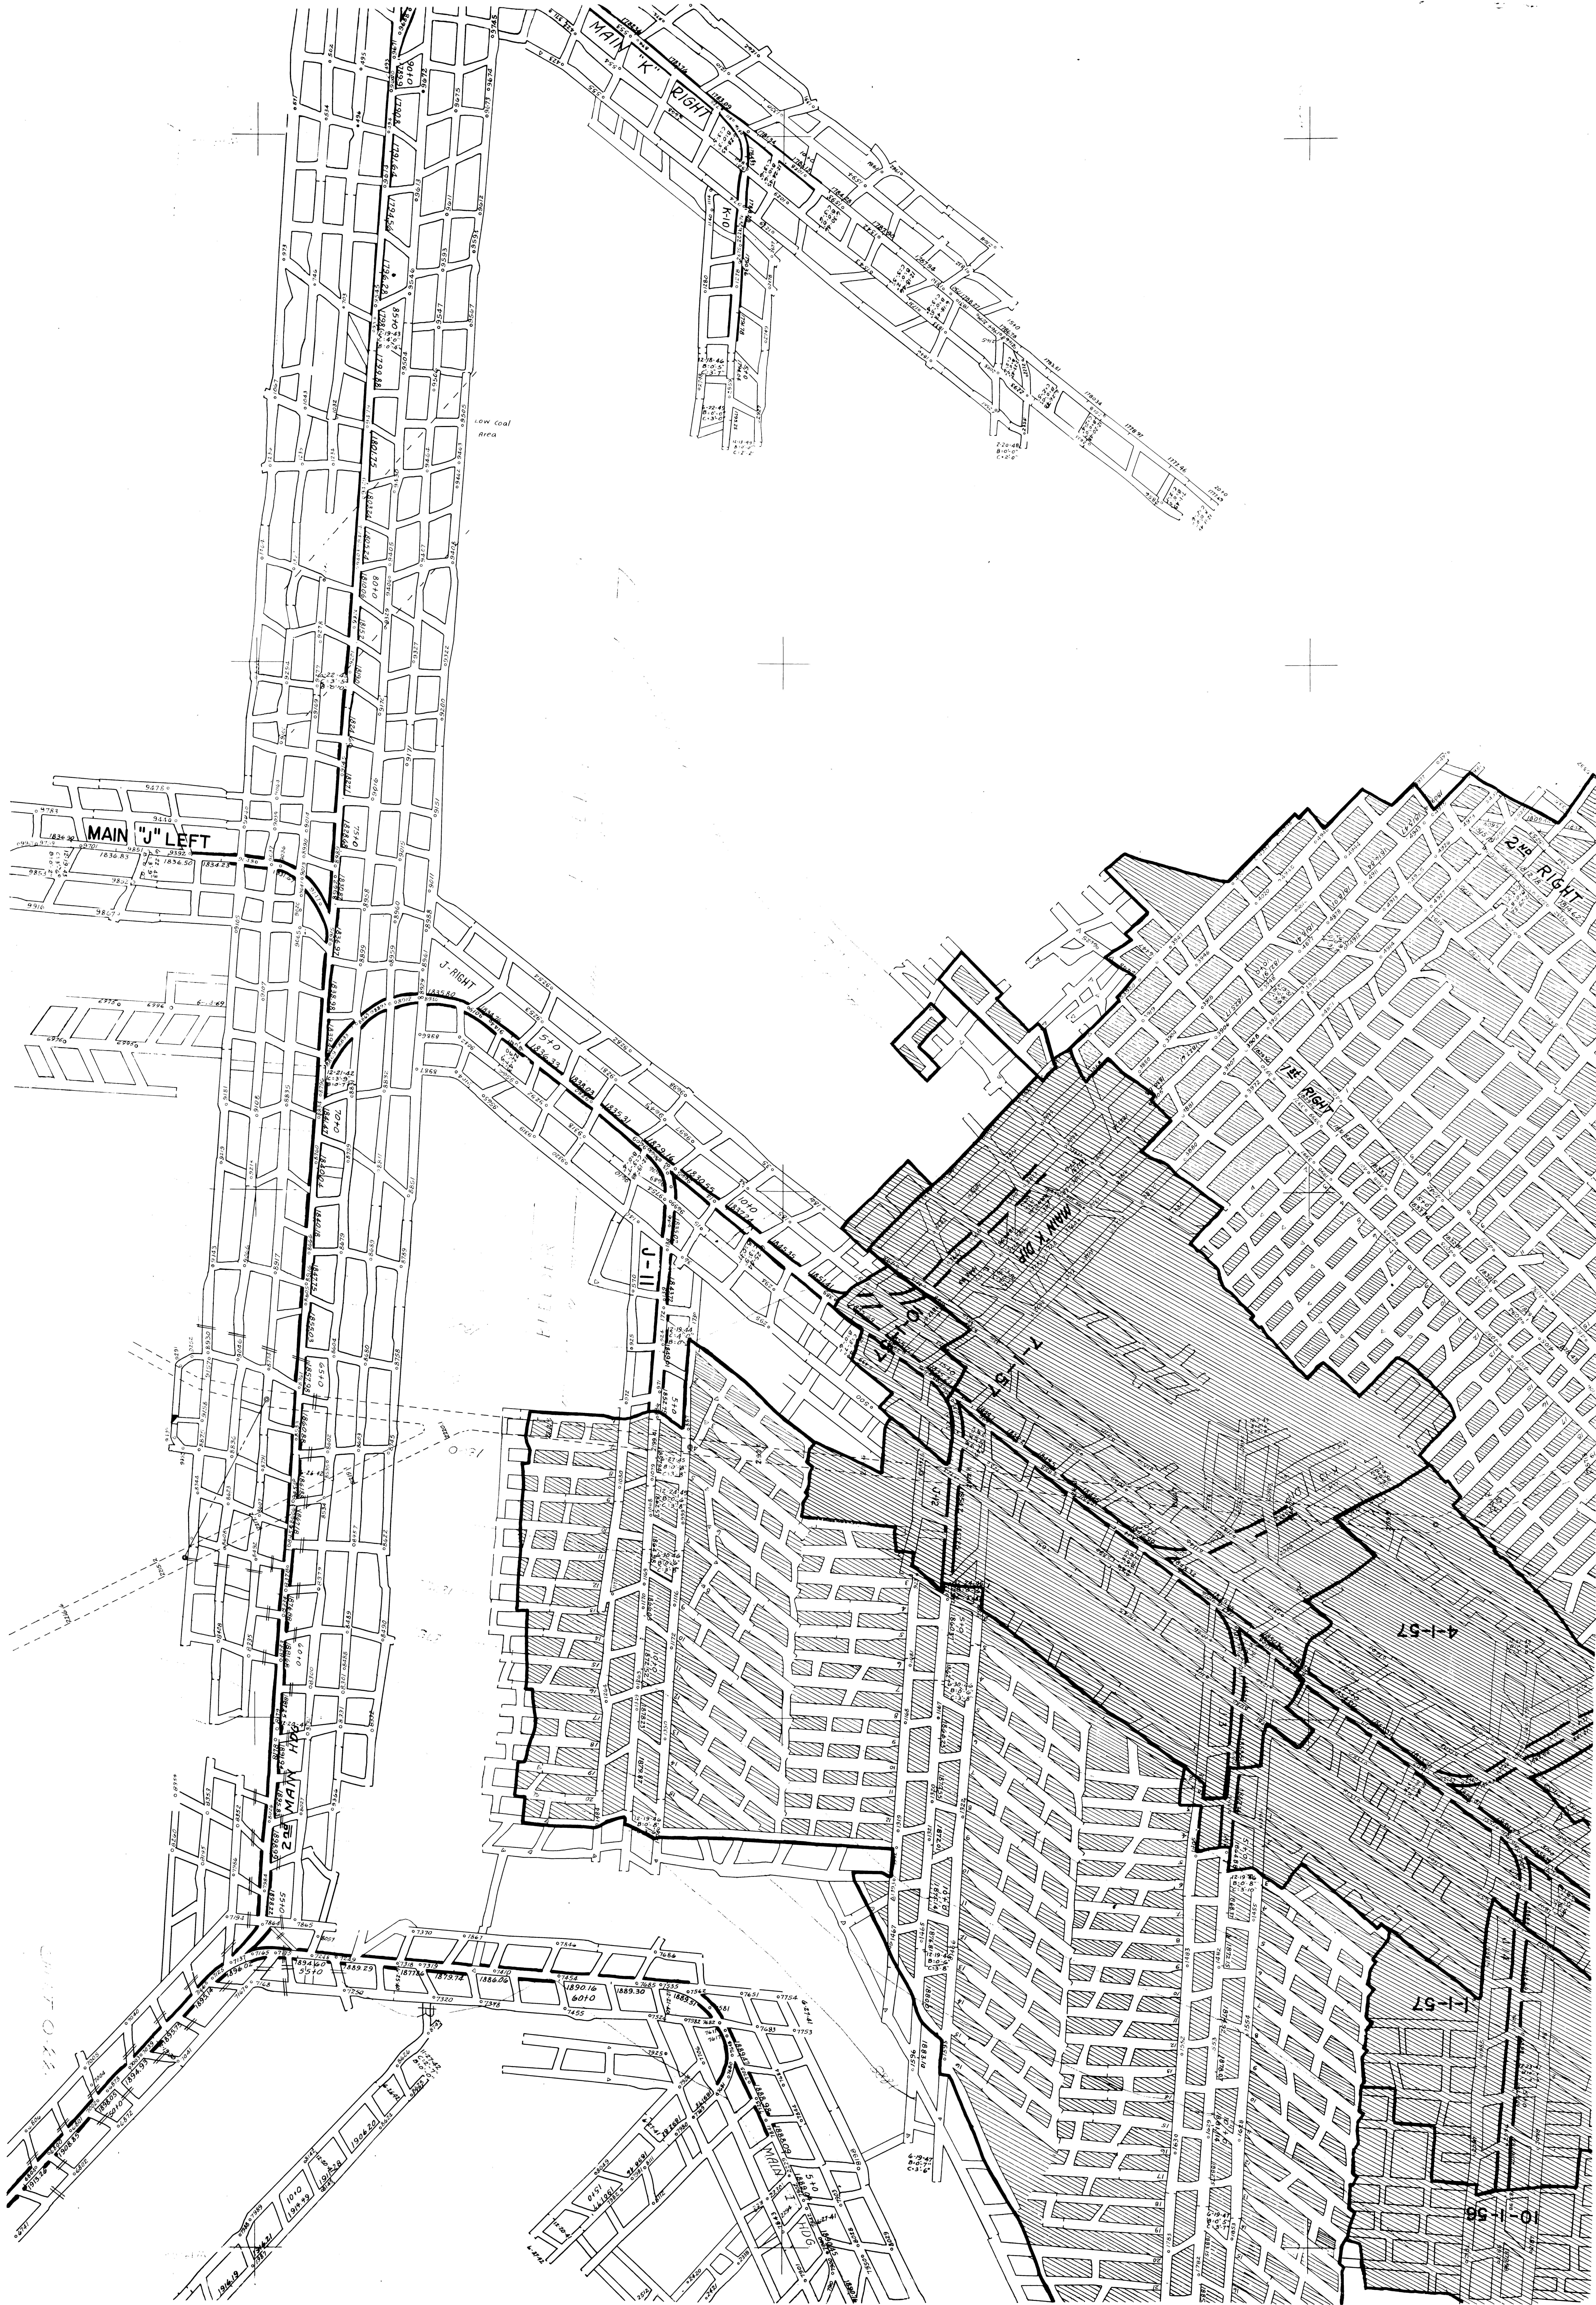

DEEP MINE SAFETY