


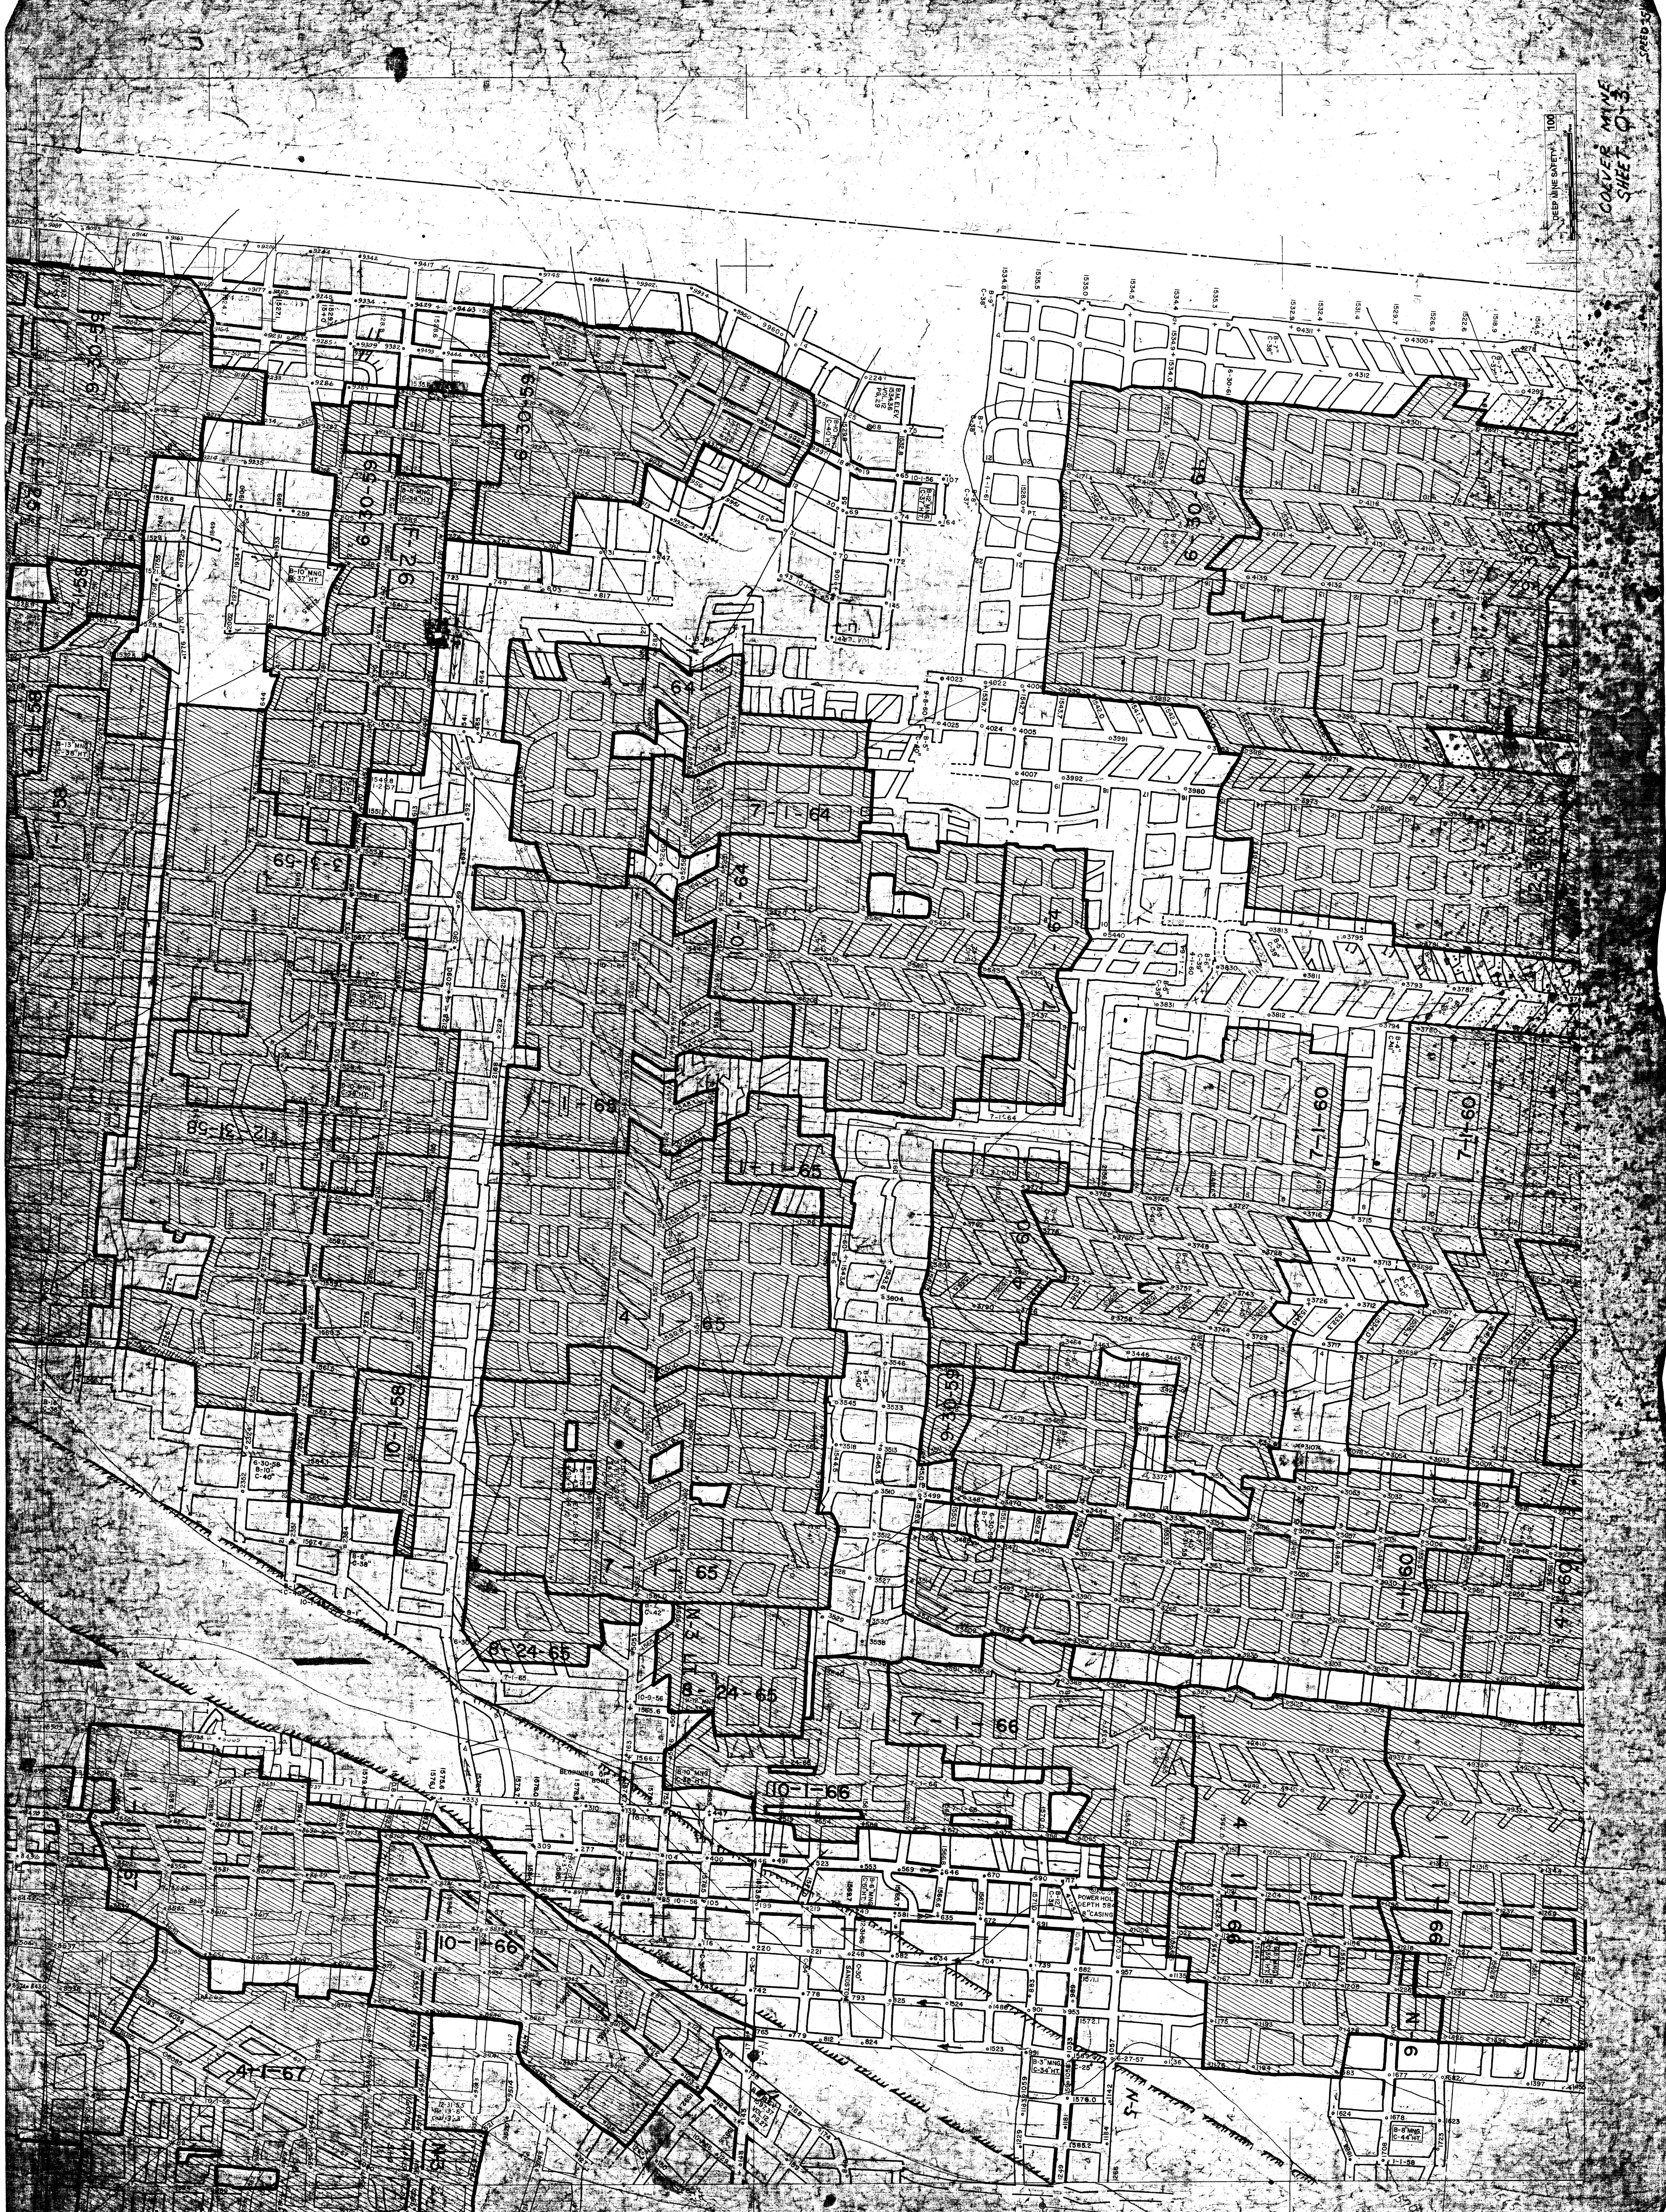

SHEET 10-3

DEEP LINE SHEET 100