


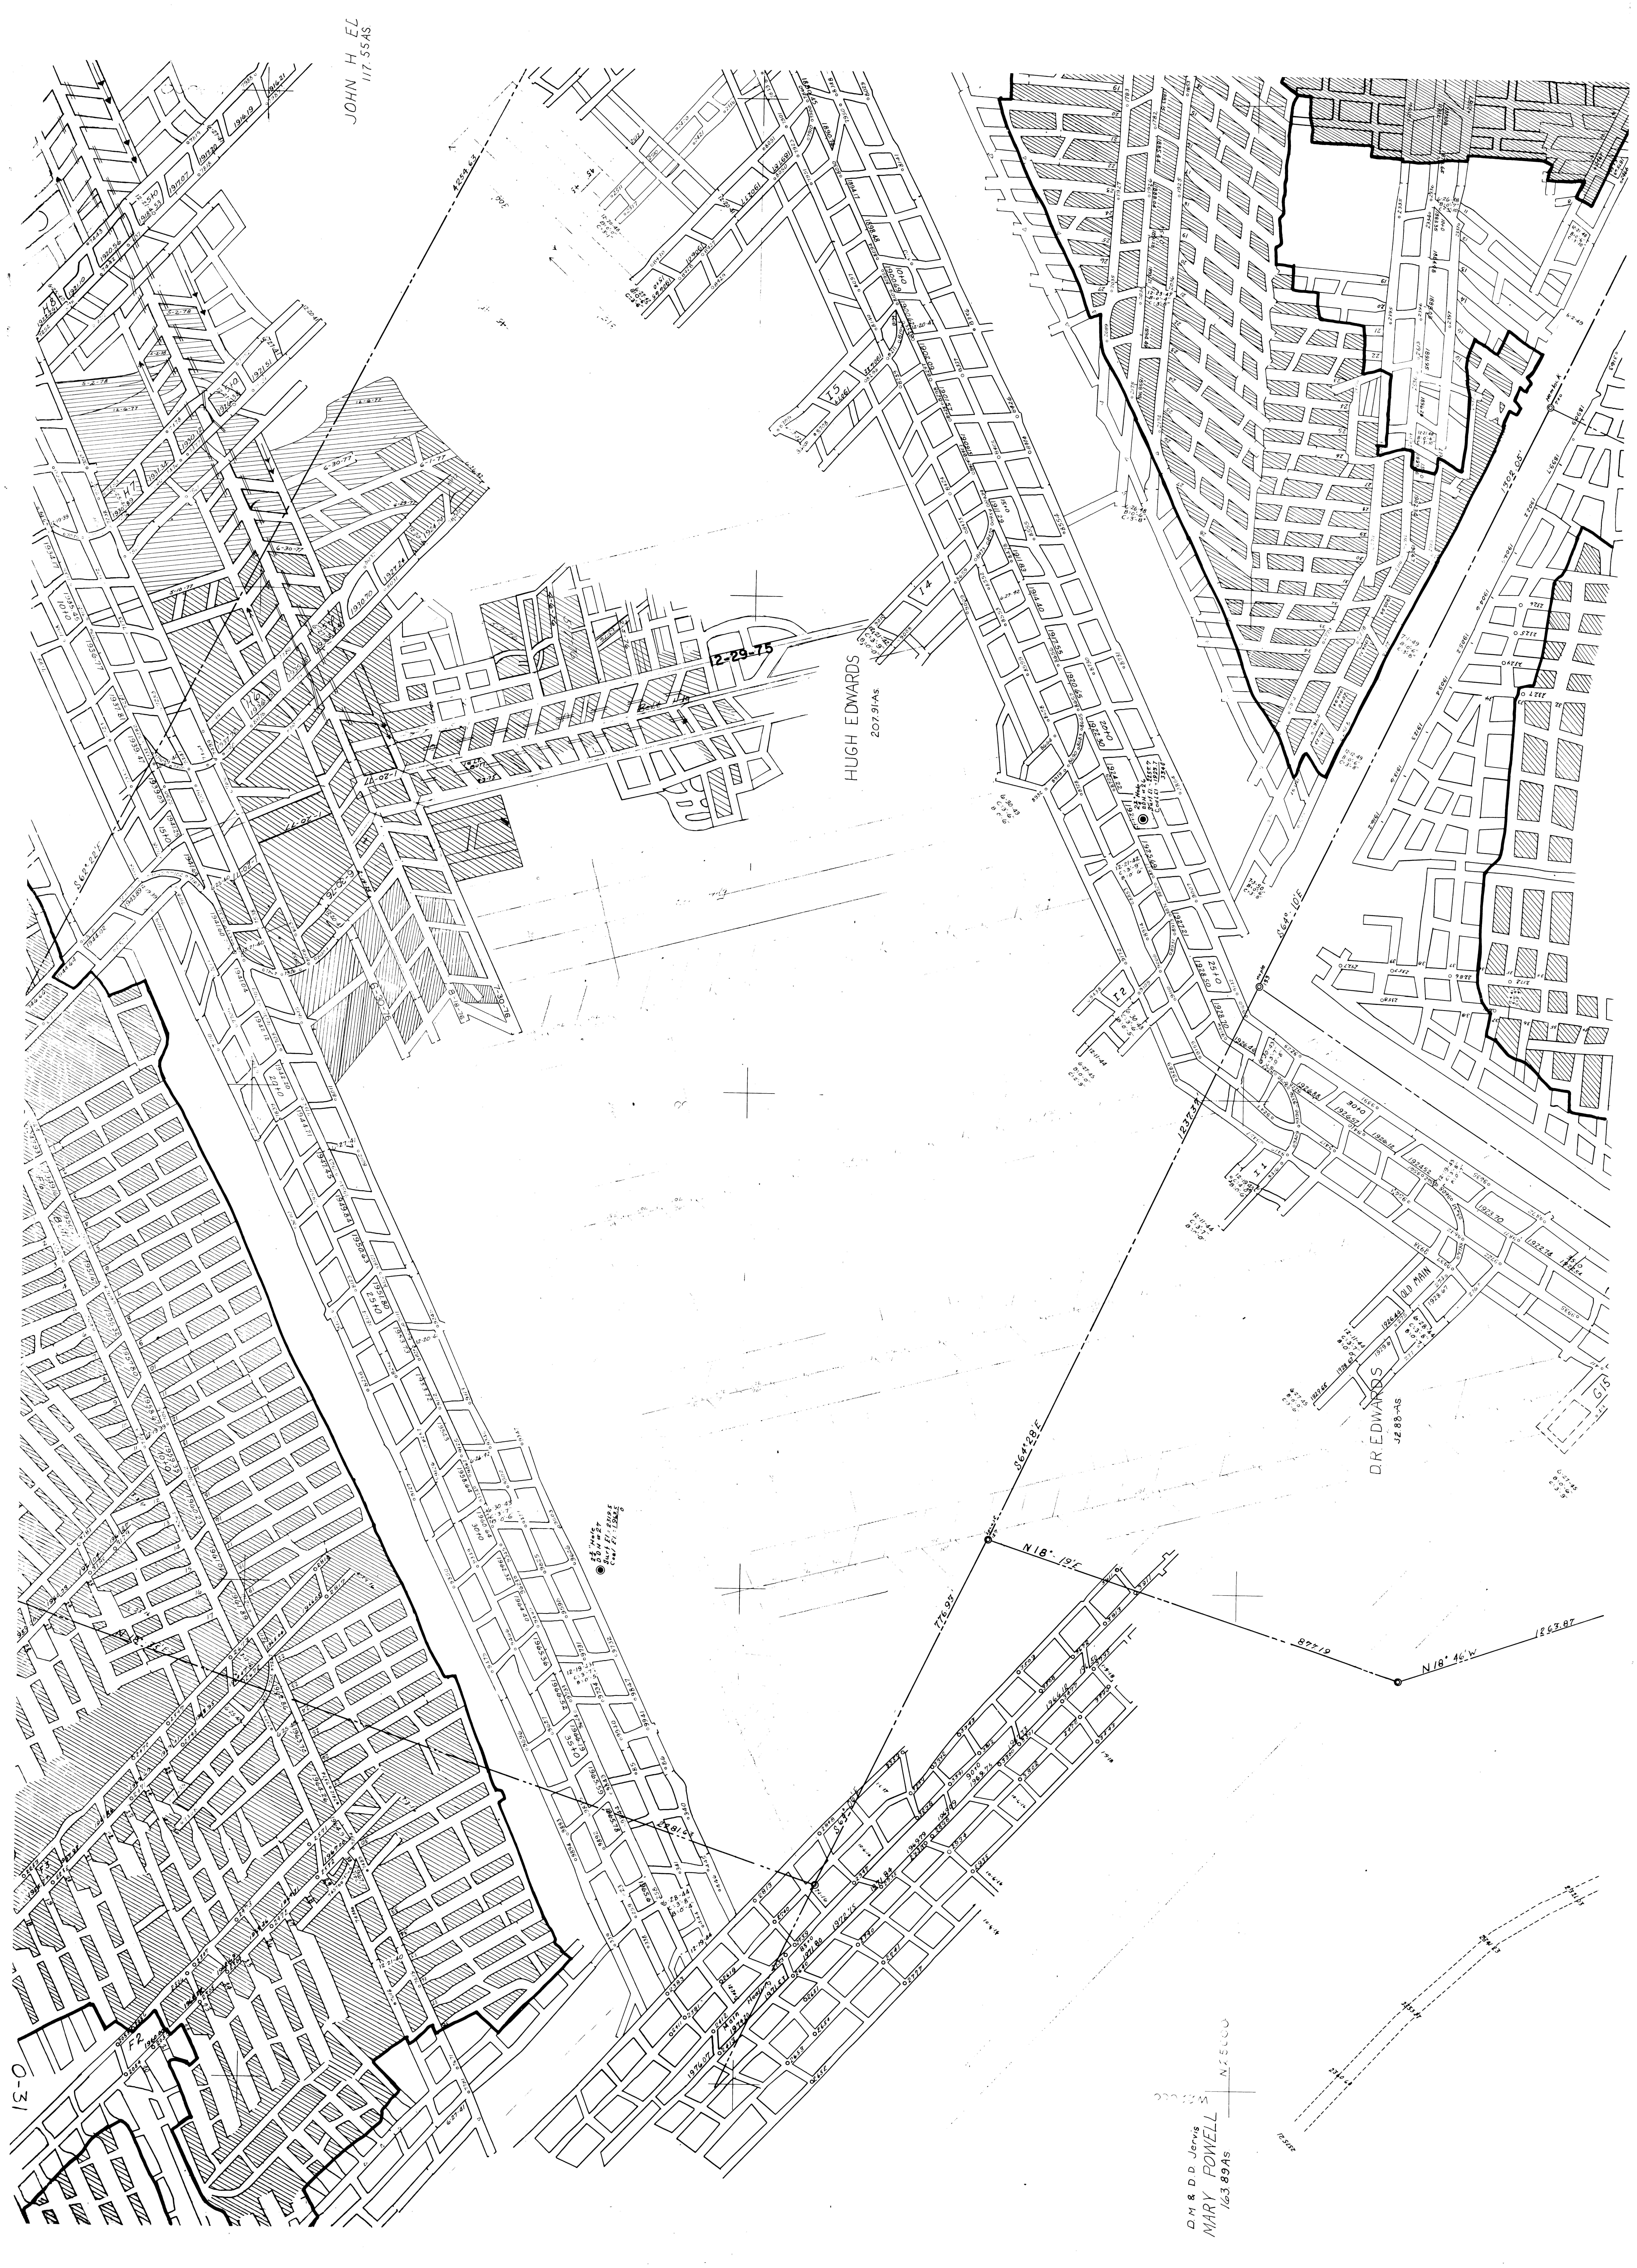

JOHN H. EL
117.5545

2-29-75

HUGH EDWARDS
207.9145

DR EDWARDS
4288-45

DM & DD Jervis
MARY POWELL
163.8945

100
DEEP MINE SAFETY