


COVER MINE
B. 5777
LOWER KATHMINE
SHEET 04
SPED 10

DEEPER SAFETY

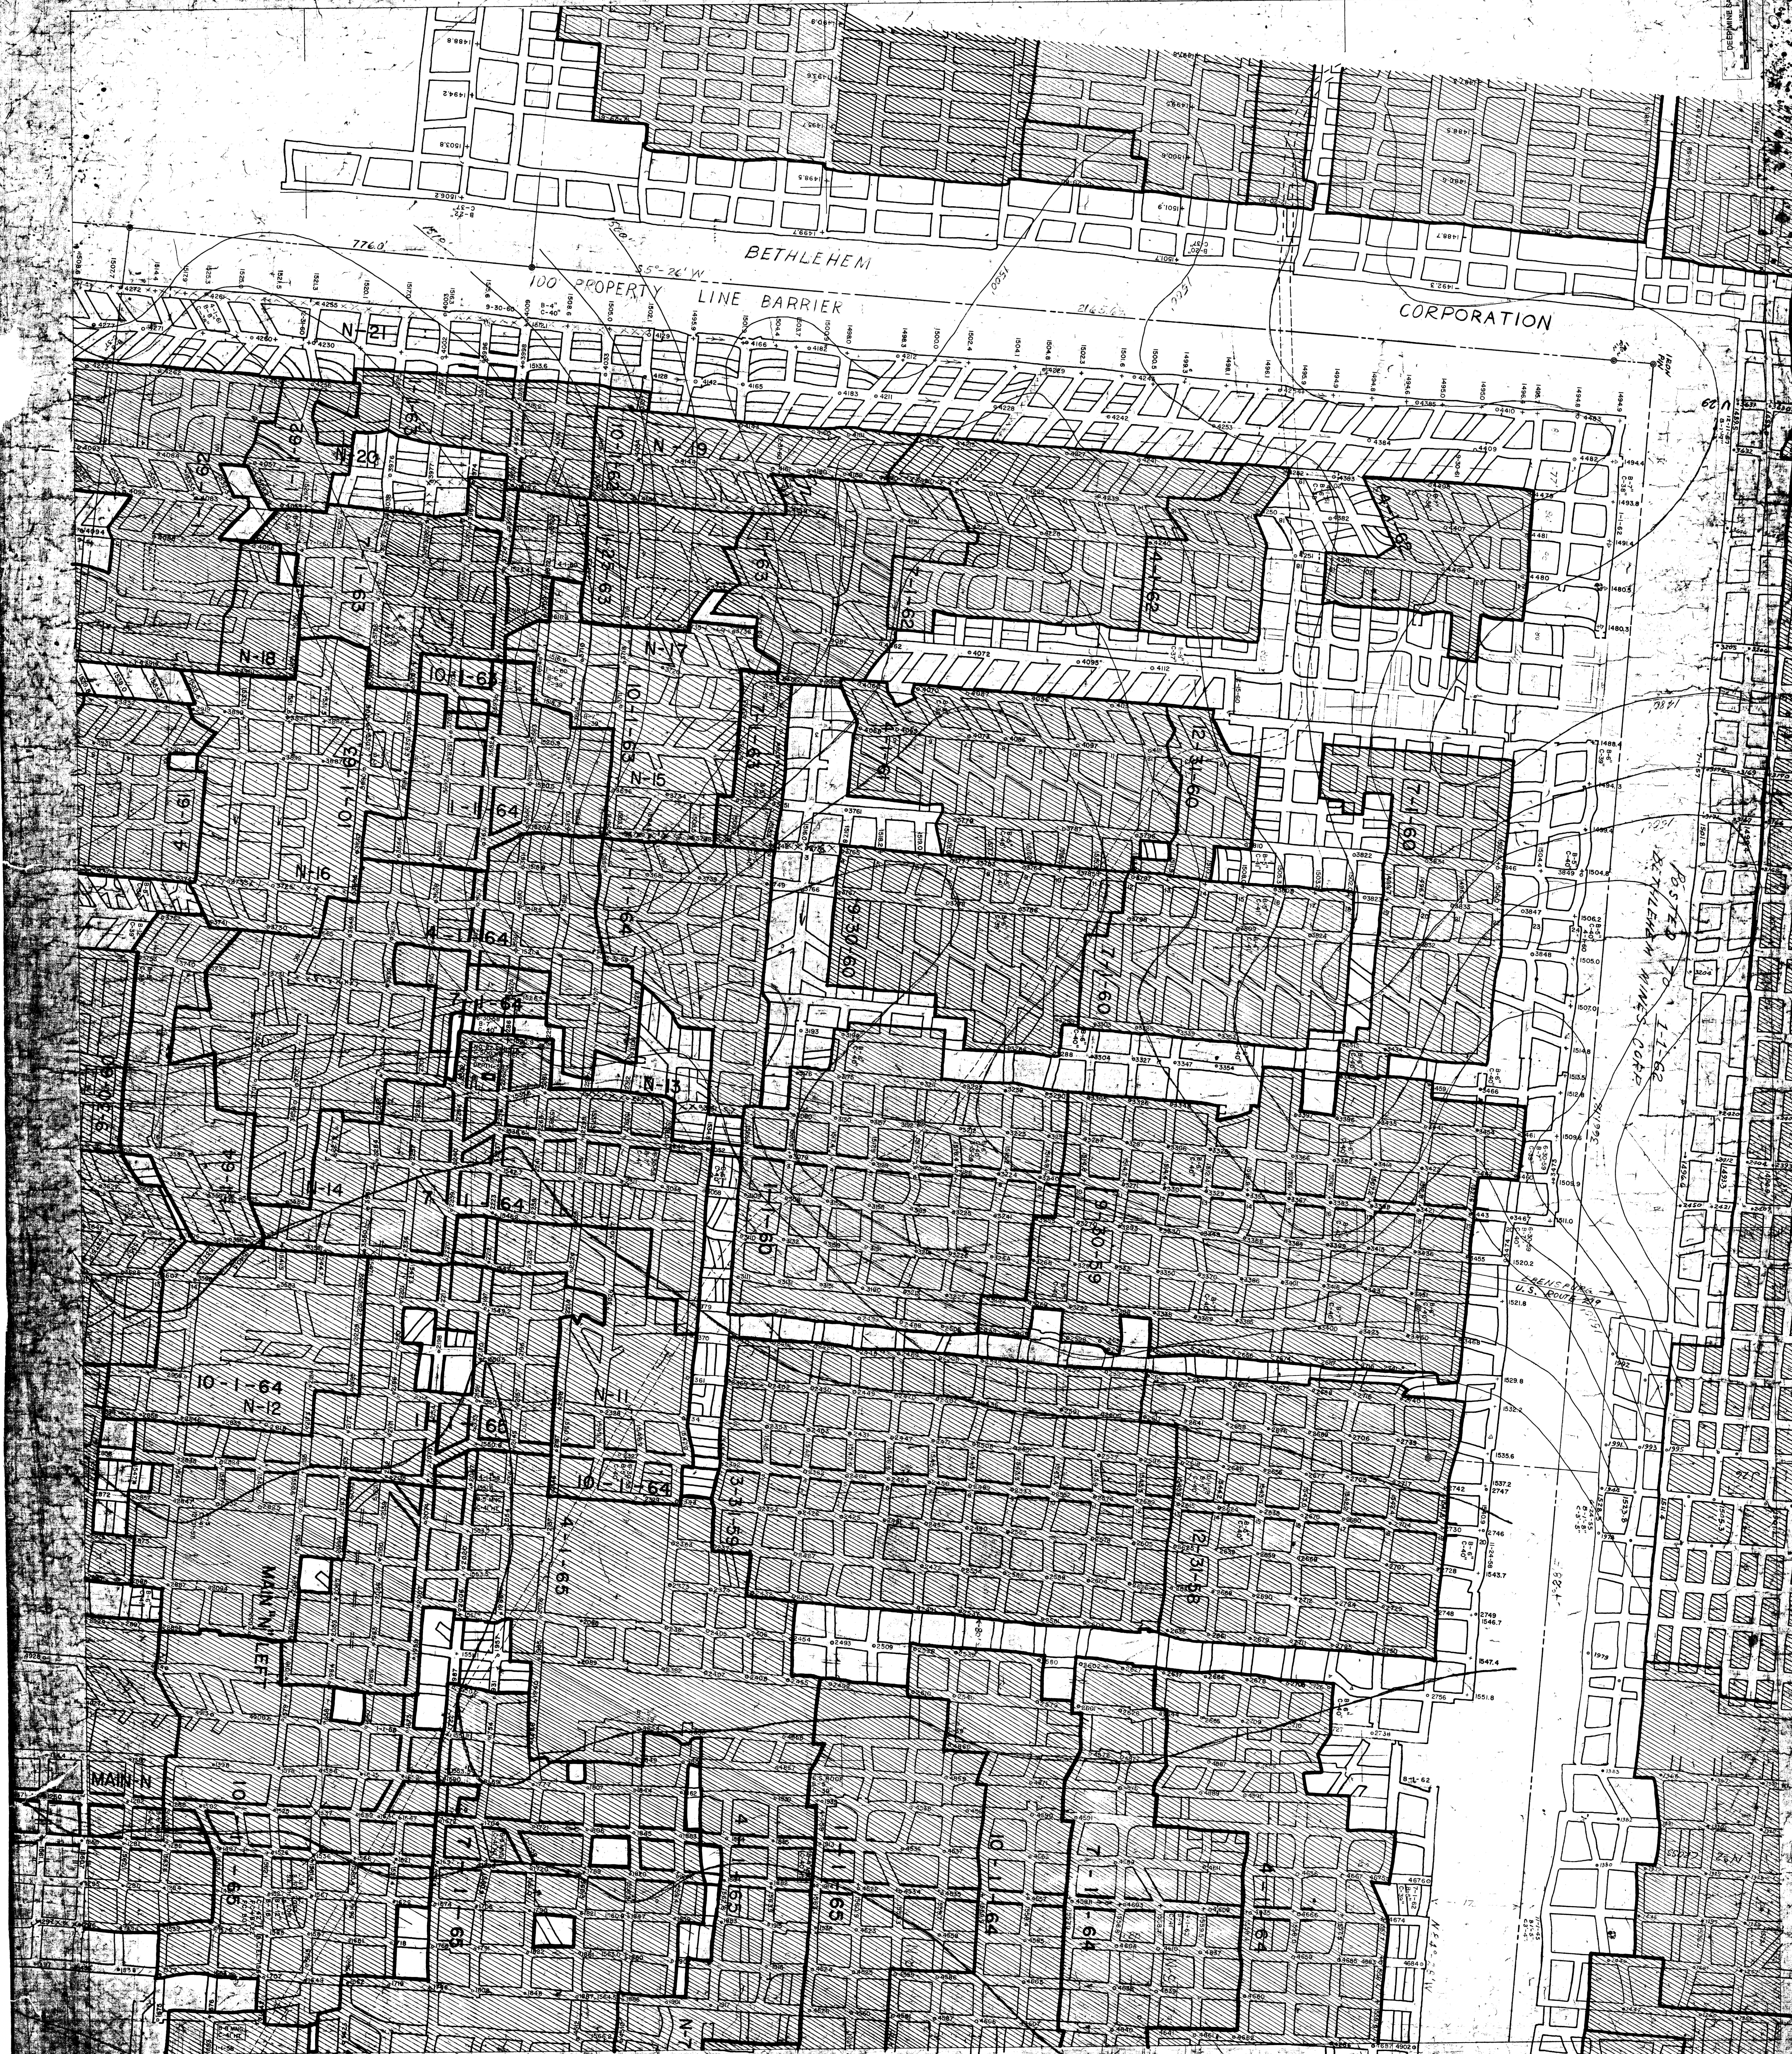

B. 5777
LOWER KATHMINE
SHEET 04
SPED 10

MAIN N

10-1-64

















