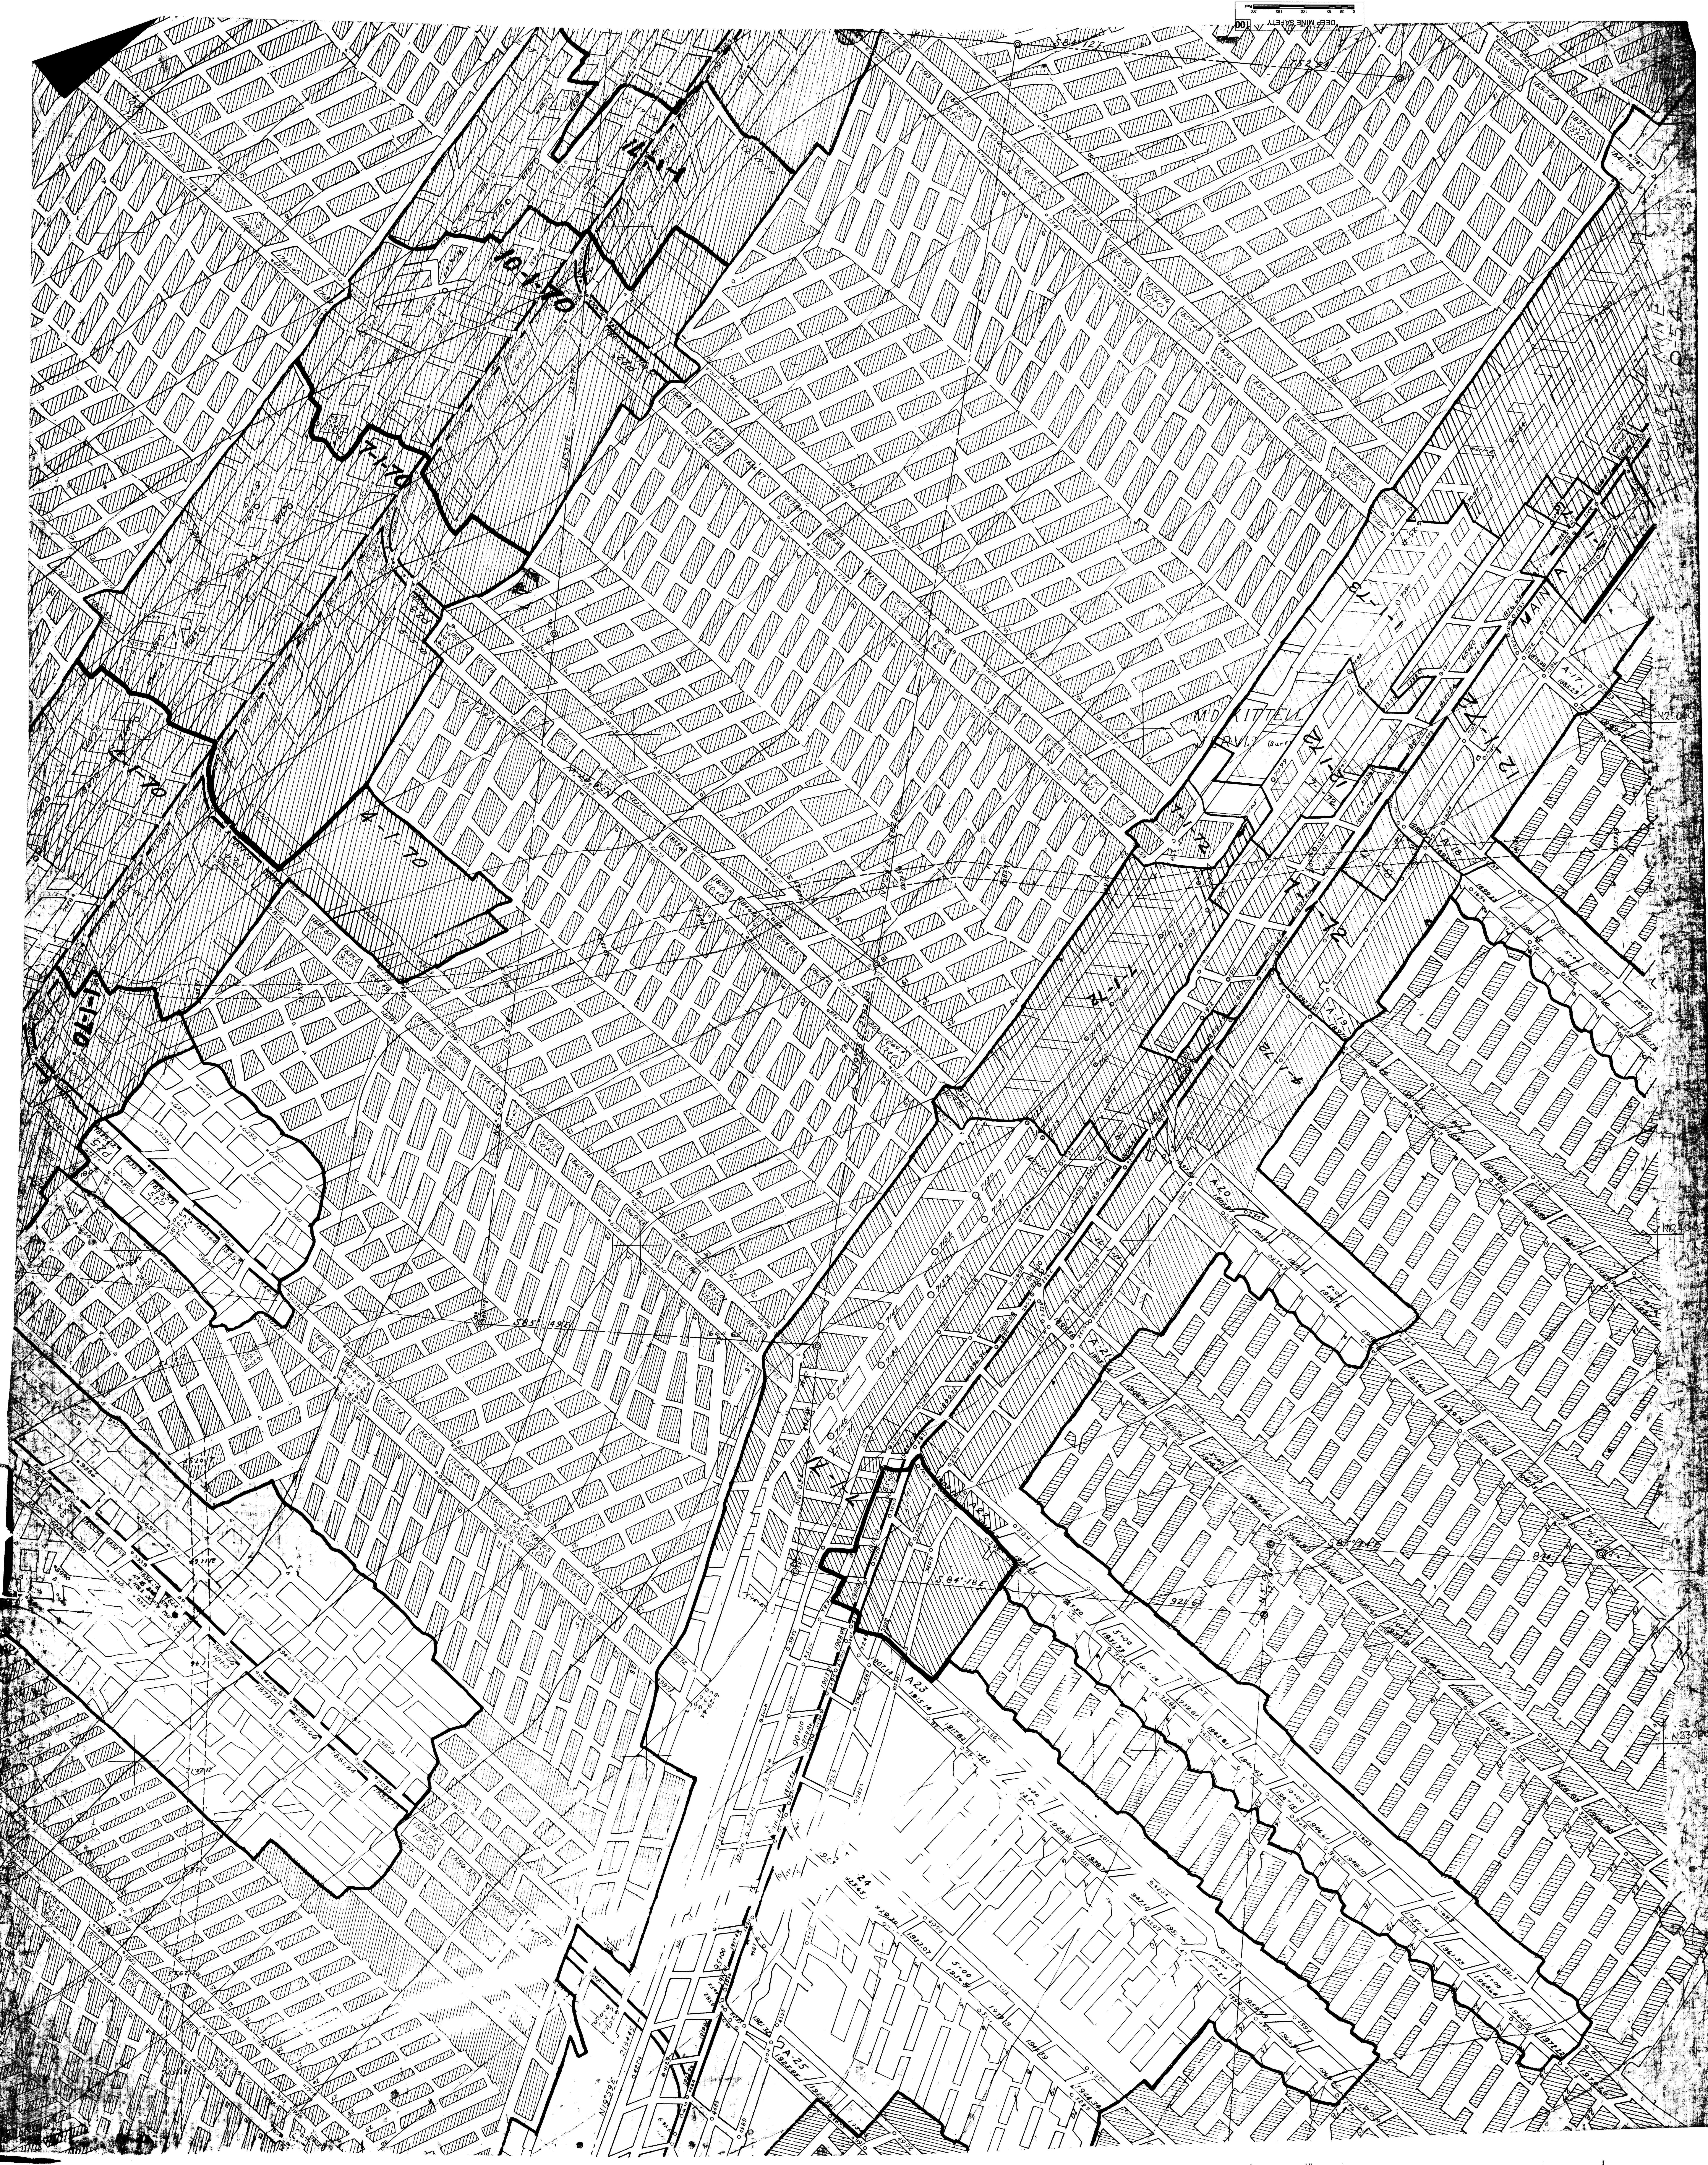
DEEP MINE SAFETY
100
0 25 50 100 150 200
Feet
14-1-71
10-1-70
7-1-70
4-1-70
4-1-70
1-1-70
N5° 51'E
S84° 12'E
752.34
1-1-73
MAIN A
A-17
1885.29
M.D. KITTELL
JERVIS (Surf)
12-1-72
10-1-72
7-1-72
4-1-72
1-1-72
A-18
A-19
A-20
A-21
A22
A23
24
A-25
N25000
N24000
N23000
S85° 49'E
664.67
S84° 18'E
921.67
S88° 34'E
844.71
N19° 59'E
N9° 03'E
1-1-71
4-1-71