


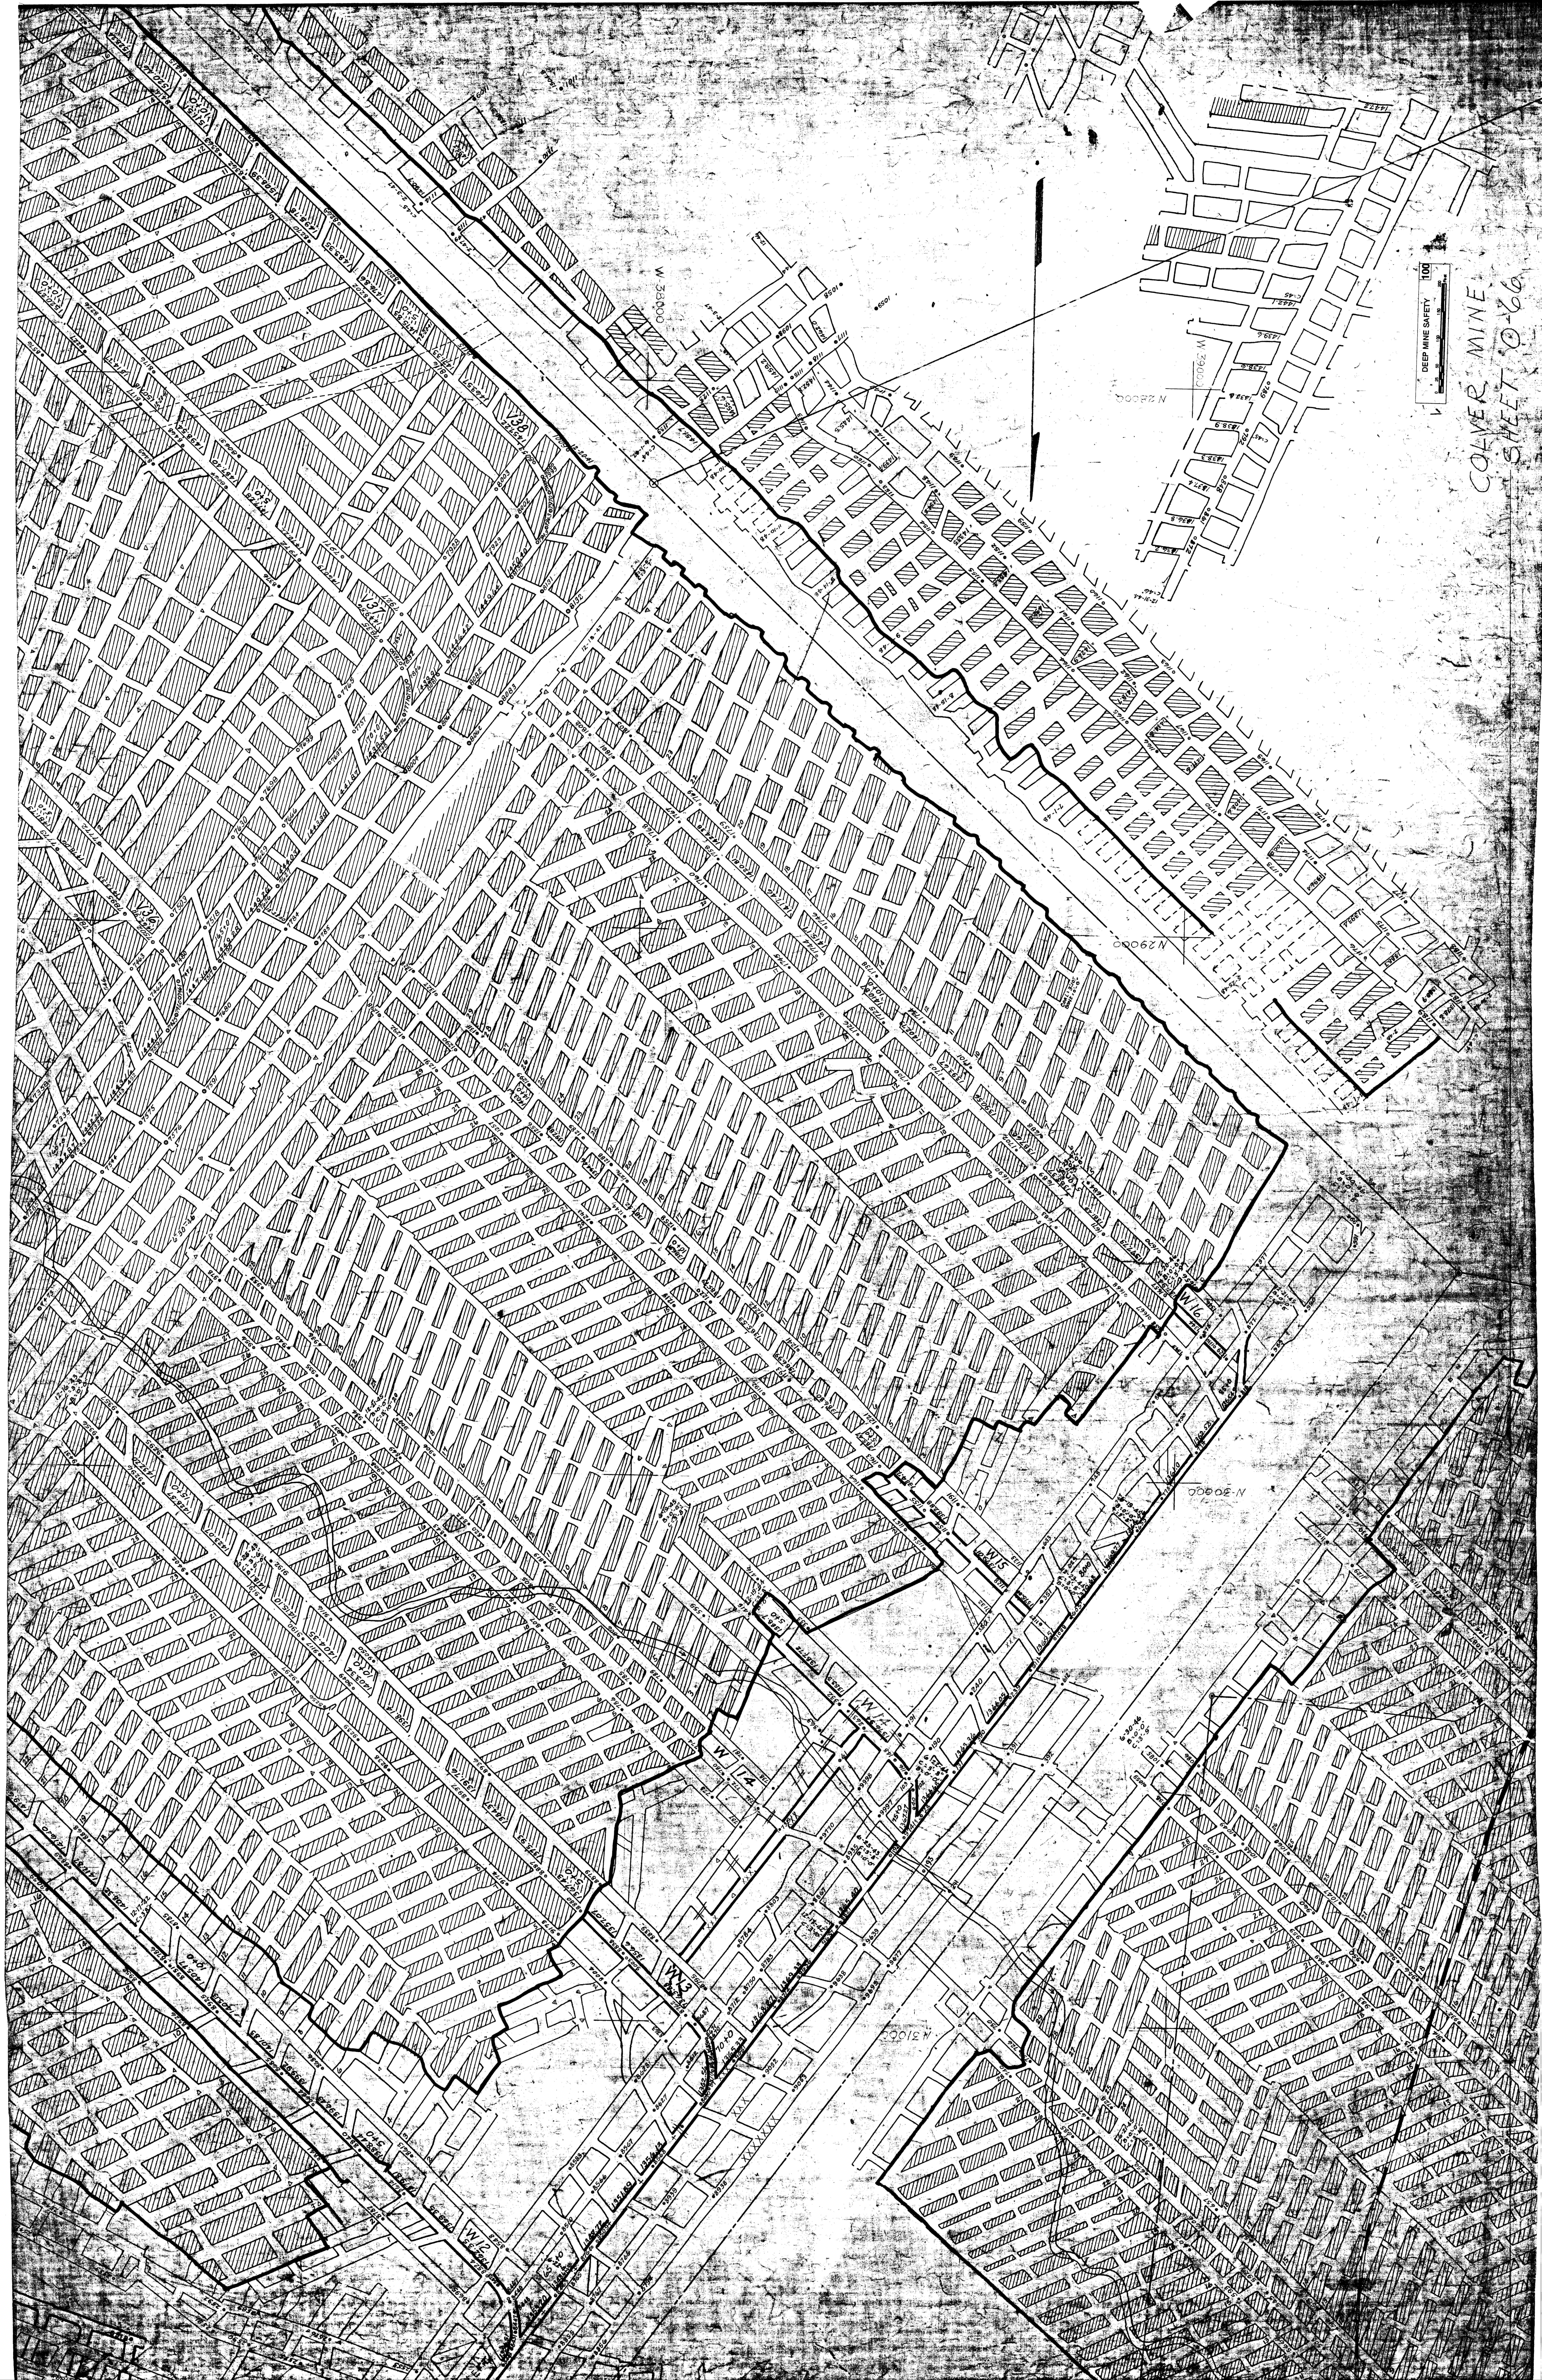

DEEP MINE SAFETY 100

COLVER MINE
SHEET 0-66