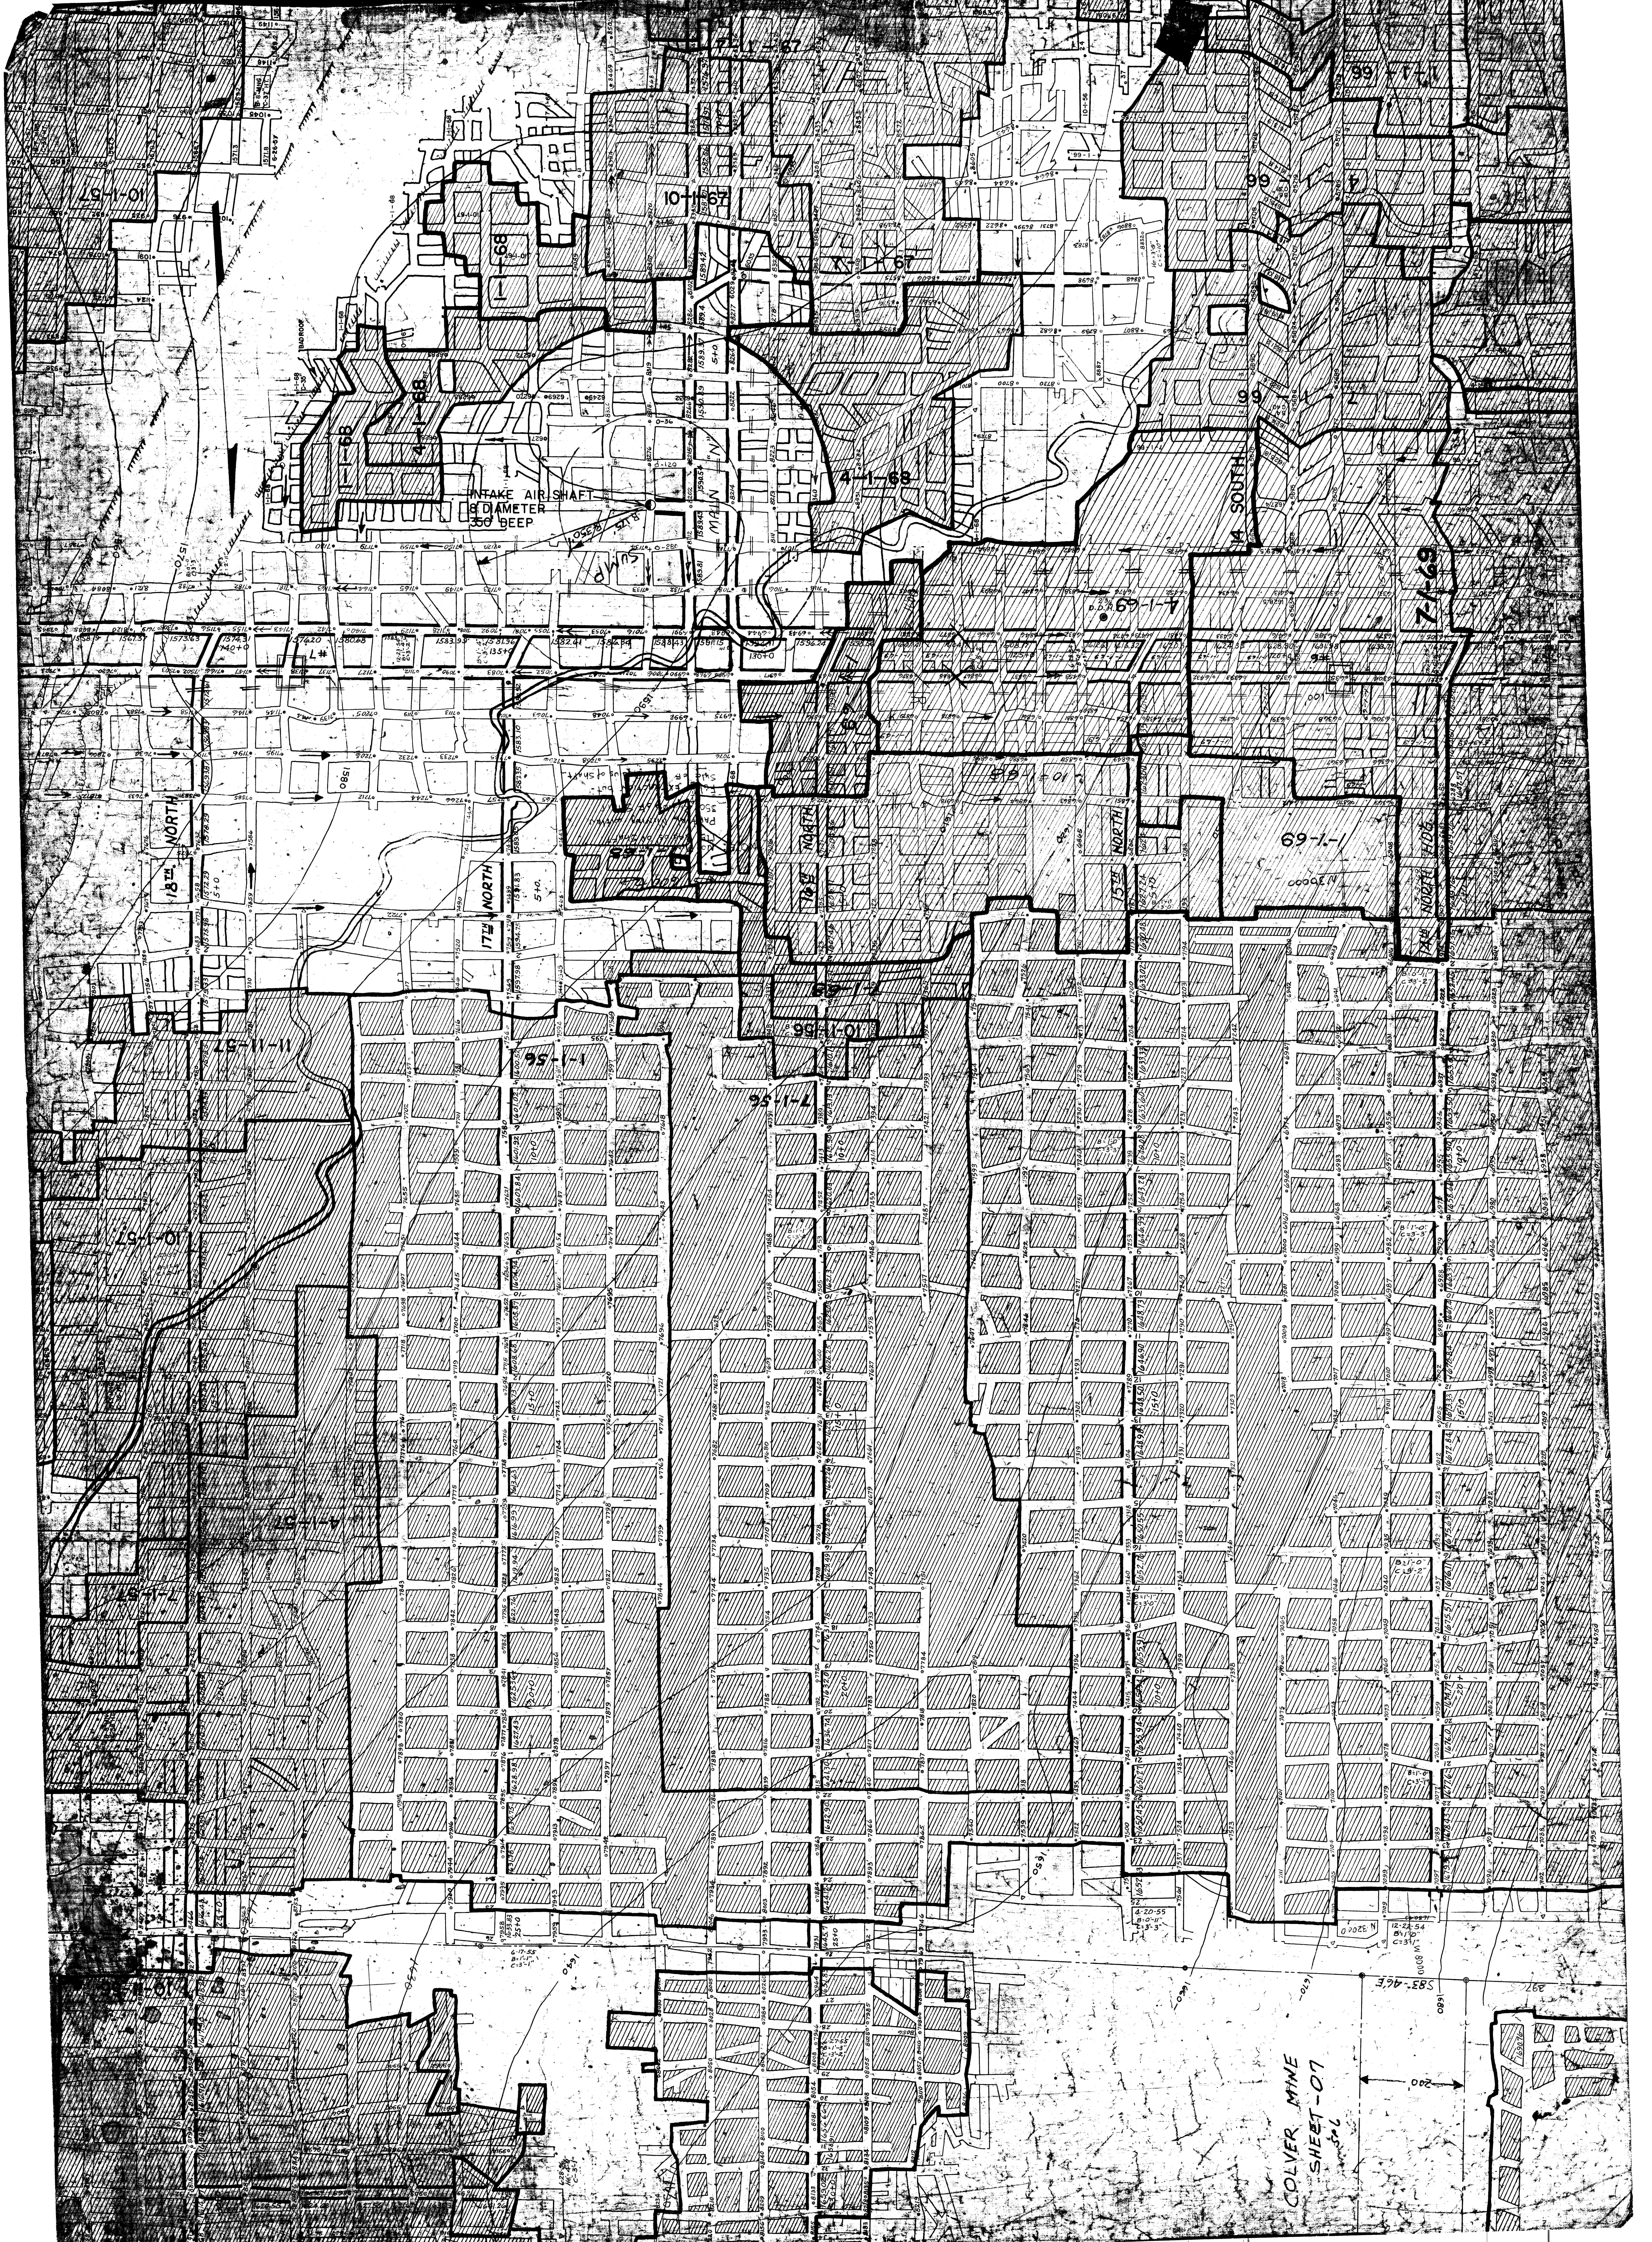
COLVER MINE
SHEET-07
INTAKE AIR SHAFT
8' DIAMETER
350' DEEP
SUMP
MAIN "N"
BAD ROOF
10-1-57
10-1-67
7-1-67
1-1-68
4-1-68
4-1-68
4-1-68
1-1-66
4-1-66
7-1-66
4-1-69
7-1-69
10-1-68
1-1-69
10-1-56
7-1-56
1-1-56
11-11-57
10-1-57
4-1-57
7-1-57
10-1-56
18th NORTH
17th NORTH
16th NORTH
15th NORTH
14th NORTH
14 SOUTH
#7
#6
1570
1580
1590
1650
1660
1670
1680
1640
6-17-55
4-20-55
12-22-54
N 32000
W 8000
S 83°-46' E
200'
5+0
10+0
15+0
20+0
25+0
30+0
130+0
135+0
140+0